

S/3 Argyle

Received at

Office.

189

Lloyd's Register of British and Foreign Shipping.

(Report on Vessel No. *14668* Port *Glasgow.*)

No. *6798* SHIP FORGINGS OR CASTINGS.

I have to report that the undermentioned Iron or Steel Forgings or Castings, manufactured by *The Irvine Forge Coy* of *Irvine* for the Vessel No. *259*, being built by *McKen A & J Inglis* of *Glasgow* have been inspected by me as set forth below, and found to be, so far as can be seen, *Sound & efficient*

The words FORGINGS or CASTINGS, IRON or STEEL, should be struck out as may be required.


Mark on Forgings.

Lloyd's
No. *6797*
F.9

William Hamilton
Frank Co R. Glasgow 24/4/99


	STERN FRAME.	RUDDER FRAME.	STEM.
Material* ...	<i>Scrap iron</i>		<i>Scrap iron</i>
How made ...	<i>Forged</i>		<i>Forged</i>
Dimensions ...	<i>6 1/2 x 4 3/2</i>		<i>6 1/2 x 1 3/4</i>
Progress on Inspection	<i>Forging & smithing</i>		<i>Forging</i>
Date when Inspected	<i>21/2/99 to 20/4/99</i>		<i>21/4/99</i>

SKETCHES OF FRAMES SHOWING POSITION AND DESCRIPTION OF WELDS OF FORGINGS, OR PARTICULARS OF TESTS APPLIED TO CASTINGS.

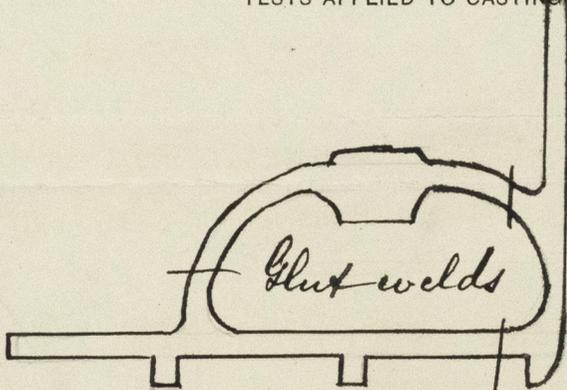

Fee (if any chargeable) £ : :

To be paid at

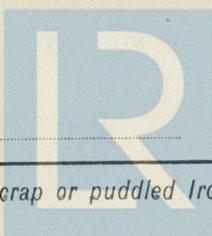

© 2019

Lloyd's Register
Foundation