

5/5 Argyle

Received at

Office.

189

Lloyd's Register of British and Foreign Shipping.

(Report on Vessel No. 17668 Port Glasgow)

No. 6798 SHIP FORGINGS OR CASTINGS.

I have to report that the undermentioned Iron or Steel Forgings or Castings, manufactured by The Irvine Forge Coy of Irvine for the Vessel No. 259, being built by Messrs A & J Inglis of Glasgow have been inspected by me as set forth below, and found to be, so far as can be seen, Sound & efficient

The words FORGINGS or CASTINGS, IRON or STEEL, should be struck out if not required.


Mark on Forgings.

Lloyd's No. 6798 W.H

William Hamilton Glasgow

Table with 3 columns: STERN FRAME, RUDDER FRAME, STEM. Rows include Material*, How made, Dimensions, Progress on Inspection, and Date when Inspected.

SKETCHES OF FRAMES SHOWING POSITION AND DESCRIPTION OF WELDS OF FORGINGS, OR PARTICULARS OF TESTS APPLIED TO CASTINGS.

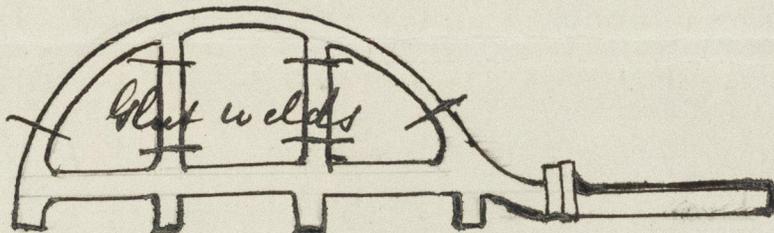

Fee (if any chargeable) £

To be paid at



© 2019

Lloyd's Register Foundation