


Nº-240

s.s. langamian

Lys Rpt No 17686.

GLS285-0124

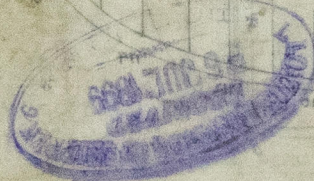

© 2019


Lloyd's Register  
Foundation



7-4-99

A. THOMSON  
ENGINEERS  
17.V.99  
LONDON

PLAN SHOWING AMENDED ARRANGEMENT  
OF STONG BEAMS & W.T. FLOORS No 240  
SCALE 1/8" = 1 FOOT

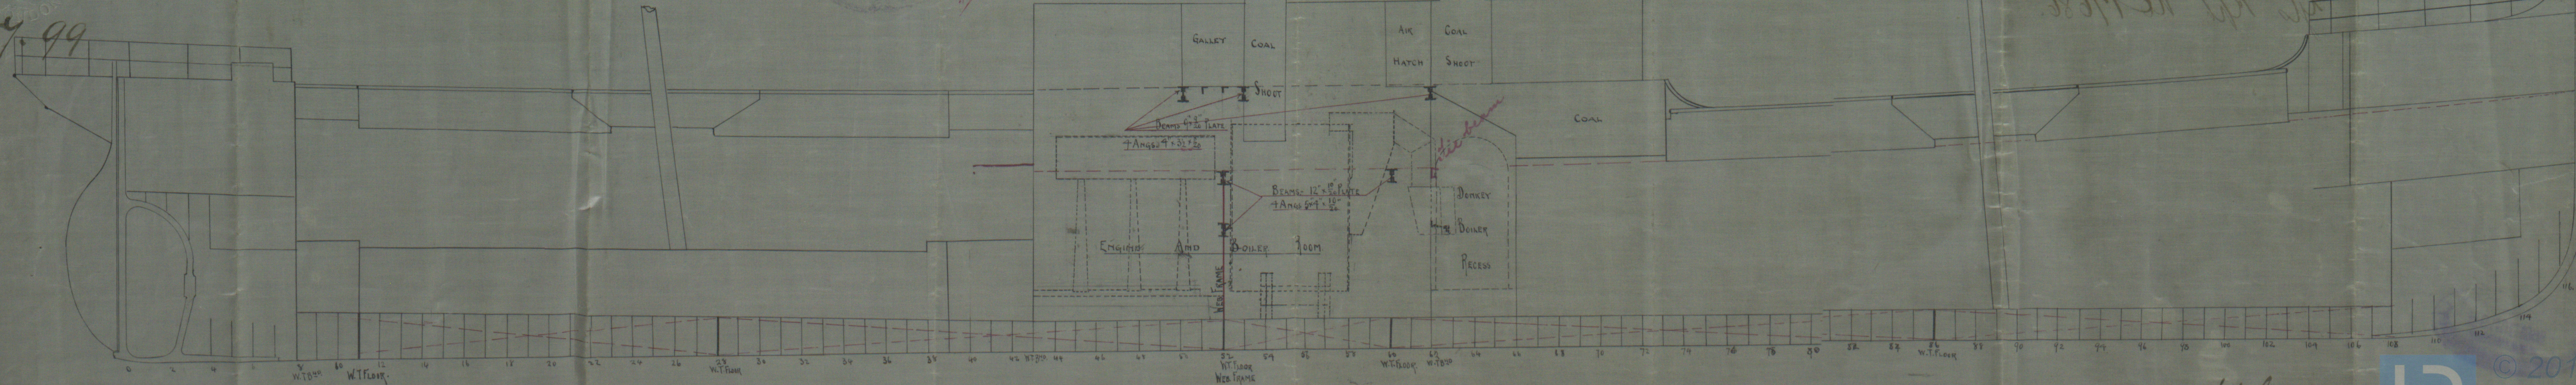

managers  
38 1/2 1/2 1/2 1/2

J.H.  
7/7/99