

2/10/1913
1/11/1913
1/11/1913
Mackie & Thomsen
to Mo.

ss. Langanian
Gls Rpt No. 17686.





GLS285-0125




© 2019

Lloyd's Register
Foundation

Mr
6: 4: 99

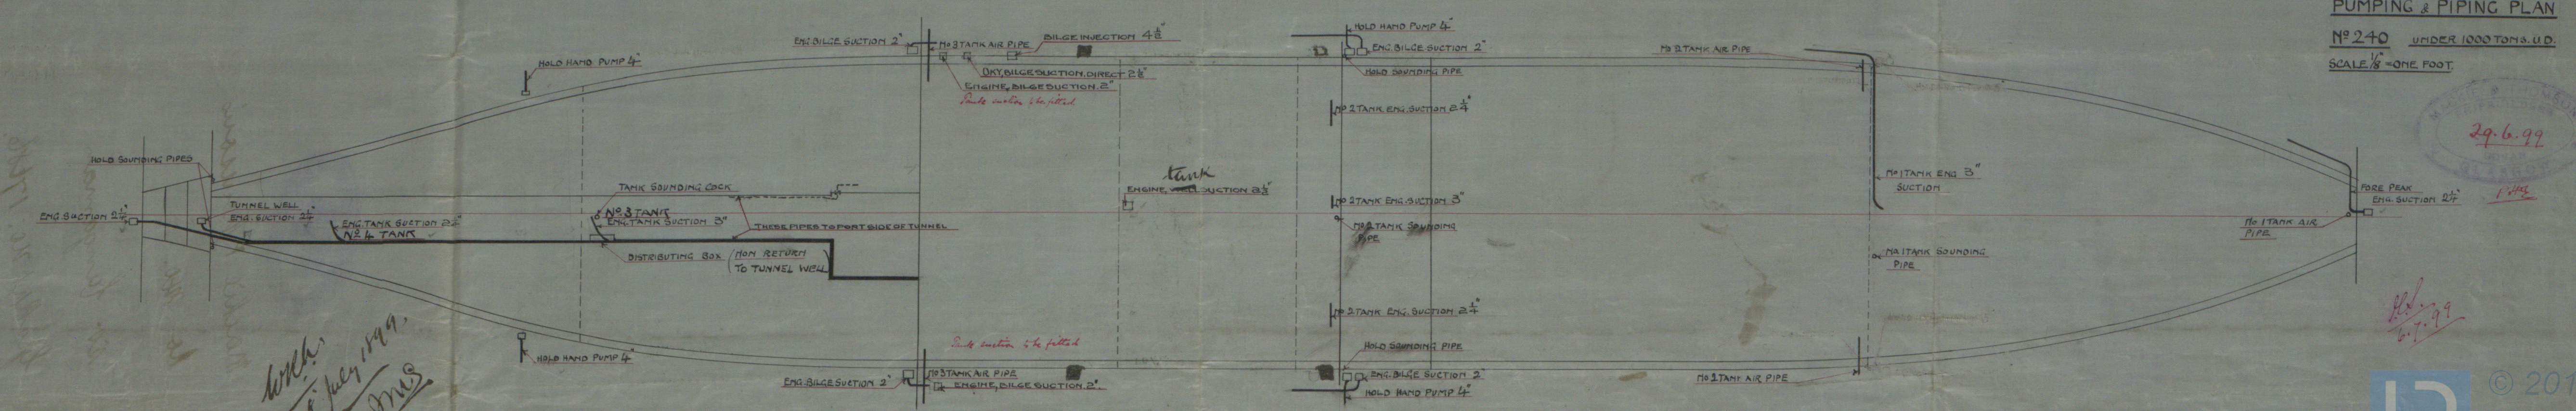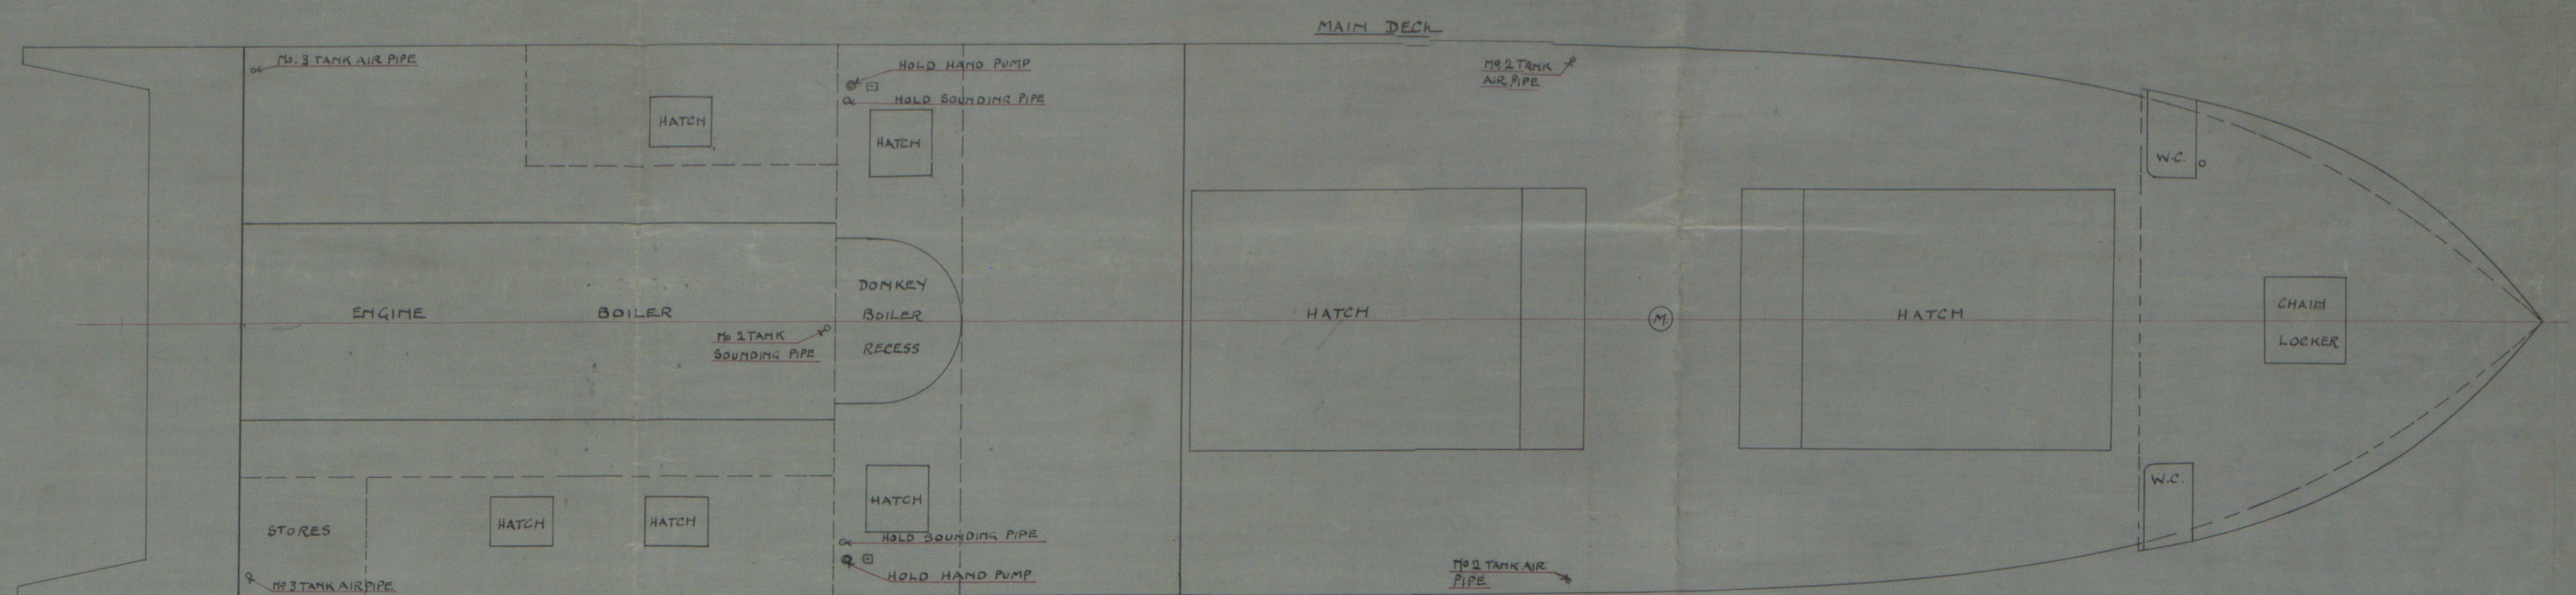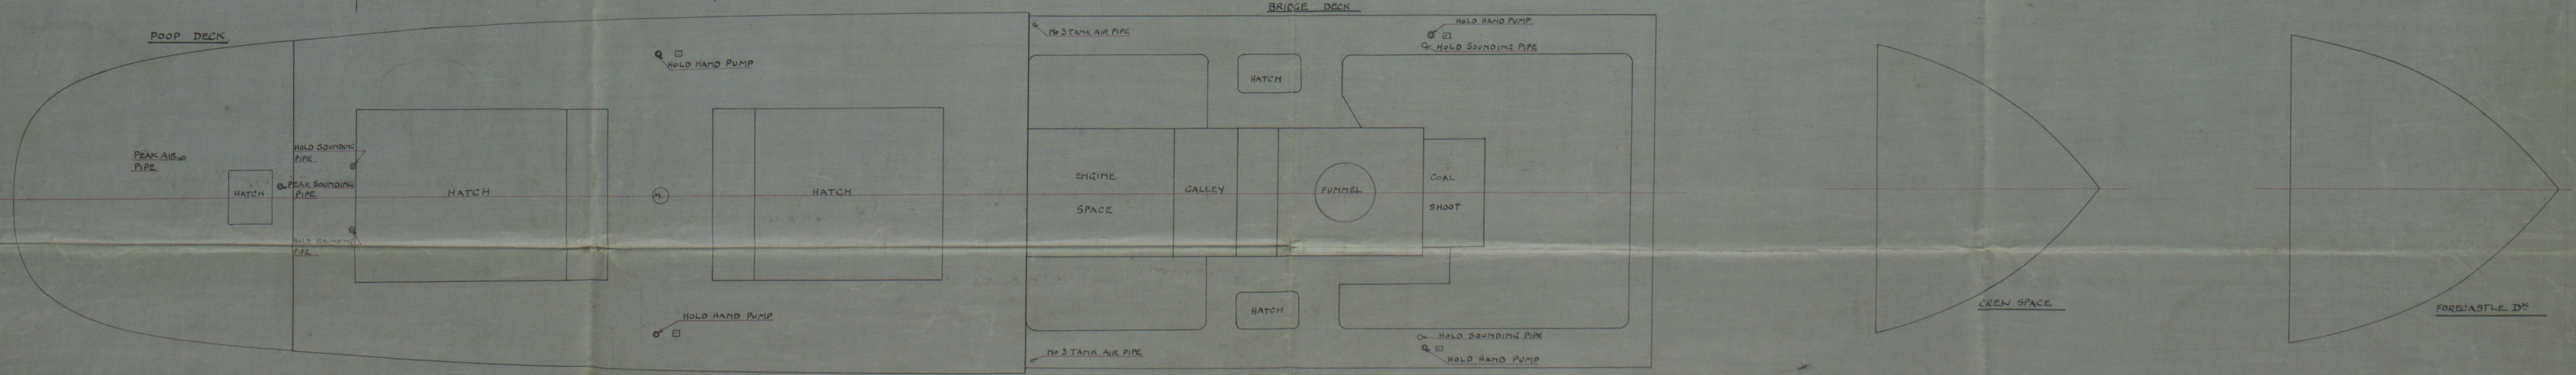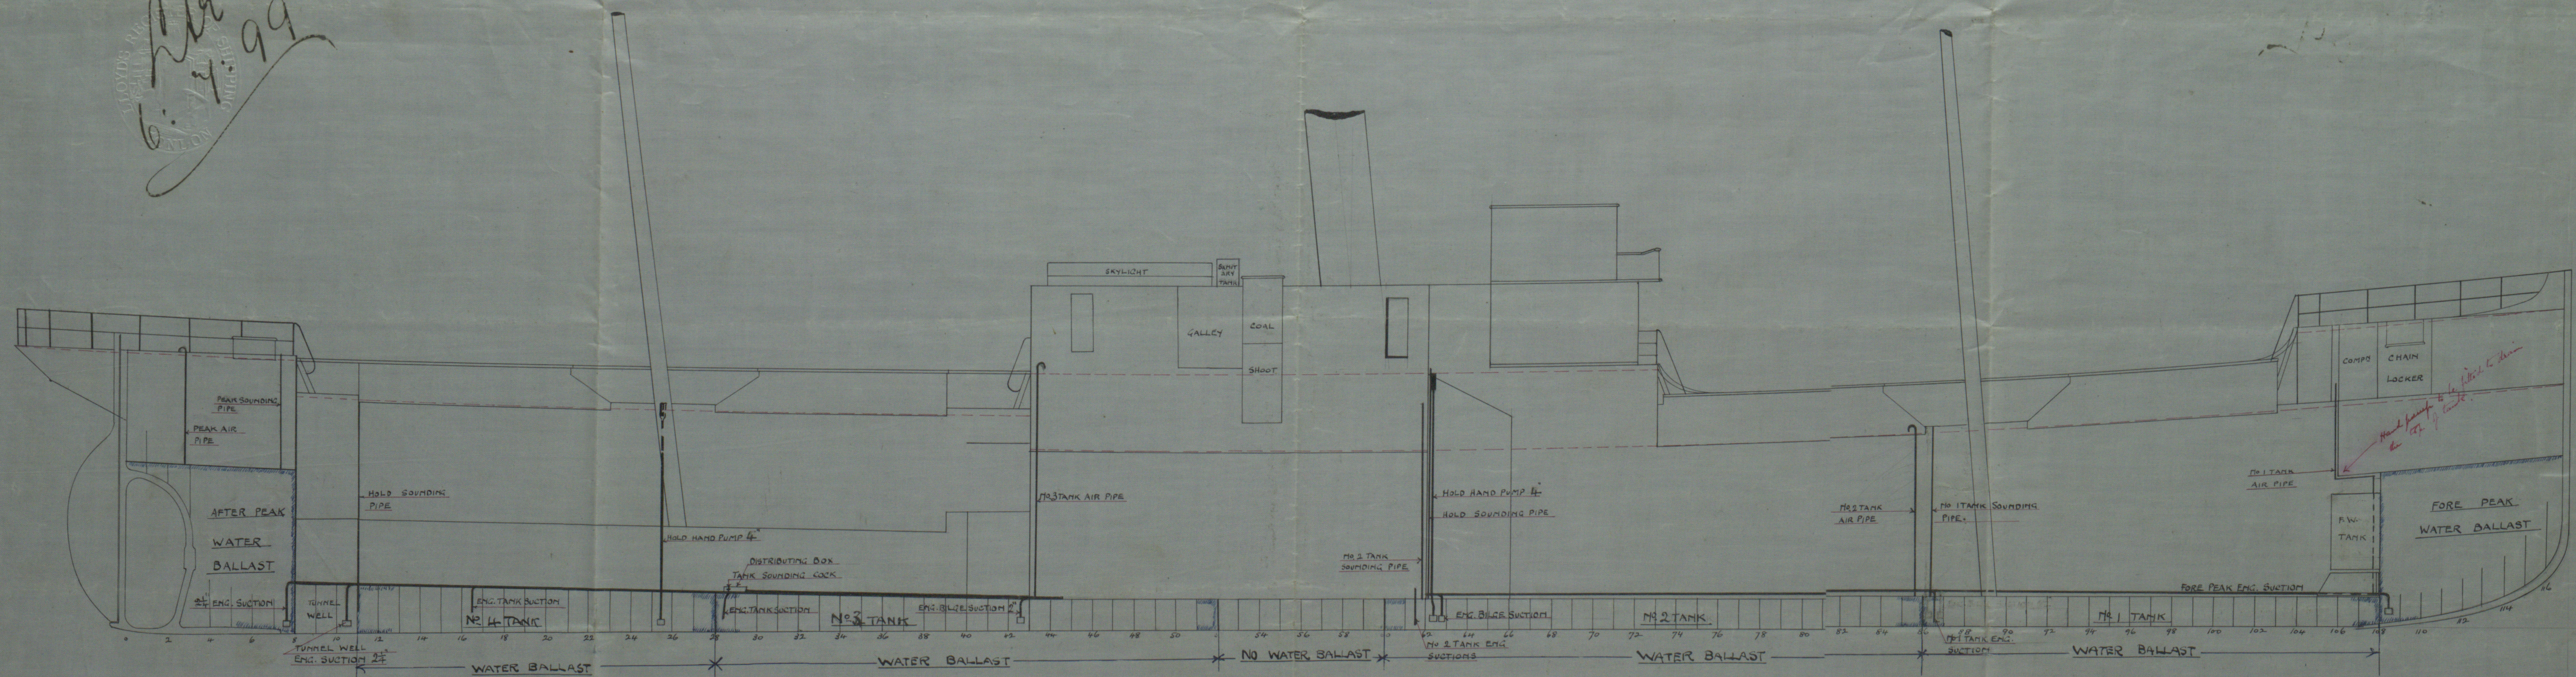

PUMPING & PIPING PLAN
No 240 UNDER 1000 TONS. U.D.
SCALE 1/8" = ONE FOOT.

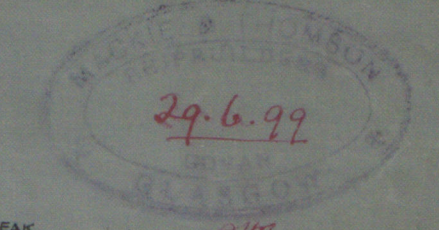

Mr
5: 4: 99