

S.S. Langman

Received at _____ Office _____ 189

Lloyd's Register of British and Foreign Shipping.

(Report on Vessel No. 17686 Port Gls.)

No. 6997 SHIP FORGINGS OR CASTINGS.

The words FORGINGS or CASTINGS, IRON or STEEL, should be struck out, as may be required.

I have to report that the undermentioned Iron or Steel Forgings or Castings, manufactured by The Harbour Forge Coy of Irvine for the Vessel No. 240, being built by Mess Mackie & Thomson Glasgow have been inspected by me as set forth below, and found to be, so far as can be seen, Sound & efficient


Mark on Forgings.

Lloyd's No. 6997 W.H.

William Hamilton Glasgow

	STERN FRAME.	RUDDER FRAME.	STEM.
Material*		Scrap iron	
How made		Forged	
Dimensions		5 1/2 to 5 1/2 + 4 3/8	
Progress on Inspection		Forging & smithing	
Date when Inspected		24/10/99 to 6/12/99	

SKETCHES OF FRAMES SHOWING POSITION AND DESCRIPTION OF WELDS OF FORGINGS, OR PARTICULARS OF TESTS APPLIED TO CASTINGS.

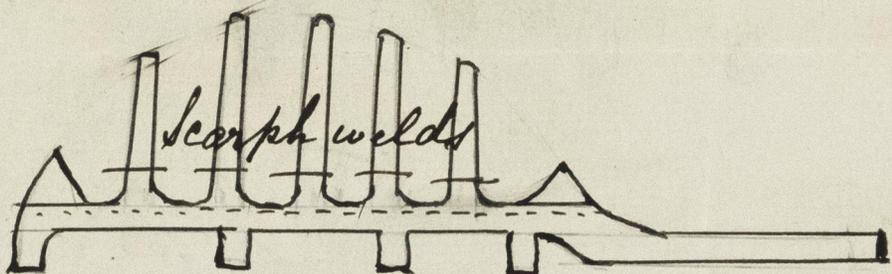

Fee (if any chargeable) £ : :

To be paid at _____



© 2019

Lloyd's Register Foundation