

Mr. 3.10.99


PUMPING ARRANGEMENT PLAN

OF
FERRY STEAMER

N^o 284

Scale $\frac{1}{2}$ = 1 foot.

Under Deck Sumpage under 500 tons

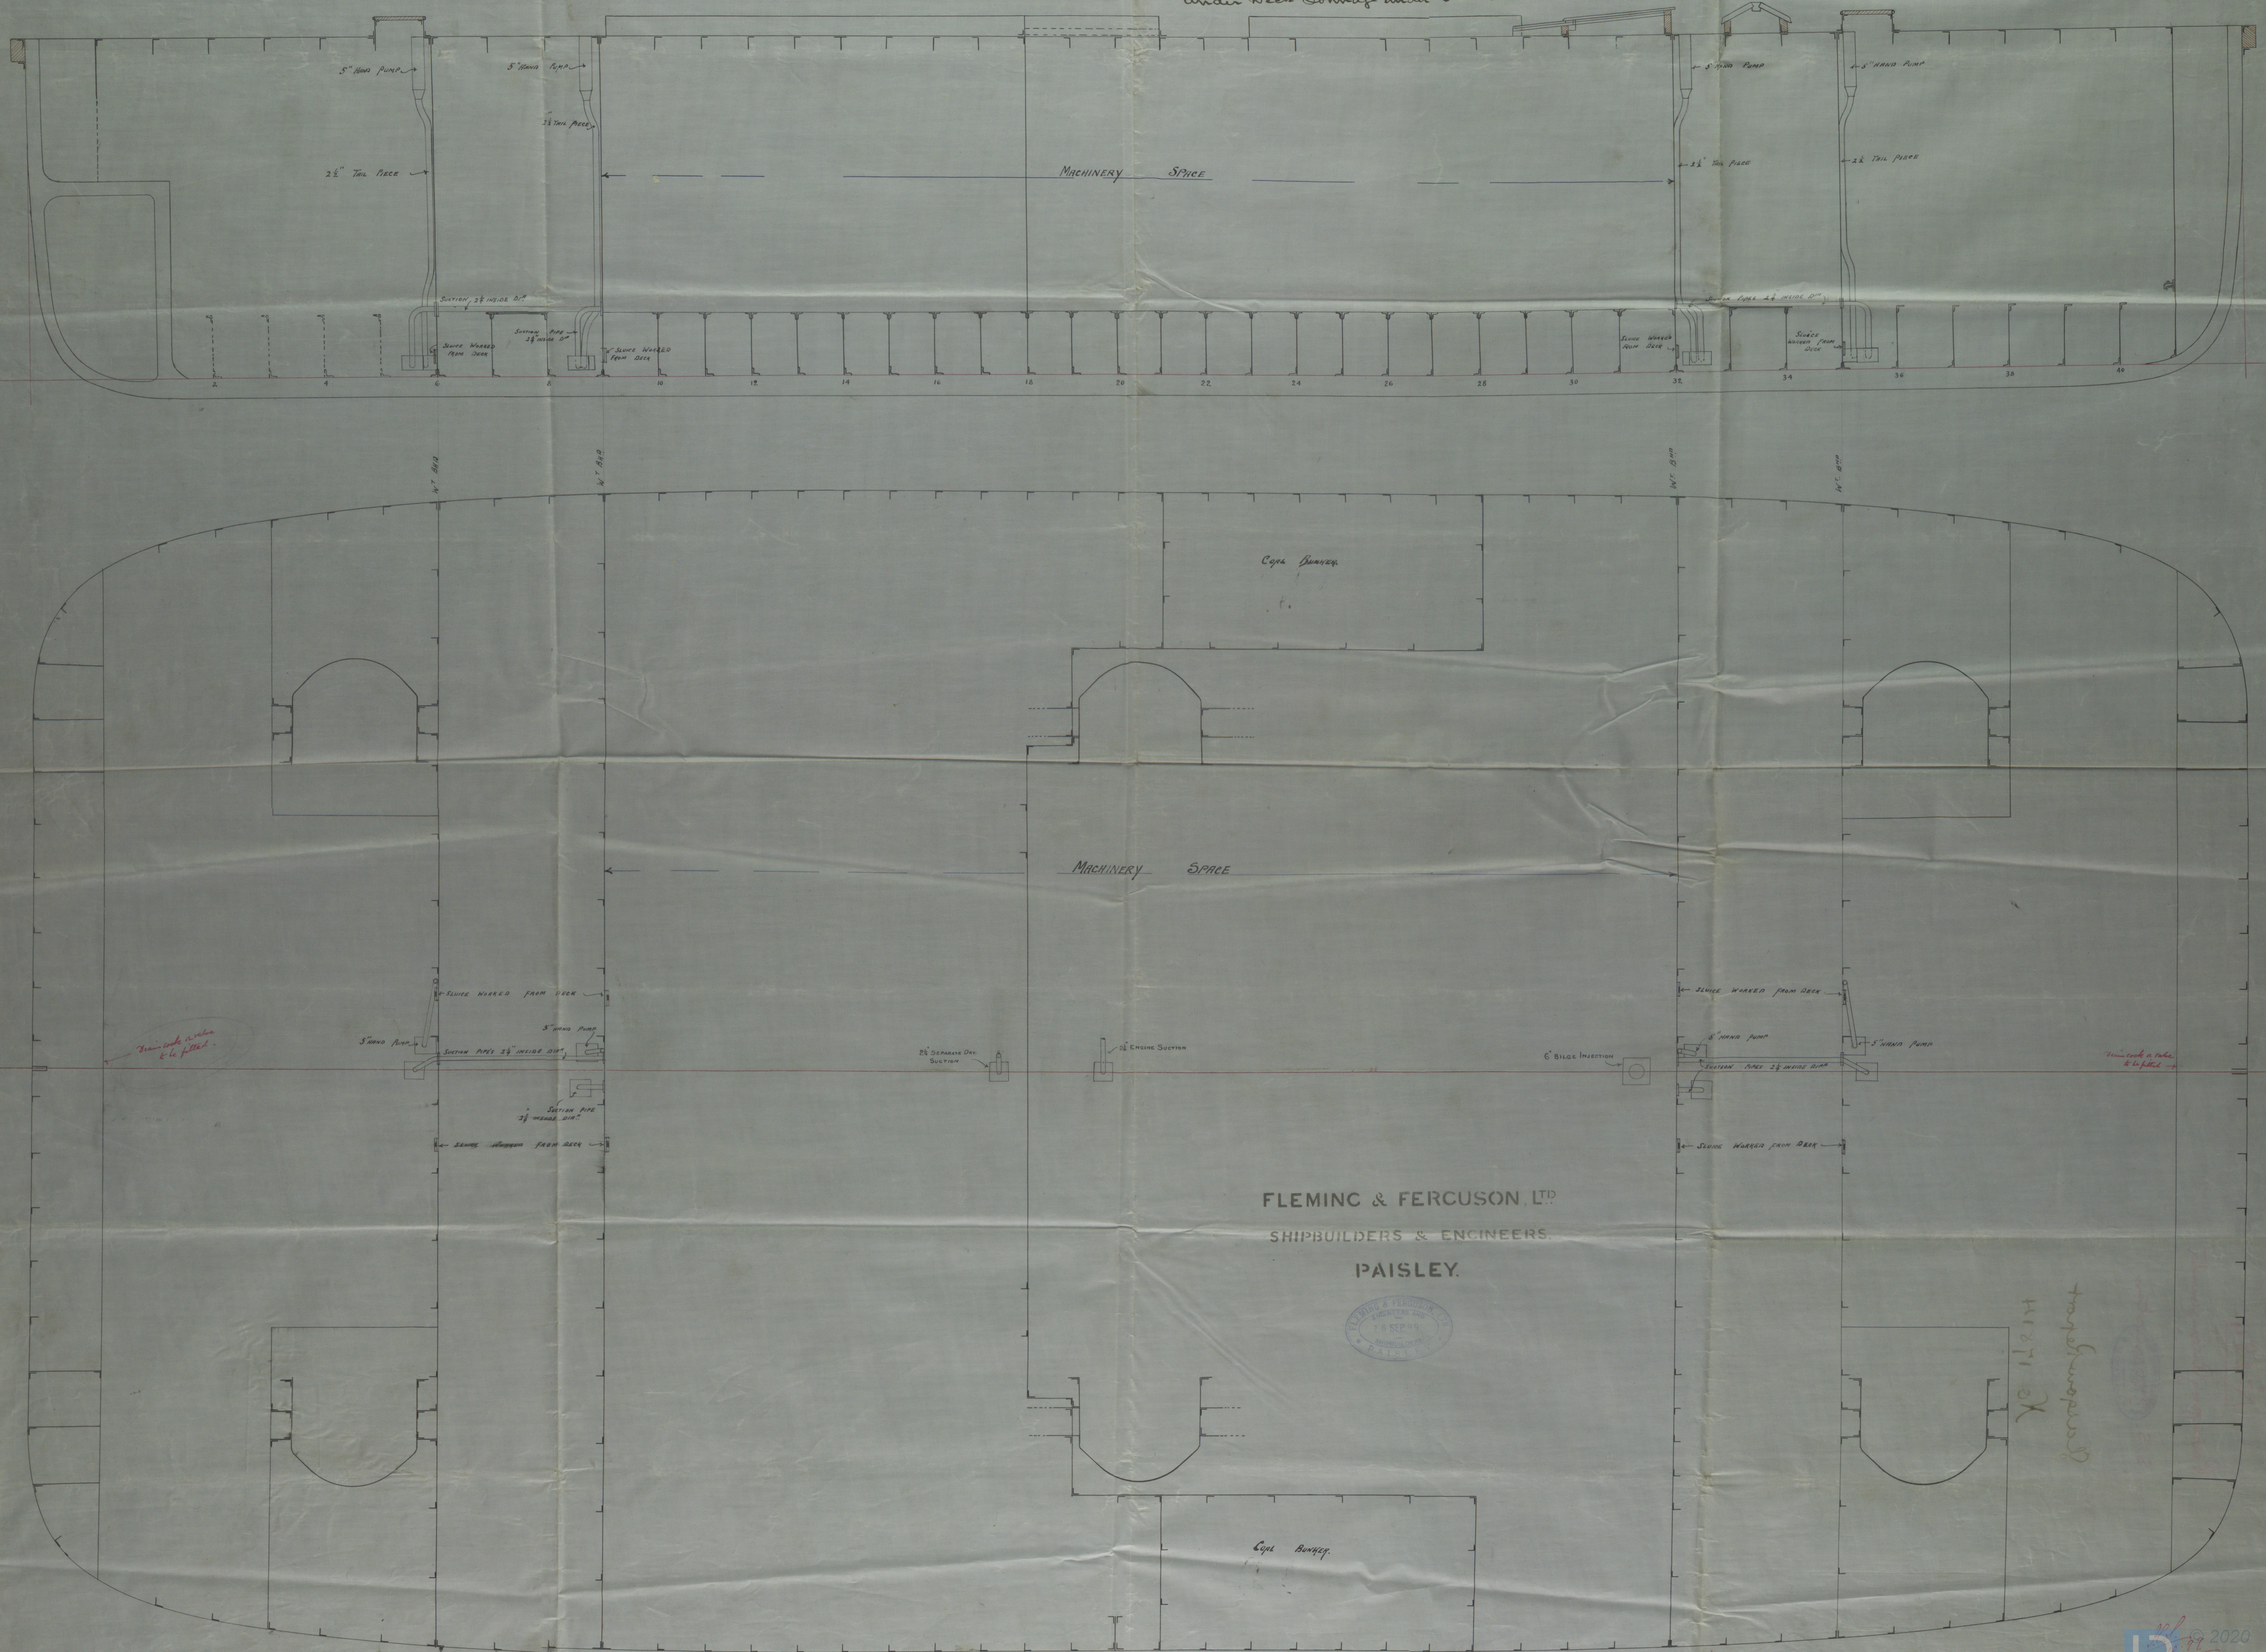

FLEMING & FERCUSON, LTD.

SHIPBUILDERS & ENGINEERS.

PAISLEY.




Heident
Kontrollat

Flaming & Ferguson

No 284.

Pumping Arrangements.

S.S. Finnieston.

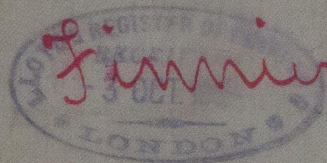

Glasgow Report

No 17814

GL256-0105



© 2020

Lloyd's Register
Foundation