


STEEL SCREW STEAMER

N 385

Amended profile

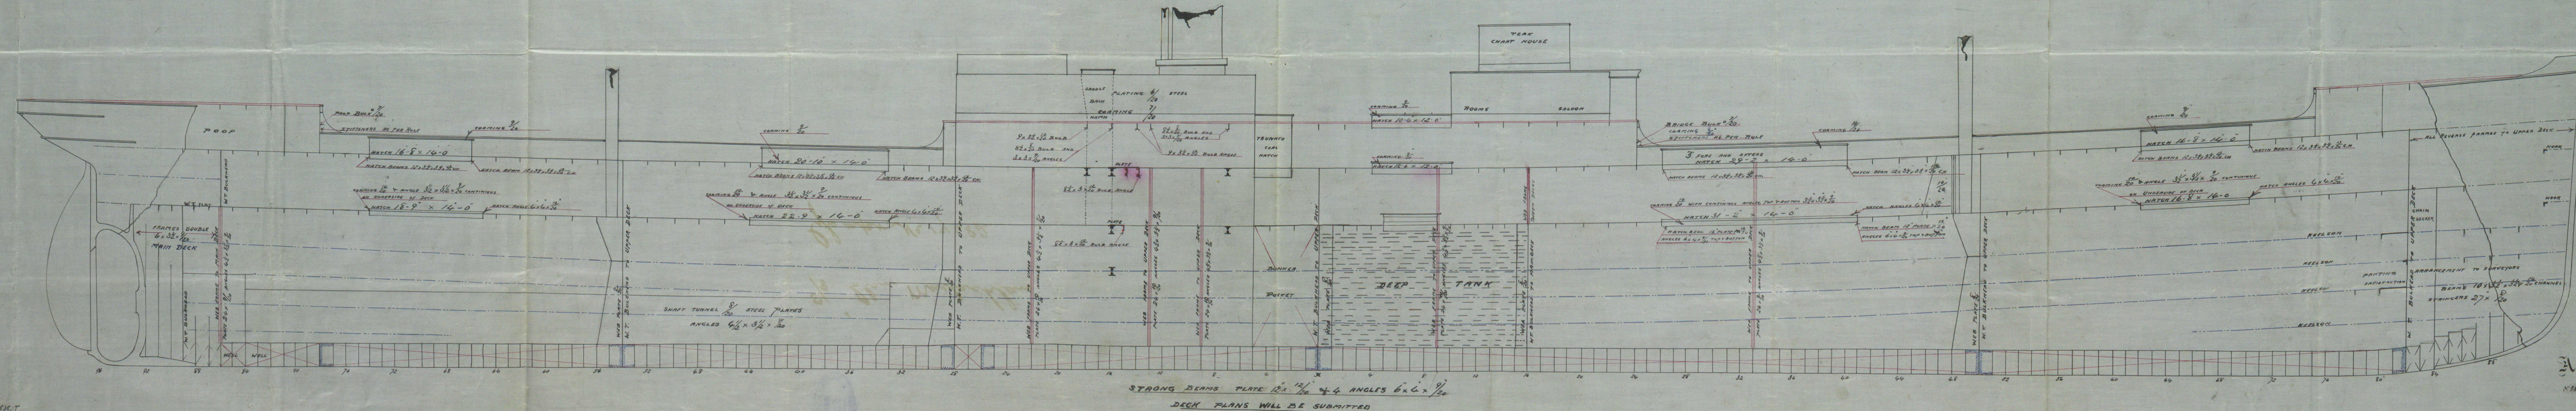


Alex. Stephen & Sons
SHIPBUILDERS & ENGINEERS
GLASGOW

DRAWING NO 252

28/3/1900



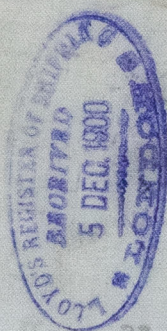

5/8 plan MacLachlan

Glasgow No 14682.

615287-0003



© 2019

Lloyd's Register
Foundation