

5/5 b lam MacLachlan

Rpt. 6.

For the information of Surveyors and the Committee only.

Received at

Office.

189

# Lloyd's Register of British and Foreign Shipping.

(Report on Vessel No. 17862 Port Glasgow)

## No. 7050 SHIP FORGINGS OR CASTINGS.

I have to report that the undermentioned Iron or Steel Forgings or Castings, manufactured by Messrs Alex<sup>r</sup> Stephen & Sons of Glasgow for the Vessel No. 385, being built by them of

have been inspected by me as set forth below, and found to be, so far as can be seen, *Sound & efficient*

The words FORGINGS or CASTINGS, IRON or STEEL, should be struck out as may be required.


Mark on Forgings.

Lloyd's  
No. 7050  
W.H.

William Hamilton  
Glasgow

	STERN FRAME.	RUDDER FRAME.	STEM.
Material*	Scrap iron		Scrap iron
How made	Forged		Forged
Dimensions	11 x 7 1/2		11 x 3 1/2
Progress on Inspection	Forging & smithing		Forging
Date when Inspected	31/1/99 to 3/8/99		6/4/99 to 5/5/99

SKETCHES OF FRAMES SHOWING POSITION AND DESCRIPTION OF WELDS OF FORGINGS, OR PARTICULARS OF TESTS APPLIED TO CASTINGS.

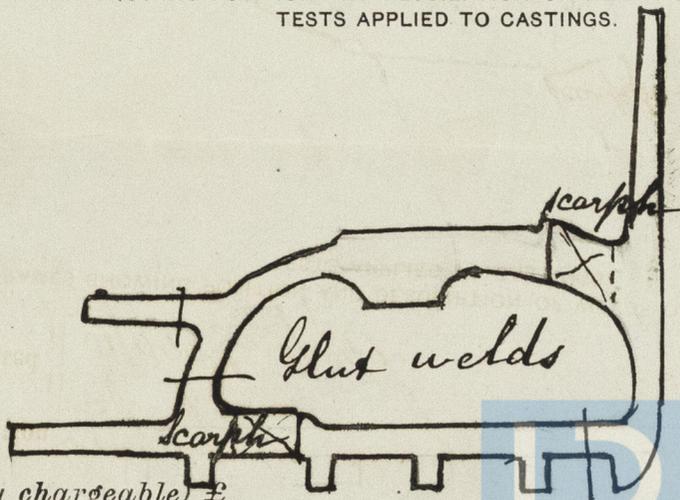

Fee (if any chargeable) £

To be paid at

© 2019

Lloyd's Register  
Foundation