


H. Clan Maclellan
 Gl. 17862.

65287-0006


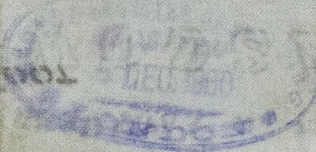


















© 2019

Lloyd's Register
 Foundation


STEEL MASTS. N° 385.

MASTS HAVE NO RAKE.

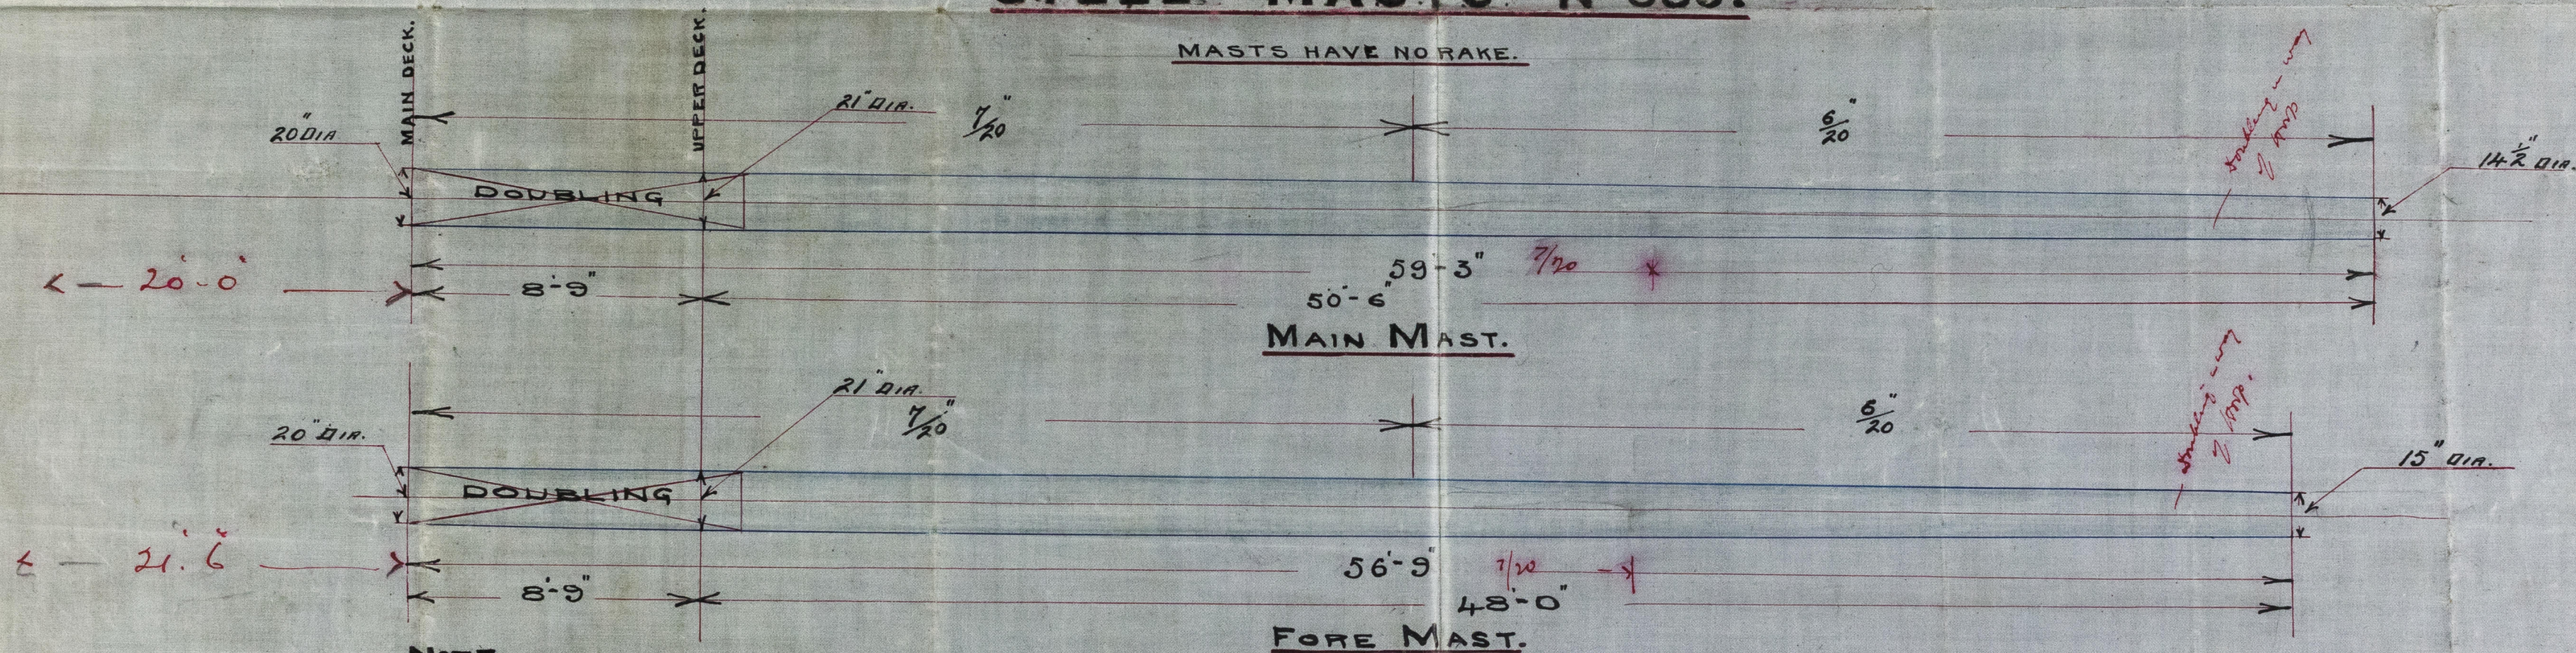

NOTE. TWO PLATES IN ROUND EDGES SINGLE RIV.

BUTT STRAPS TREBLE RIV. 2" THICKER THAN PLATES.

SCALE 1/4" INCH TO 1 FOOT

DRAWING N° 9619.

Alex. Stephen & Sons.

SHIPBUILDERS & ENGINEERS

GLASGOW

21. 4. 99.

Warren
26/4/99



© 2019

Lloyd's Register
Foundation

GLS287-0006