9.3.99

DEEP TANK

No. 385

Alex.r Stephen & Sons.
SHIPBUILDERS & ENGINEERS
GLASGOW

DRAWING No. 9520

4/3/99

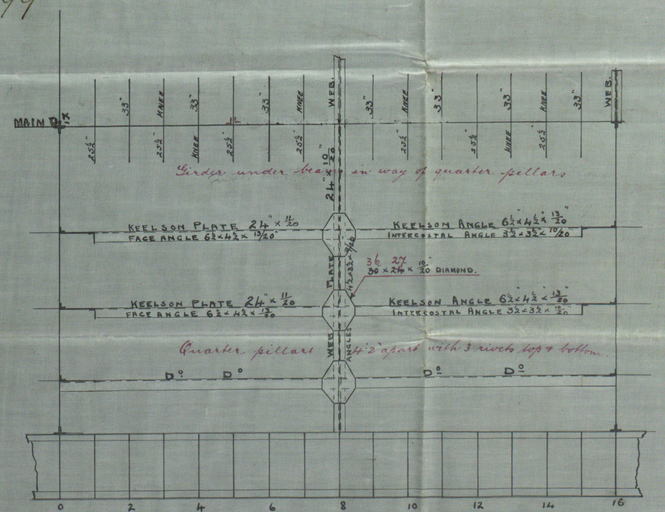

ELEVATION AT SIDE.

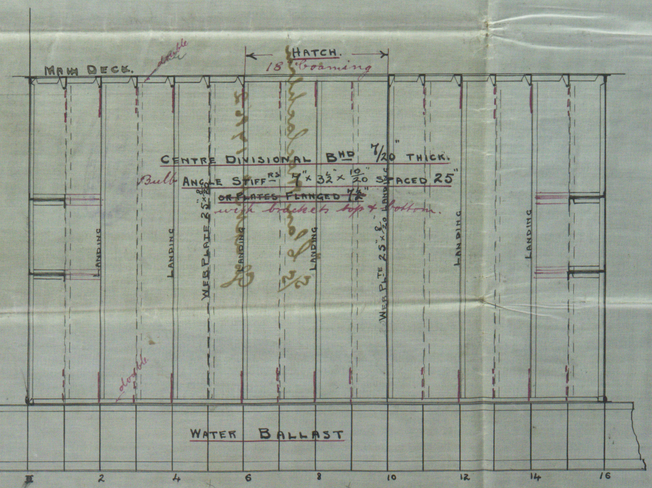

ELEVATION SHOWING CENTRE BULKHEAD.

Scale ¼ inch = 1 Foot.

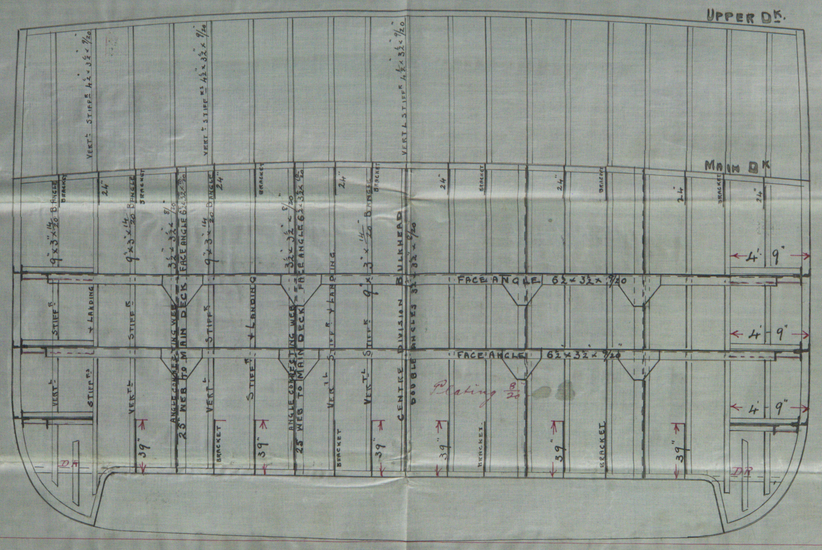

BULKHEAD No. 3C

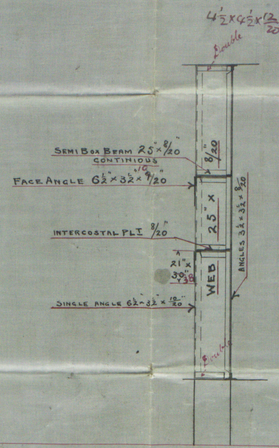

SECTION SHOWING WEB.

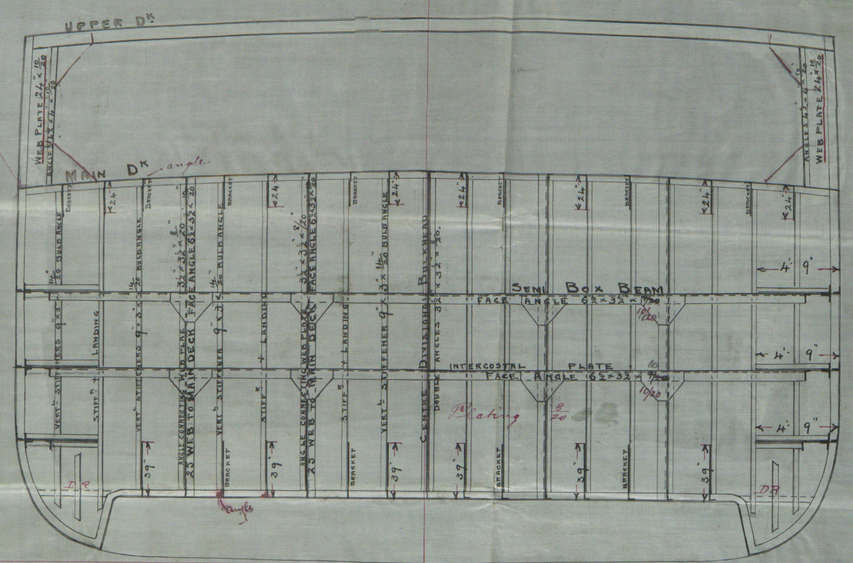

BULKHEAD No. 16.F.B.

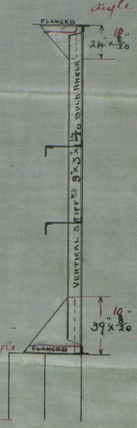

SECTION IN WAY OF STIFF.rs

9/3/99

© 2019 Lloyd's Register Foundation
LLS257-0016

© 2019 Lloyd's Register Foundation