


**N<sup>31</sup> 385**

See amended profile for Size of Hatchways &c

LENGTH BETWEEN PERP <sup>s</sup>	395.0
BREATH EXTREME	48.0
DEPTH MOULDED	30.0

FORWARD END. -- 9. 8.  
1/8 FROM FORW. END. -- 5. 3 3/4  
AFTER END. -- 4. 3.  
1/8 FROM AFT. END. -- 2. 4  
CO. EF. OF TONNAGE. -- .

20.12.98  
21.2.99  
9.3.99

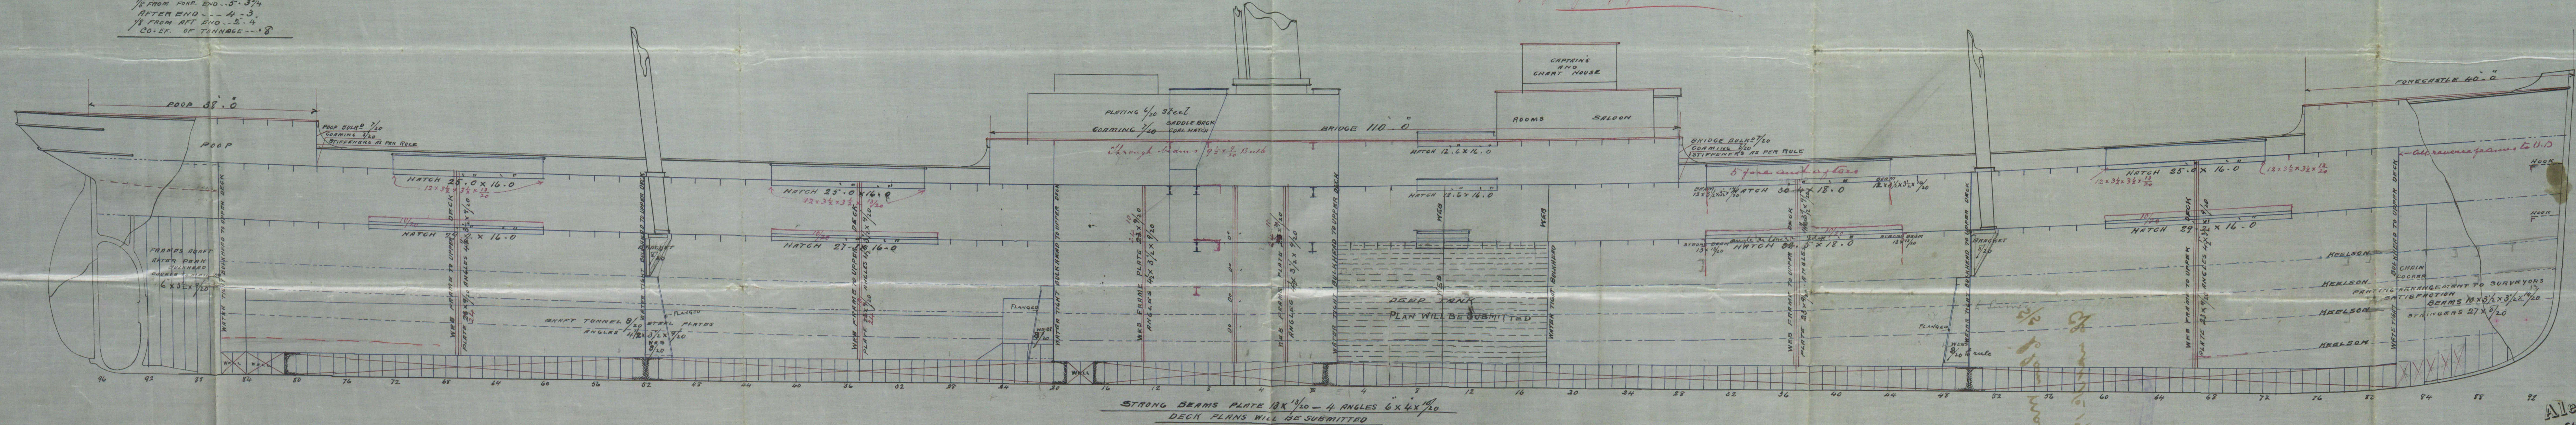

SCALE  $\frac{1}{8}$  INCH TO A FOOT

**Alex. Stephen & Sons**  
**SHIPBUILDERS & ENGINEERS**

GLASGOW.

DRAWING № 9334

34 15/12/98

© 2019  
Lloyd's Re  
Foundatio  
787-0013

© 20  
Lloyd  
Found  
615787-0013




385

GLS 287-0017

S/S Clan MacLachlan

Gls regt No 14862.

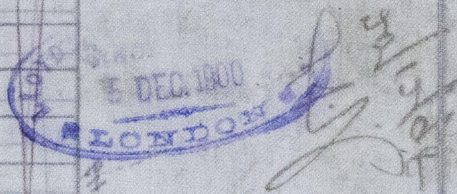

© 2019

Lloyd's Register  
Foundation