

S.S. Cambrian

Rpt. 6.

For the information of Surveyors and the Committee only.

Received at _____ Office. _____ 189.

Lloyd's Register of British and Foreign Shipping.

(Report on Vessel No. 17889 Port Glasgow)

No. 7131 SHIP FORGINGS OR CASTINGS.

I have to report that the undermentioned Iron or Steel Forgings or Castings, manufactured by The Irvine Forge Coy of Irvine for the Vessel No. 258, being built by Messrs Mackie & Thomson of Glasgow have been inspected by me as set forth below, and found to be, so far as can be seen, Sound & efficient

The words FORGINGS or CASTINGS, IRON or STEEL, should be struck out as may be required.


Mark on Forgings.

Lloyd's No. 7131 W.H

William Hamilton Glasgow

Table with 3 columns: STERN FRAME, RUDDER FRAME, STEM. Rows include Material* (Scrap iron), How made (Forged), Dimensions (7 ft 4 1/2), Progress on Inspection (Forging & smithing), and Date when Inspected (30/6/99 to 22/9/99).

SKETCHES OF FRAMES SHOWING POSITION AND DESCRIPTION OF WELDS OF FORGINGS, OR PARTICULARS OF TESTS APPLIED TO CASTINGS.

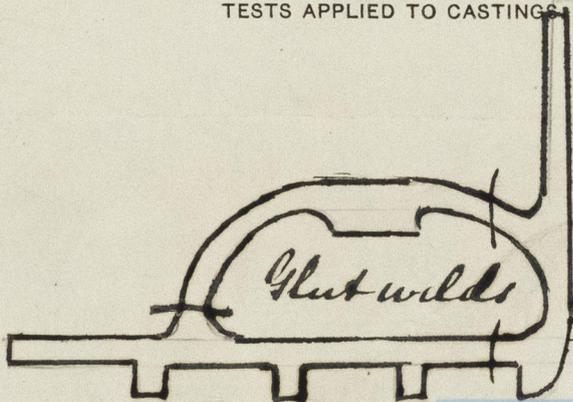

Fee (if any chargeable) £ : :

To be paid at _____

* If of Iron, state whether scrap or puddled Iron.