

S.S. Cambrian

Rpt. 6.

For the information of Surveyors and the Committee only.

Received at _____ Office _____ 190

Lloyd's Register of British and Foreign Shipping.

(Report on Vessel No. 17889 Port Glasgow)

No. 7131 SHIP FORGINGS OR CASTINGS.

The words FORGINGS or CASTINGS, IRON or STEEL, should be struck out as may be required.

I have to report that the undermentioned Iron or Steel Forgings or Castings, manufactured by Messrs The Irvine Forge Coy of Irvine for the vessel No. 258, being built by Messrs Mackie & Thomson of Glasgow have been inspected by me as set forth below, and found to be, so far as can be seen, Sound & efficient


Mark on Forgings.

Lloyd's No. 7131 WH

William Hamilton Glasgow

	STERN FRAME.	RUDDER FRAME.	STEM.
Material*		Scrap iron	
How made		Forged	
Dimensions		15 to 13 1/2 + 4 3/4	
Progress on Inspection		Forging & smithing	
Date when Inspected		8/3/00 to 3/4/00	

SKETCHES OF FRAMES SHOWING POSITION AND DESCRIPTION OF WELDS OF FORGINGS, OR PARTICULARS OF TESTS APPLIED TO CASTINGS.

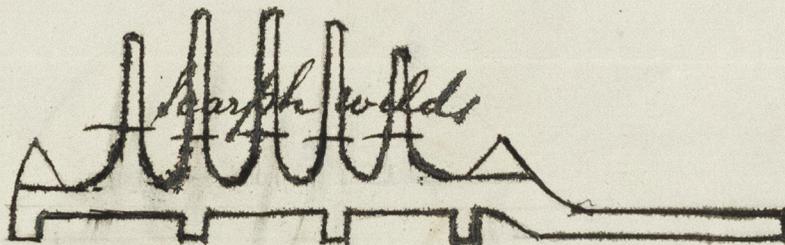

Fee (if any chargeable) £ : :

To be paid at _____



© 2019

Lloyd's Register Foundation