



22.5.99
mod 9 deck & rigging
noirclmo 2.2


22.4.99
23.5.99

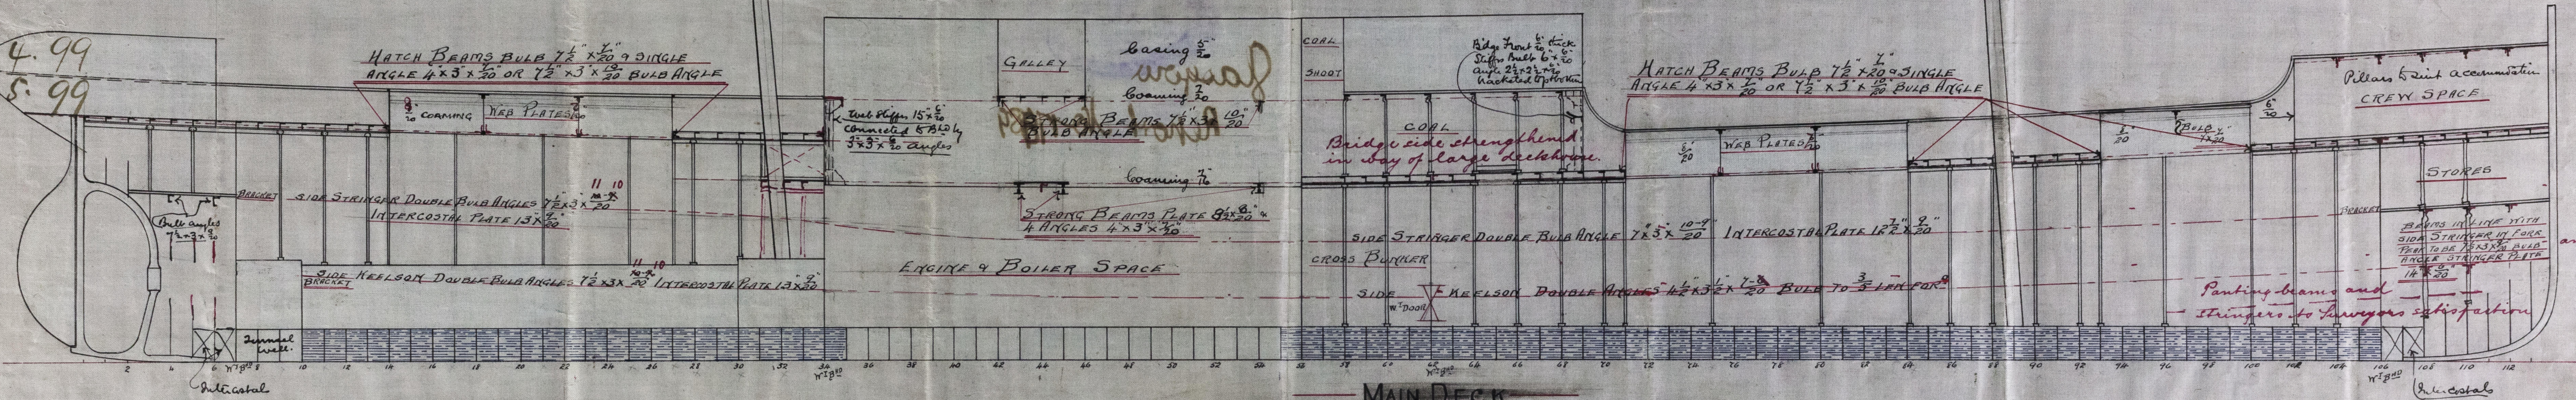


LONGITUDINAL SECTION
AND
DECK PLANS
No 258
SCALE 1/8" = 1 FOOT

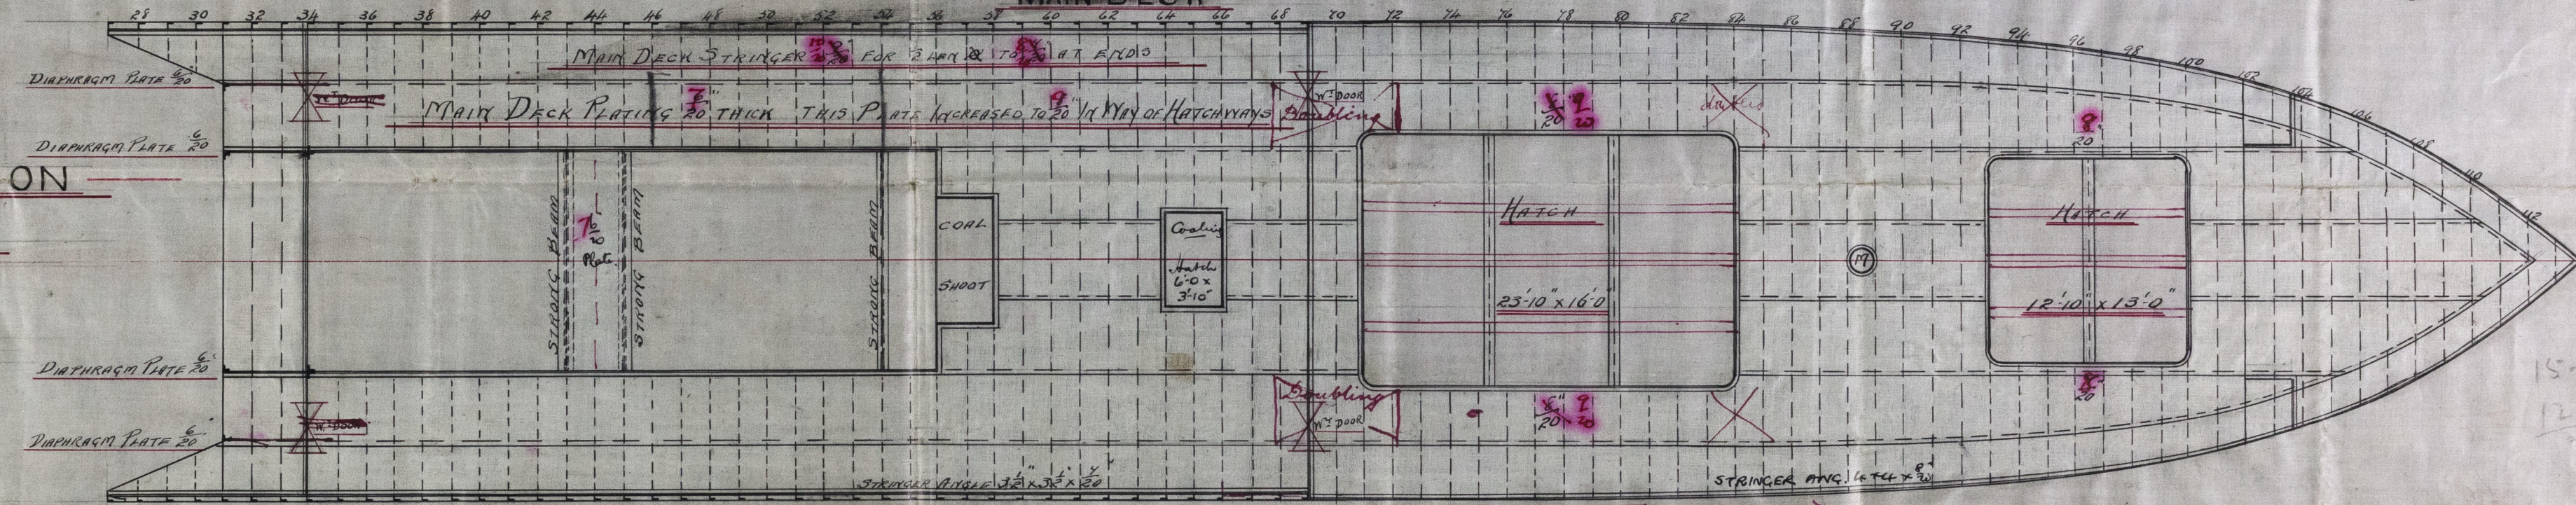


QUARTER DECK

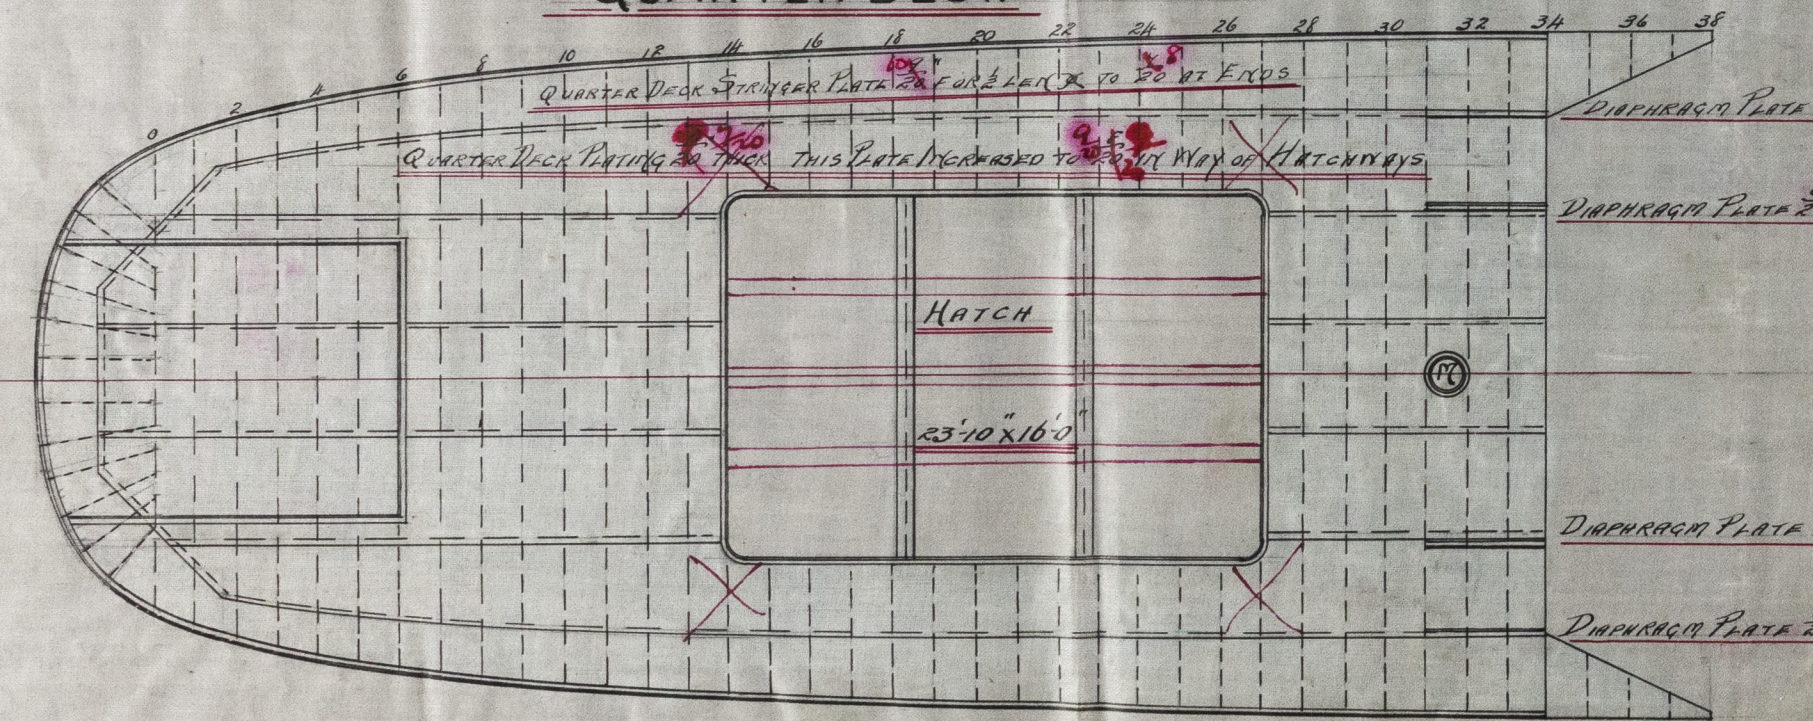

BRIDGE DECK

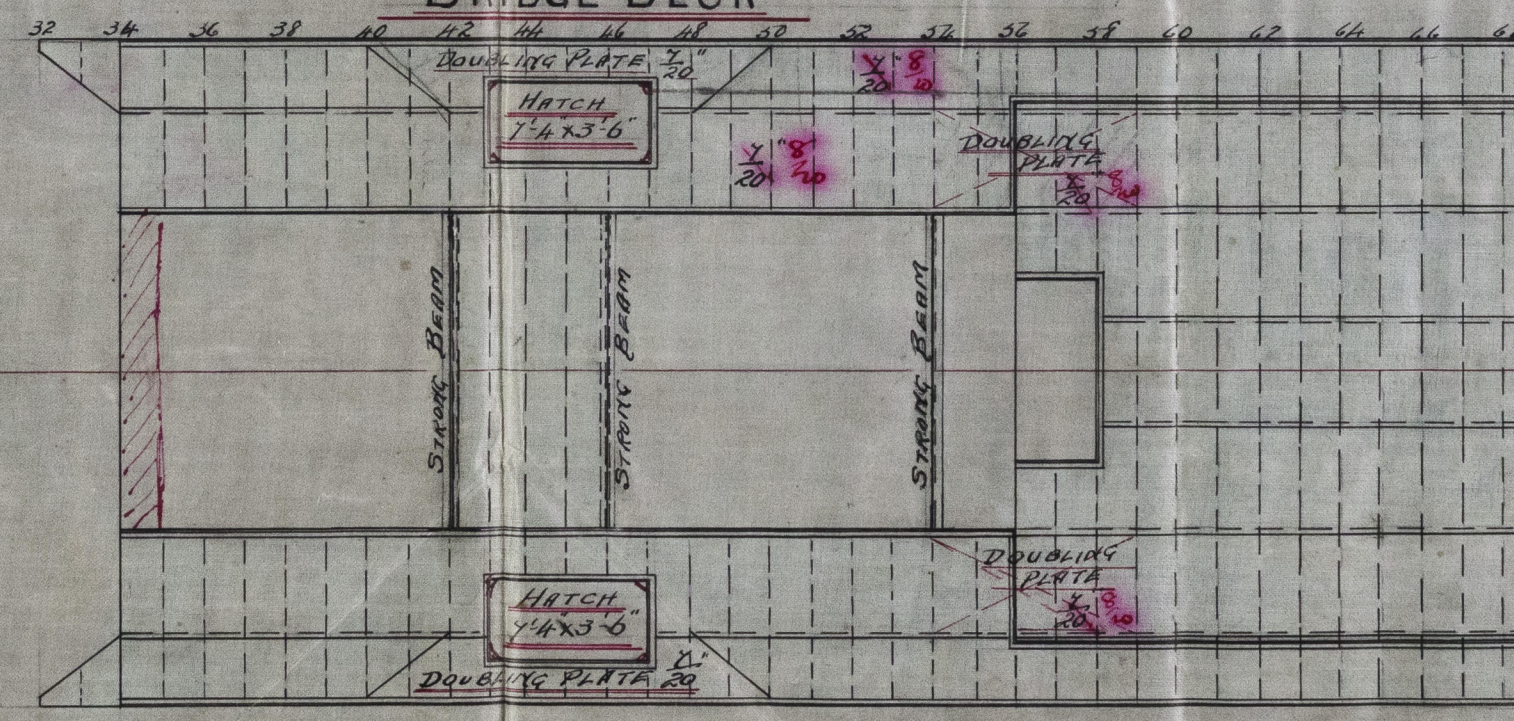

FORECASTLE DECK

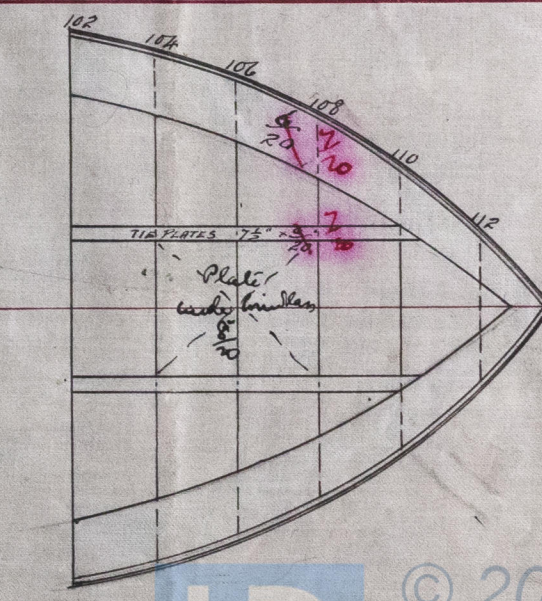

23/5/99

Mackin & Thomson

N^o 258.

665287-0673

Profile & Deck Plan.

S.S. Cambrian

now "Jarl"

Glasgow

Report No 11889



© 2019

Lloyd's Register
Foundation