

Mackin & Thomson
N^o 258.

Section in way of Boilers.
S.S. "Cambrian".

Glasgow Rhr

No 17889

GLS287-0074



PP 2.51.

11:528

SECTION IN WAY OF BOILER
SCALE 1/4" = 1' 0"

SCALE 1/4" = 1' 0"

PP 2.51.

11:528



© 2019

Lloyd's Register
Foundation

LOYS REGISTER OF SHIPING


:23.5.99

Nº 258—

SKETCH SHOWING PROPOSED
STIFFENING IN WAY OF BOILER
SPACE

SCALE $\frac{1}{2}$ " = ONE FOOT.

WATKINS & THOMSON
SHIPBUILDERS
17.V.99.
GLASGOW

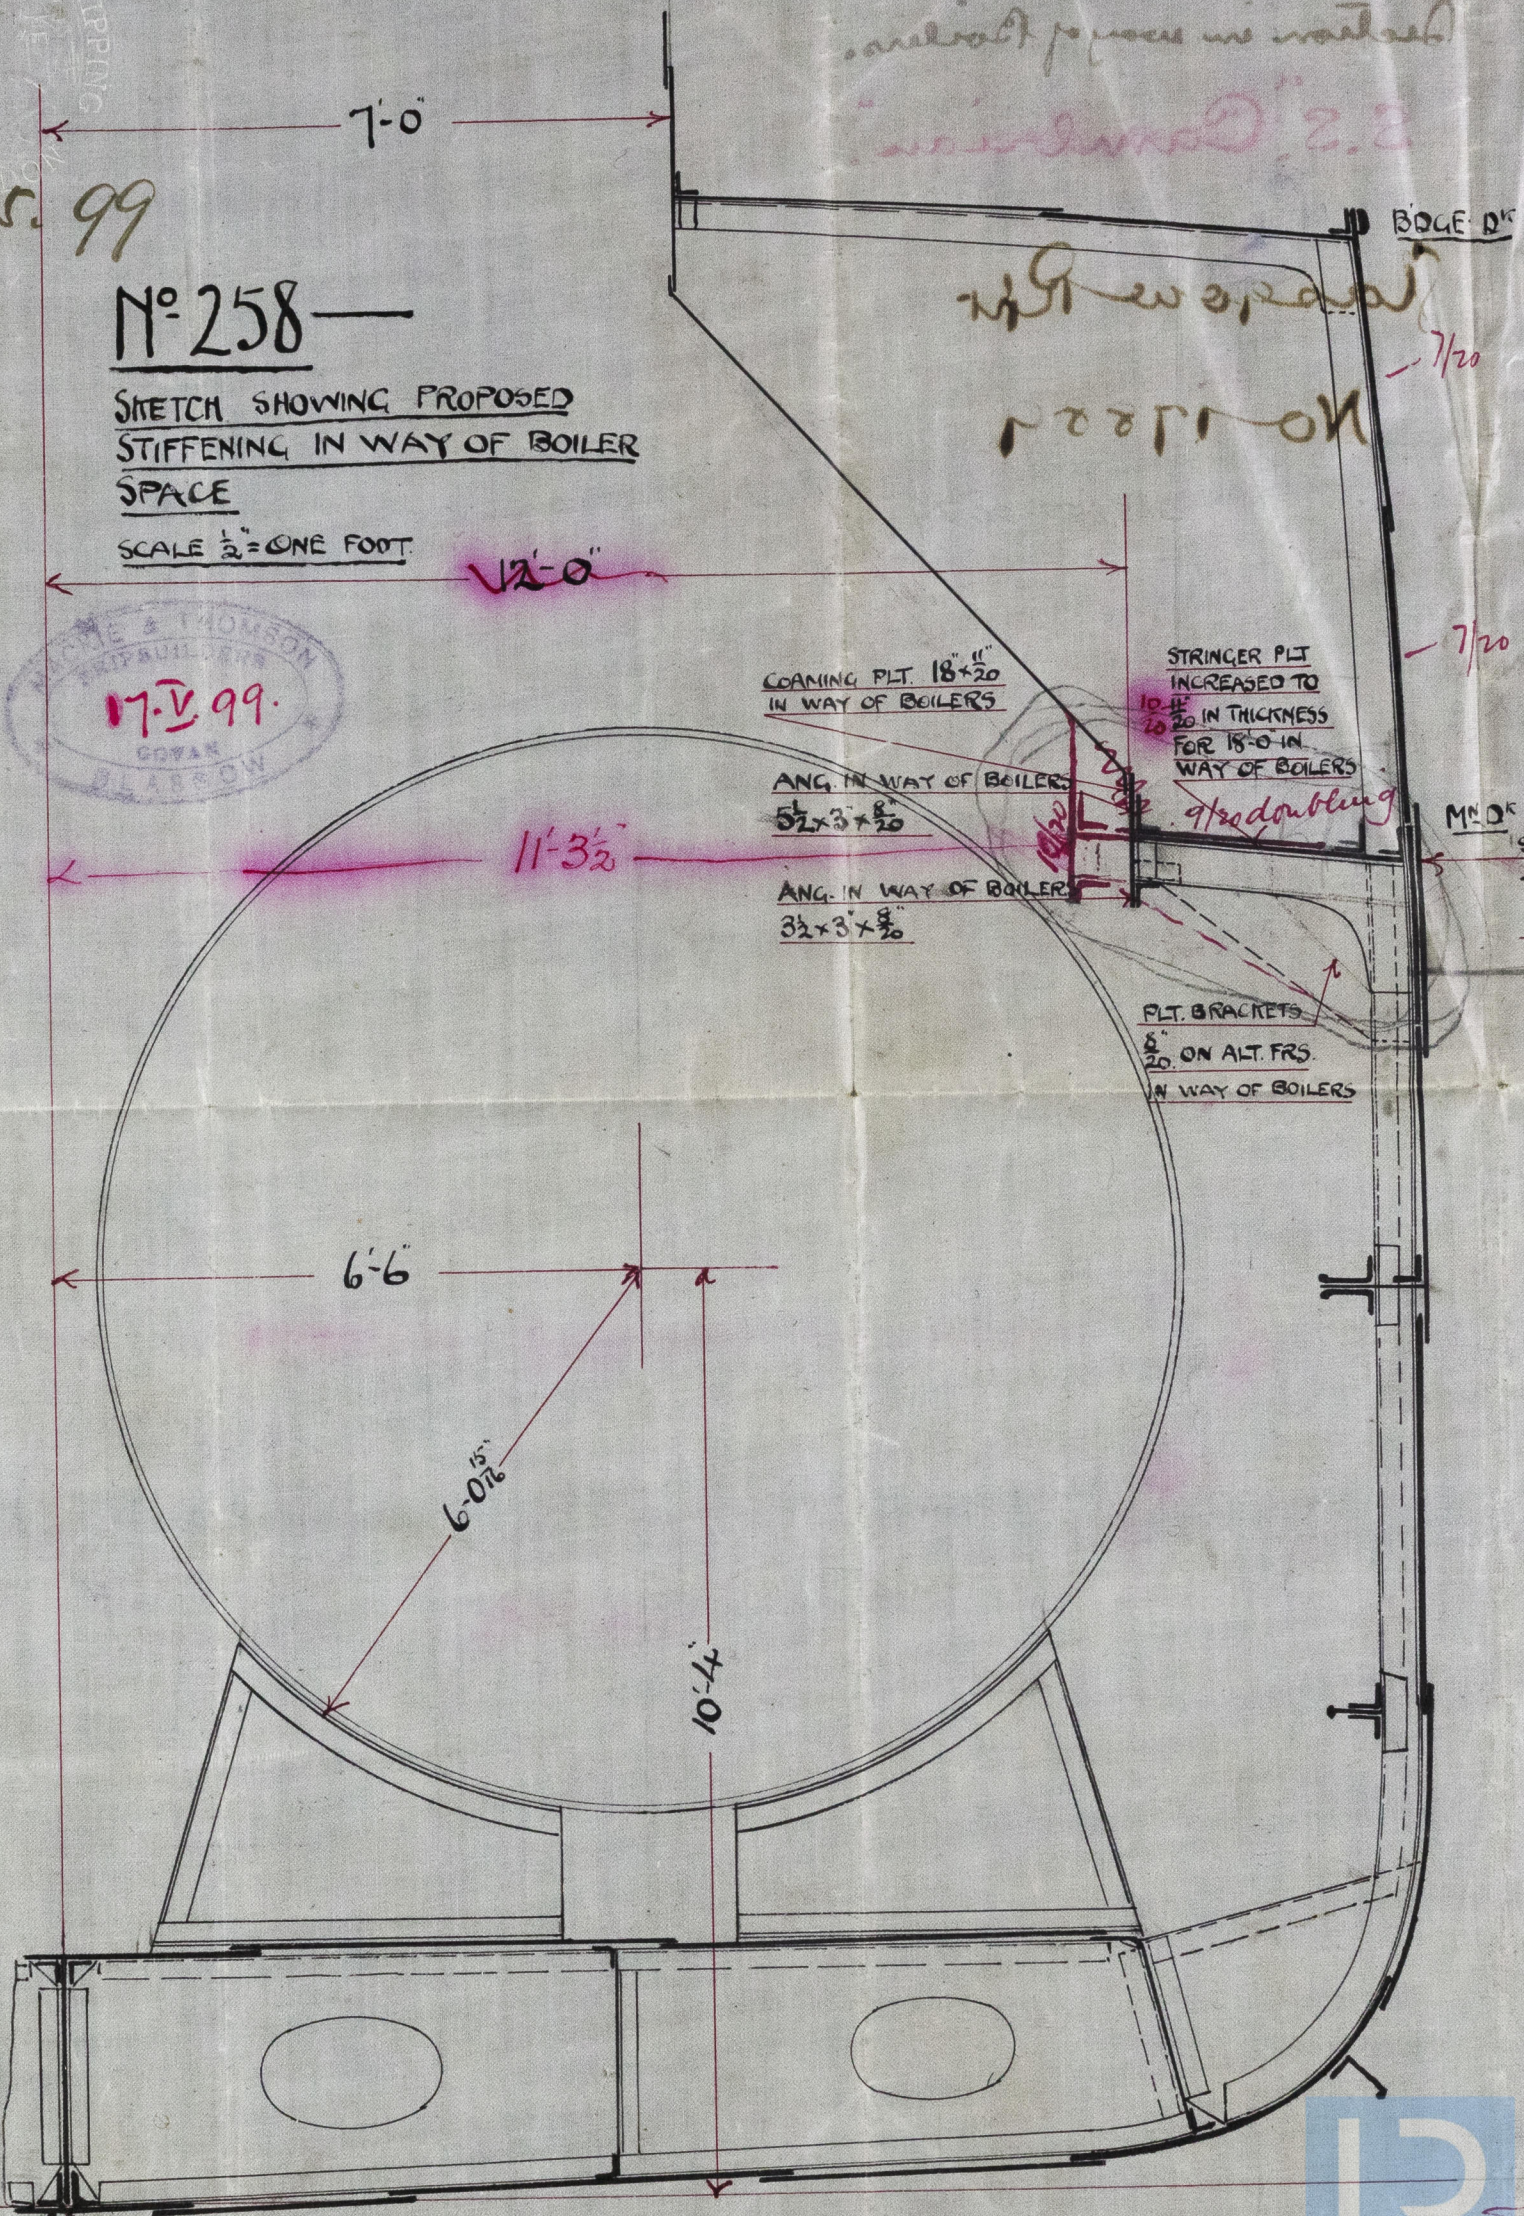

LR

© 2019

Lloyd's Register
Foundation

065278-0074