

Mackie & Thomson

No 258.

Pumping Arrangements

S.S. Cambrian

Glasgow Rte

No 17889


665287-00 75



© 2019

Lloyd's Register
Foundation

29.8.99

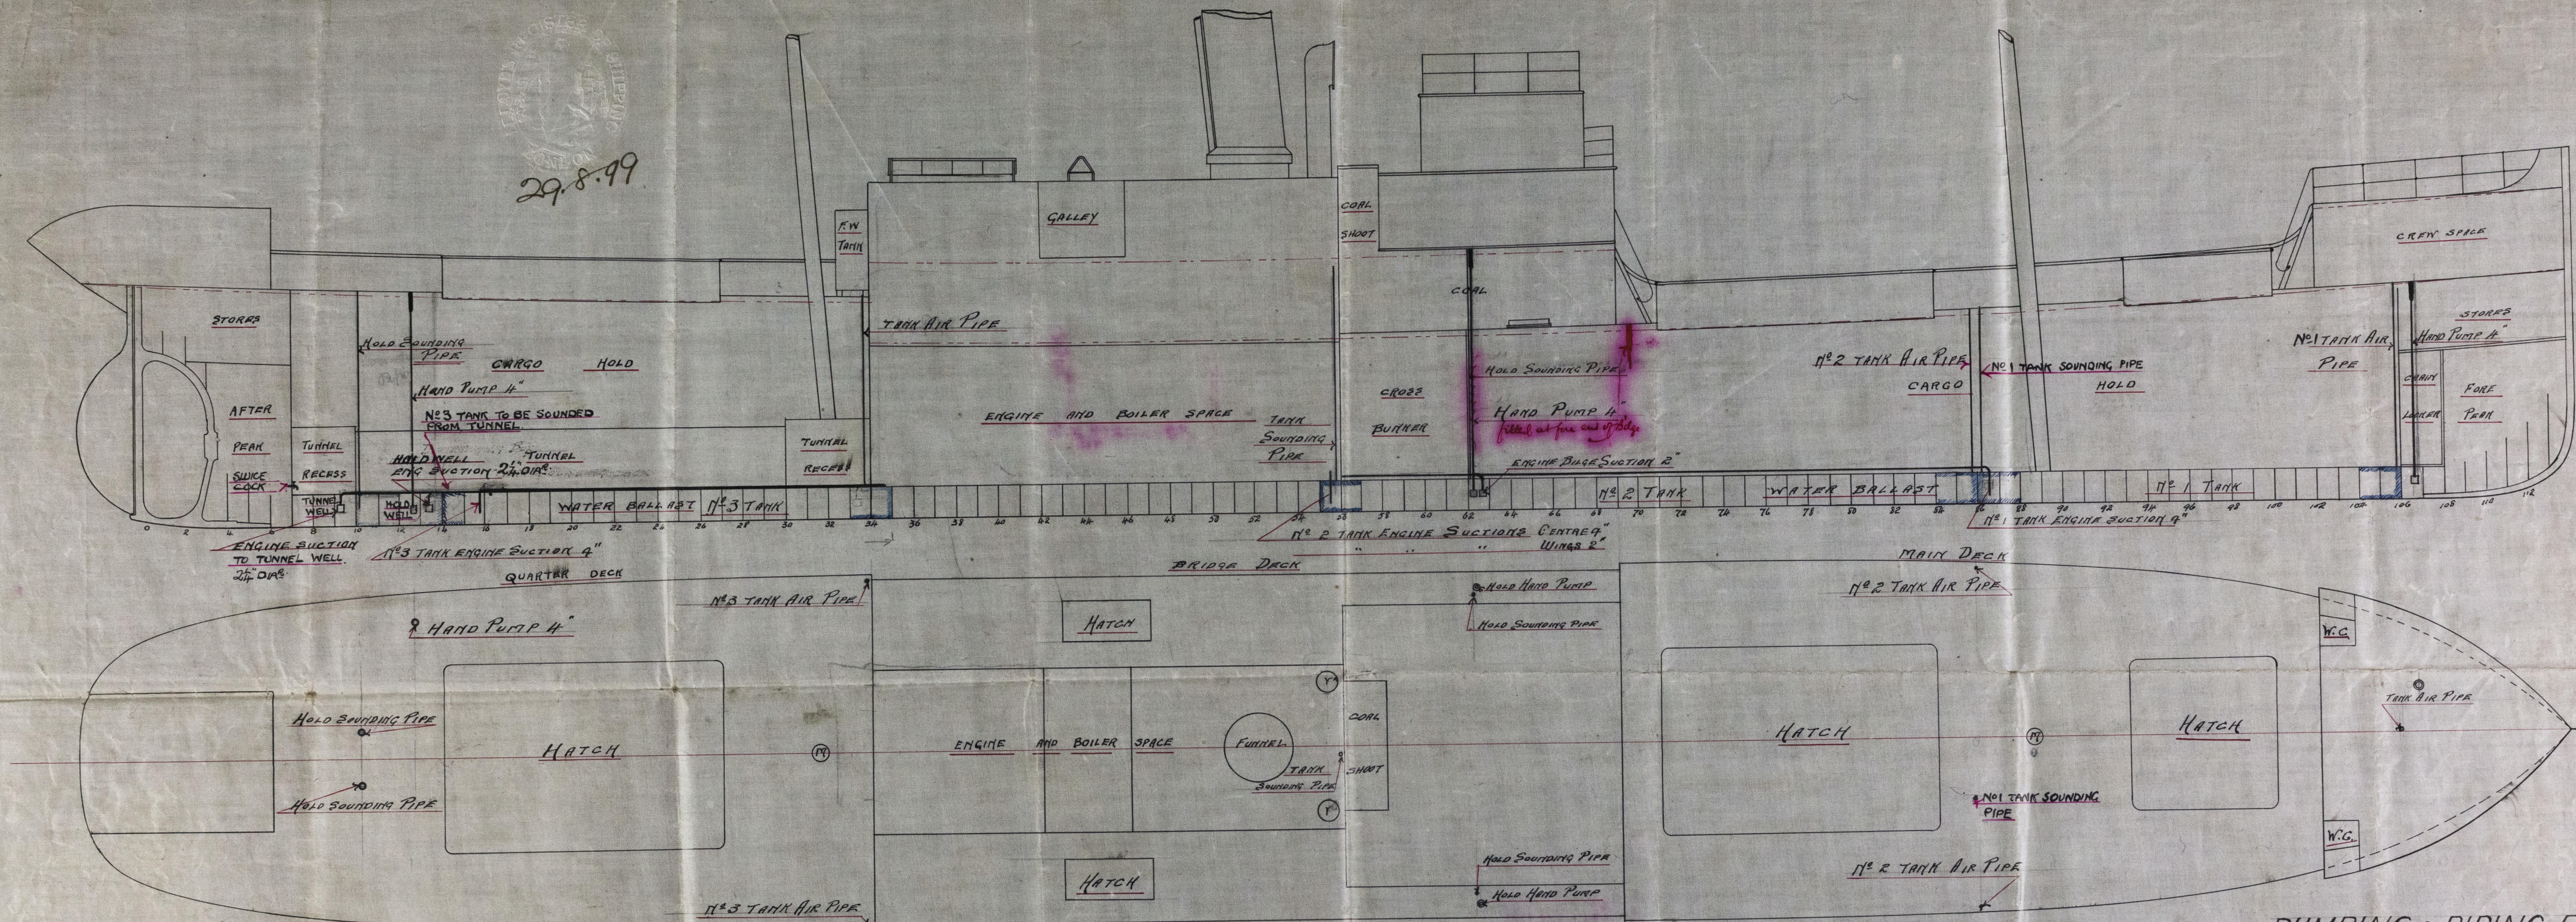

PUMPING & PIPING PLAN

N° 258

SCALE 1/8" = 1 FOOT

VESSEL UNDER 1000 TONS UNDER DECK

2.8.92

Handwritten notes and signatures in the bottom left corner, including '29/8/99' and '16.5.28'.

