

Mackin & Thomson.

No: 258

Amended arrangement
of E. & B. Space.

S. S. Cambrian.

Glasgow:

Report

No 17889



© 2019



665287-0076

Lloyd's Register
Foundation

Amended Arret in way of E. & B. Space No 258 Scale 8" = 1 foot

17. v. 99
 GOVAN
 17. v. 99

23. 8. 99
 No 528
 17. v. 99

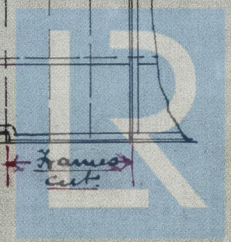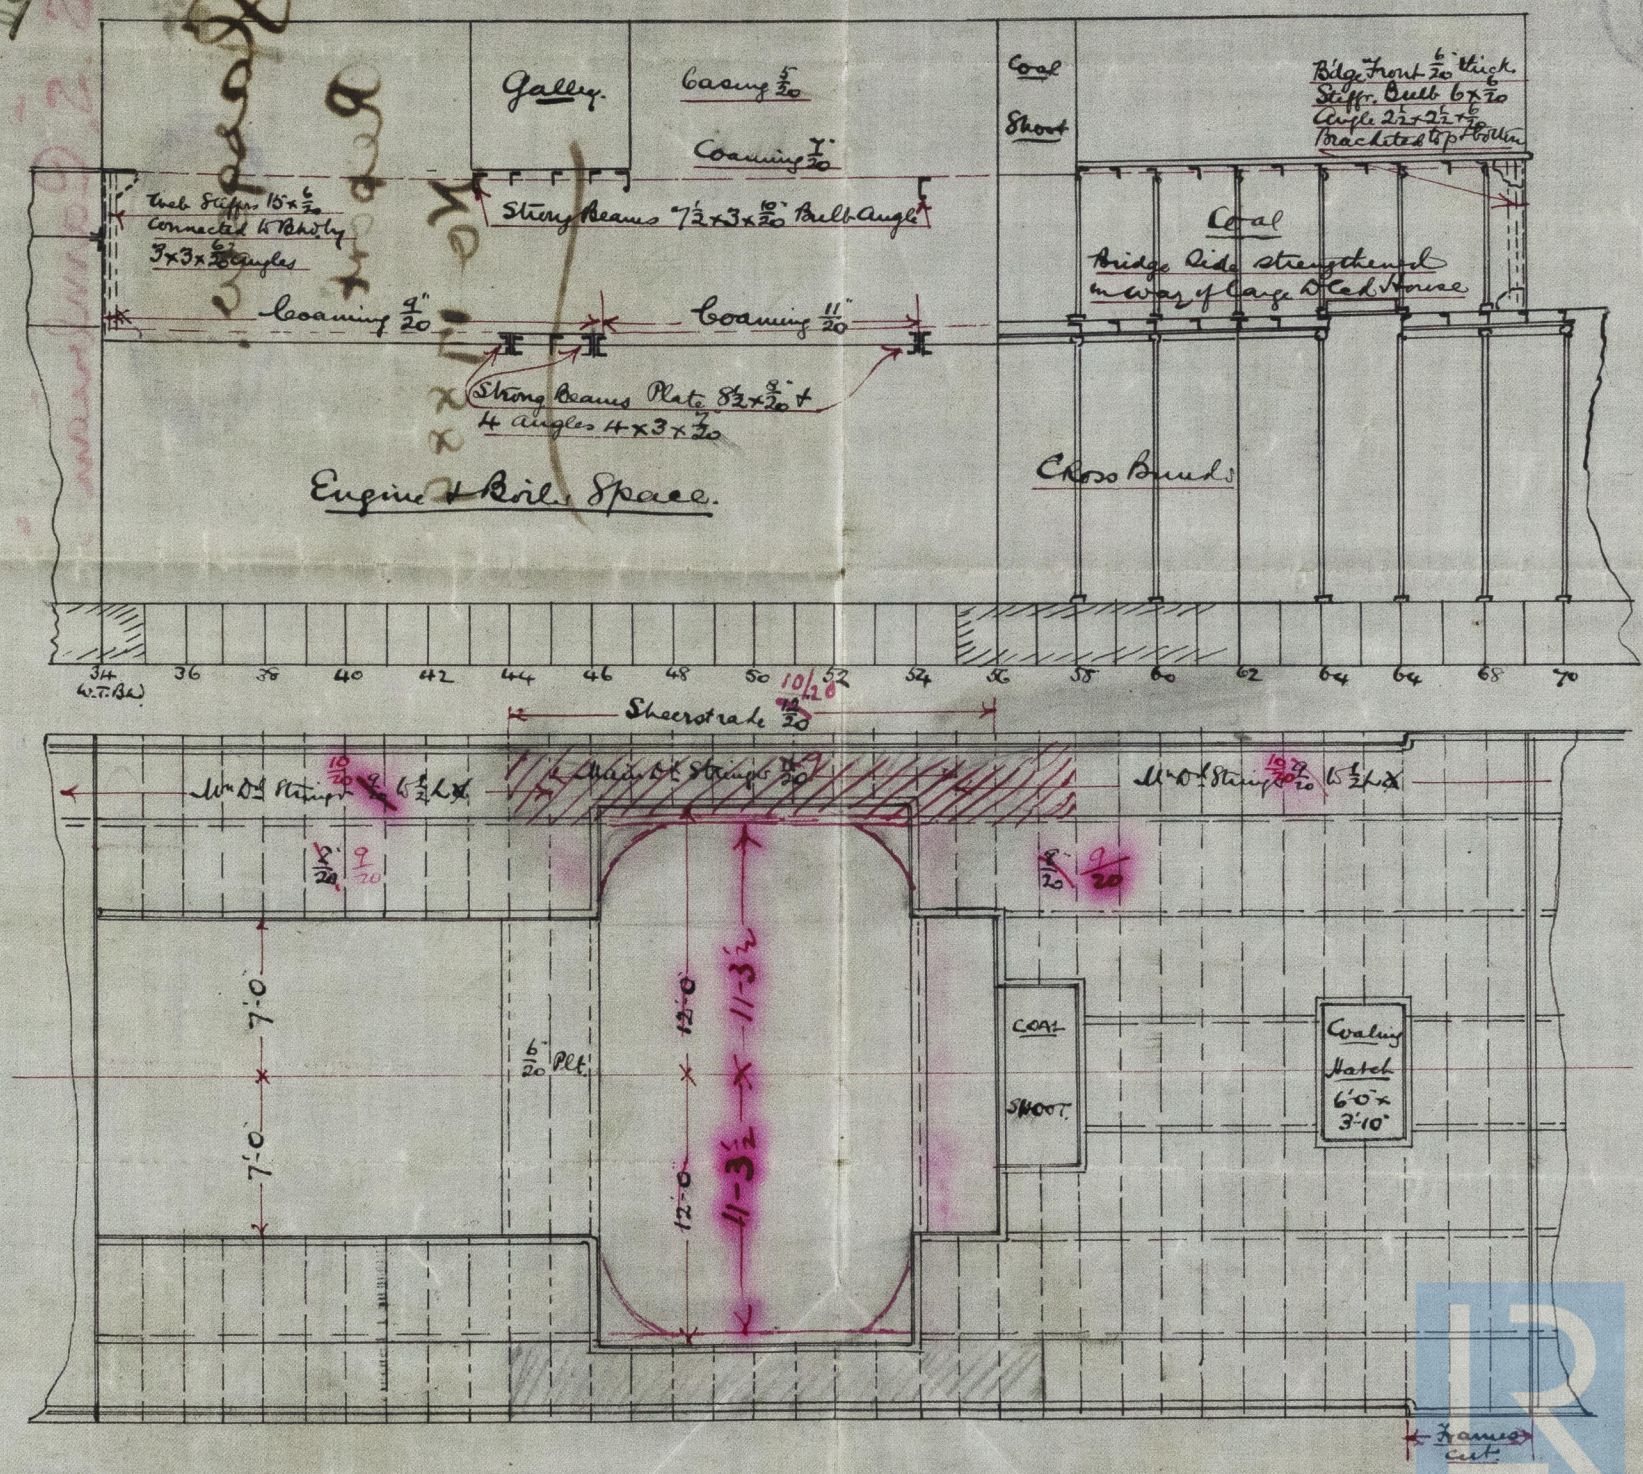

© 2019

Lloyd's Register
 Foundation

23/5/99

665287-0076