


SCALE $\frac{1}{4}'' = \text{ONE FOOT}$

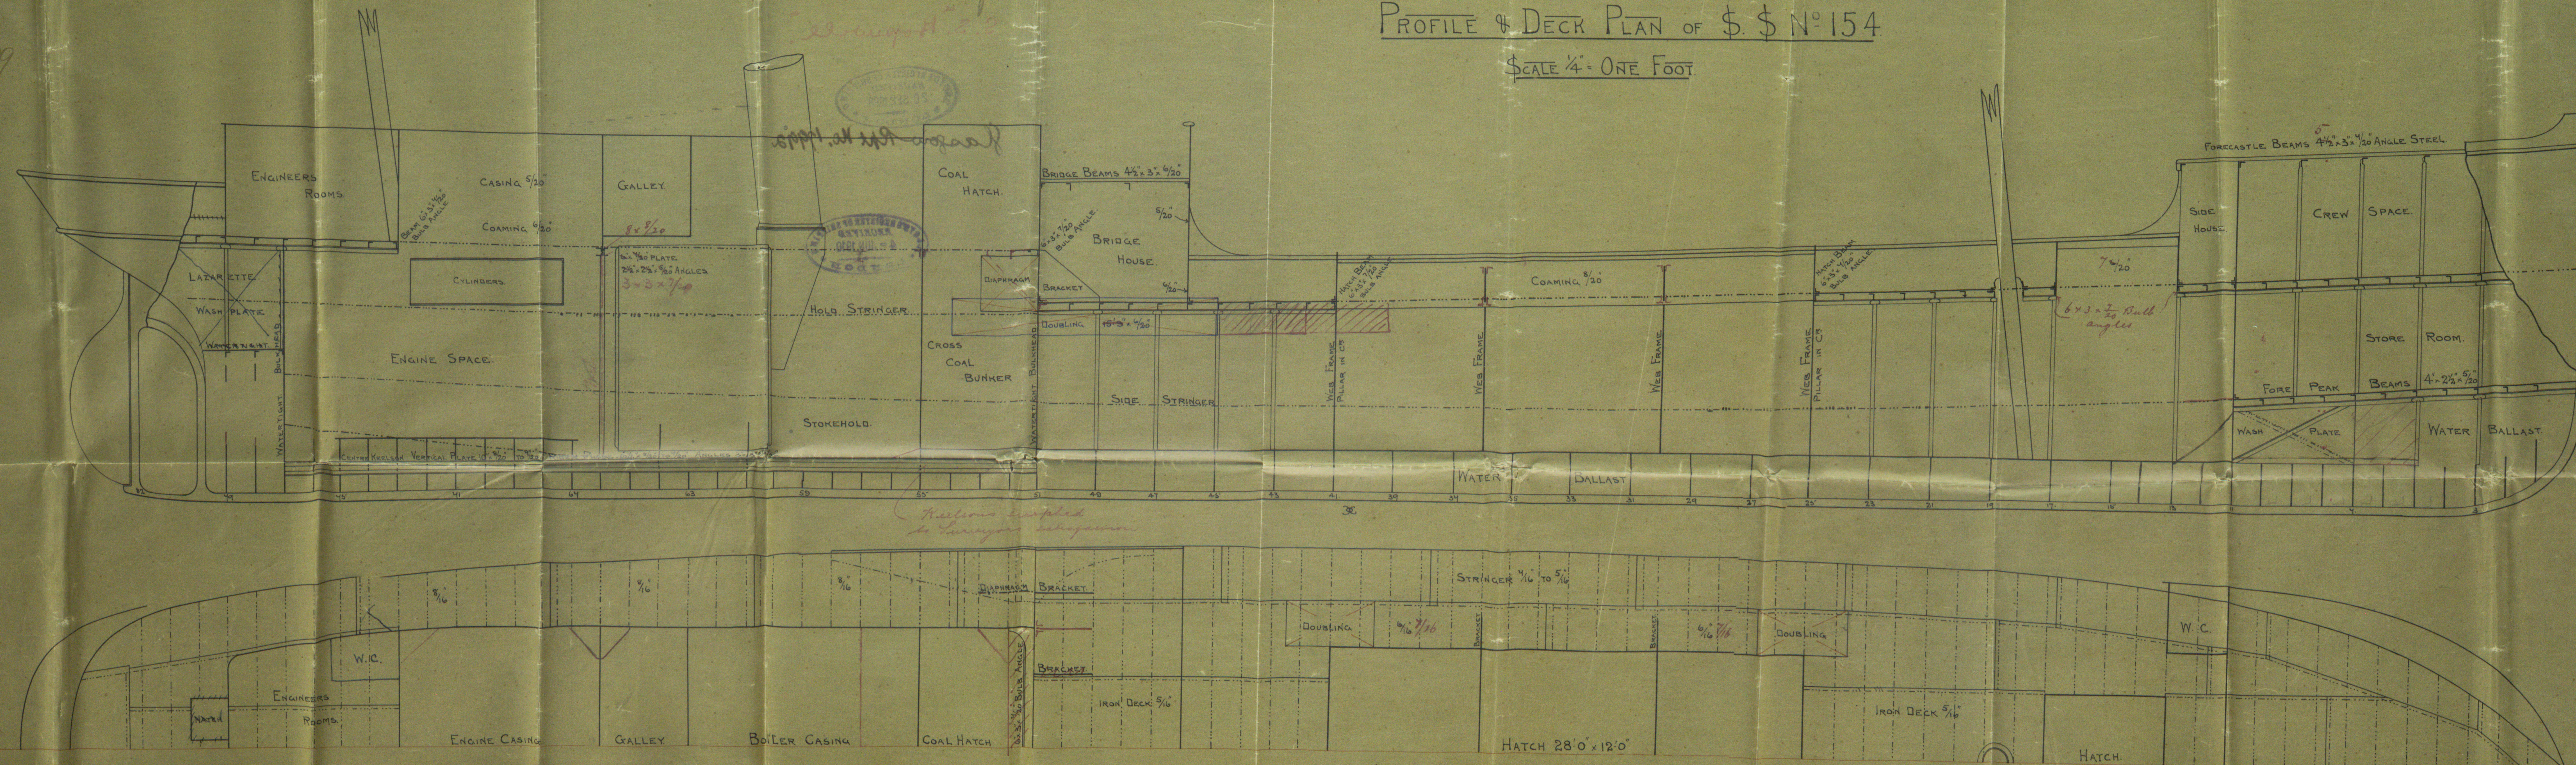


J. Gullerton & Co.

Nº 154.

Profile + Deck Plan

S.S. Hopewell

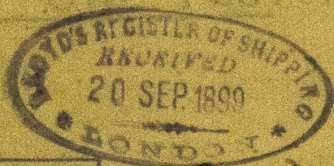


Glasgow Rpt No. 17992


COAL

65287-0144

HATCH

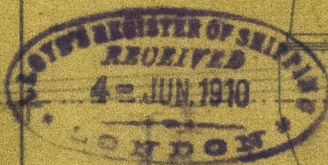


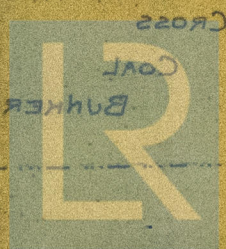

© 2019

Lloyd's Register
Foundation