

S.S. Hopswell

Received at

Office,

189

Lloyd's Register of British and Foreign Shipping.

(Report on Vessel No. 17992 Port Glasgow)No. 5353 SHIP FORGINGS ~~OR CASTINGS~~.

I have to report that the undermentioned Iron or Steel Forgings ~~or Castings~~,
 manufactured by Messrs Emerson Walker & Thompson
 of Dunston for the Vessel No. 154, being built
 by Messrs J Fullerton & Sons of Glasgow
 have been inspected by me as set forth below, and found to be, so far as can be seen,
Sound



Mark on Forgings.

Lloyd's

No. 9763B96John O'GradyNewcastle5.3.00

| | STERN FRAME. | RUDDER FRAME. | STEM. |
|------------------------|-----------------------------|-------------------------------------|-------|
| Material* ... | <u>Scrap</u> | <u>Scrap</u> | / |
| How made ... | <u>Forged</u> | <u>Forged</u> | |
| Dimensions ... | <u>6 1/4 - 3</u> | <u>4 - 2 1/4</u> | |
| Progress on Inspection | <u>Forged & Smithed</u> | <u>Forged & Smithed</u> | |
| Date when Inspected | <u>November 1 to 30/99</u> | <u>January 16 to February 10/00</u> | |

SKETCHES OF FRAMES SHOWING POSITION AND DESCRIPTION OF WELDS OF FORGINGS, OR PARTICULARS OF TESTS APPLIED TO CASTINGS.

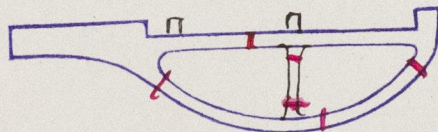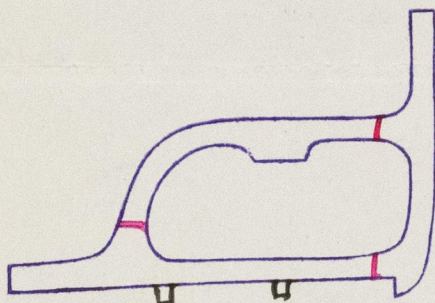

Fee (if any chargeable) £

To be paid at