

For the information of Surveyors and the Committee only.

Received at 31 JUL 1900 Office, 100

Lloyd's Register of British and Foreign Shipping.

(Report on Vessel No. 18165 Port Glasgow)

No. 7350 SHIP FORGINGS OR CASTINGS.

The words FORGINGS or CASTINGS, IRON or STEEL, should be struck out as may be required.

I have to report that the undermentioned Iron or Steel Forgings or Castings, manufactured by Mess Robt Kerr & Sons of Irvine for the Vessel No. 22, being built by The Irvine S. B. Coy of Irvine have been inspected by me as set forth below, and found to be, so far as can be seen, Sound & efficient


Mark on Forgings.

Lloyd's No. 7350 W.H.

William Hamilton Glasgow


Table with columns: STERN FRAME, RUDDER FRAME, STEM. Rows: Material*, How made, Dimensions, Progress on Inspection, Date when Inspected. Handwritten entries: Scrap iron forged, 4 1/2 to 13 1/2 x 8 1/2, Forging & smithing, 28/3/00 to 13/4/00.

SKETCHES OF FRAMES SHOWING POSITION AND DESCRIPTION OF WELDS OF FORGINGS, OR PARTICULARS OF TESTS APPLIED TO CASTINGS.

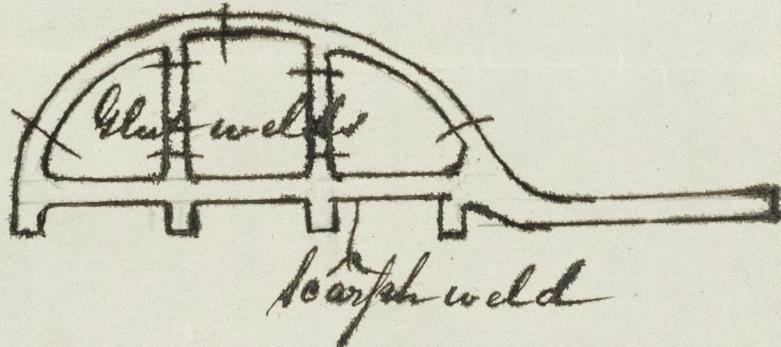

Fee (if any chargeable) £ : :

To be paid at

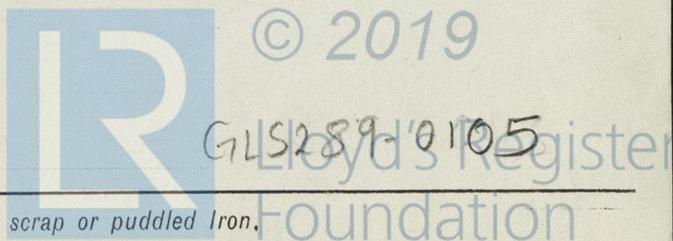

* If of Iron, state whether scrap or puddled Iron.