

ss. Achilles

Received at

31 JUL 1900

Office

ING

Lloyd's Register of British and Foreign Shipping.

(Report on Vessel No. 18165 Port Glasgow)

The words FORGINGS or CASTINGS, IRON or STEEL, should be struck out, as may be required.

No. 7350 SHIP FORGINGS OR CASTINGS.

I have to report that the undermentioned Iron or Steel Forgings or Castings, manufactured by Mess Robt Kerr & Son of Irvine for the Vessel No. 22, being built by The Irvine & B Coy of Irvine have been inspected by me as set forth below, and found to be, so far as can be seen, Sound & efficient


Mark on Forgings.

Lloyd's
No. 7350
W.H

William Hamilton
Glasgow

	STERN FRAME.	RUDDER FRAME.	STEM.
Material*	Scrap iron		
How made	Forged		
Dimensions	6 3/4 x 4		
Progress on Inspection	Forging & smithing		
Date when Inspected	8/11/99 to 27/12/99		

SKETCHES OF FRAMES SHOWING POSITION AND DESCRIPTION OF WELDS OF FORGINGS, OR PARTICULARS OF TESTS APPLIED TO CASTINGS.

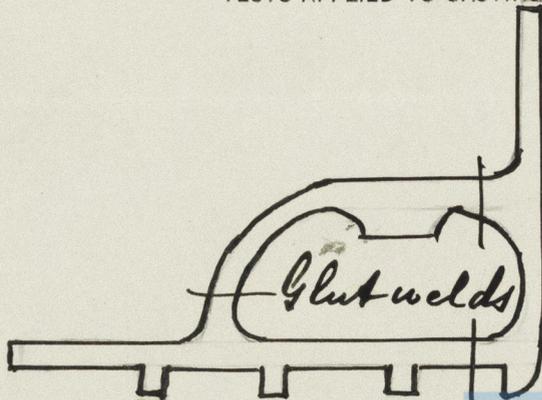

Fee (if any chargeable) £ : :

To be paid at

