



— S.S. N<sup>o</sup> 22 —

Scale  $\frac{1}{4}'' = \text{One Foot}$

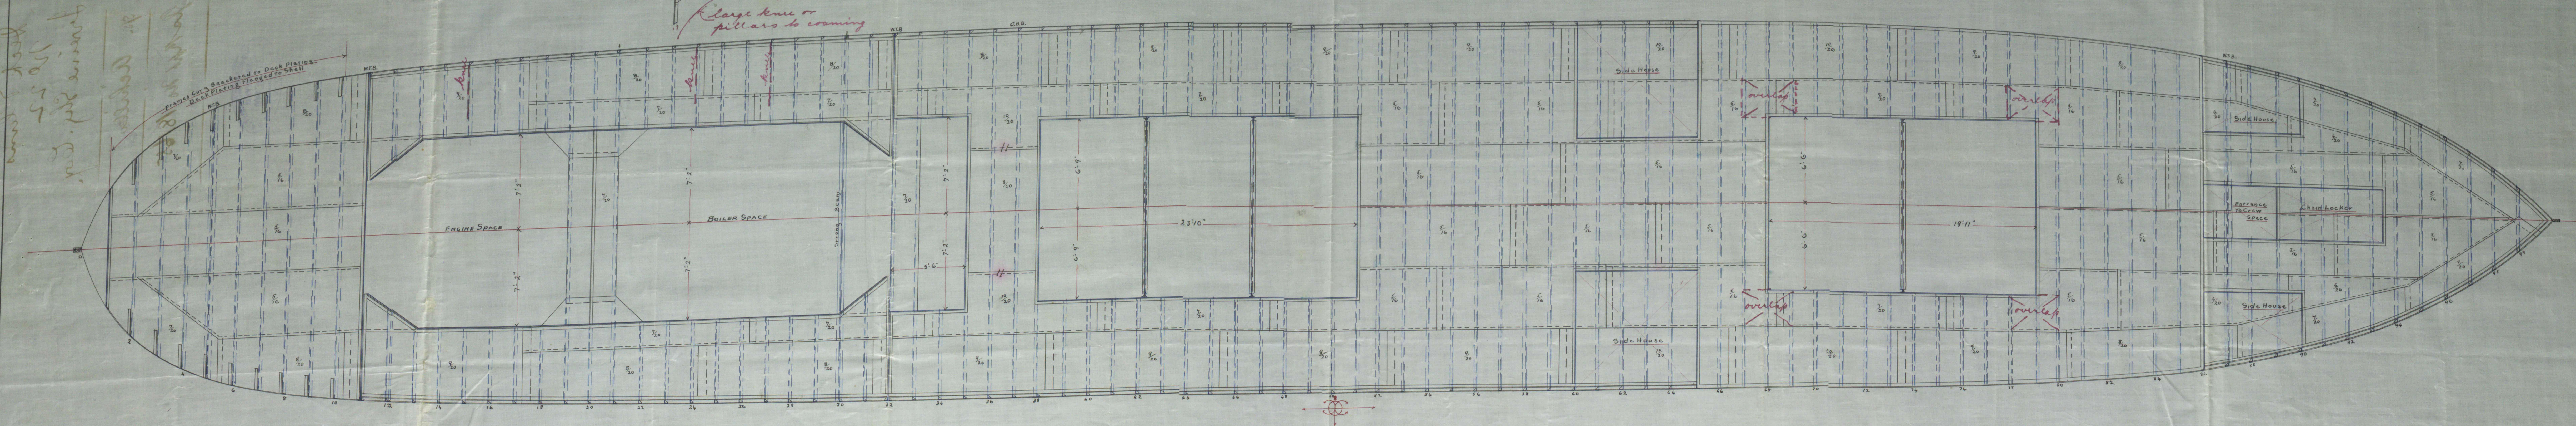

26/10/99






Deck Plans  
No 22  
Irvine Shig. Coy.

S/S. Achilles

Gr Rpt No. 18/65

GLS289-0111

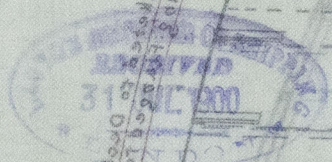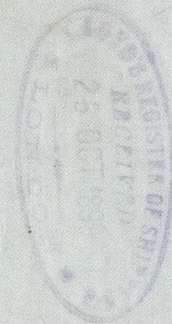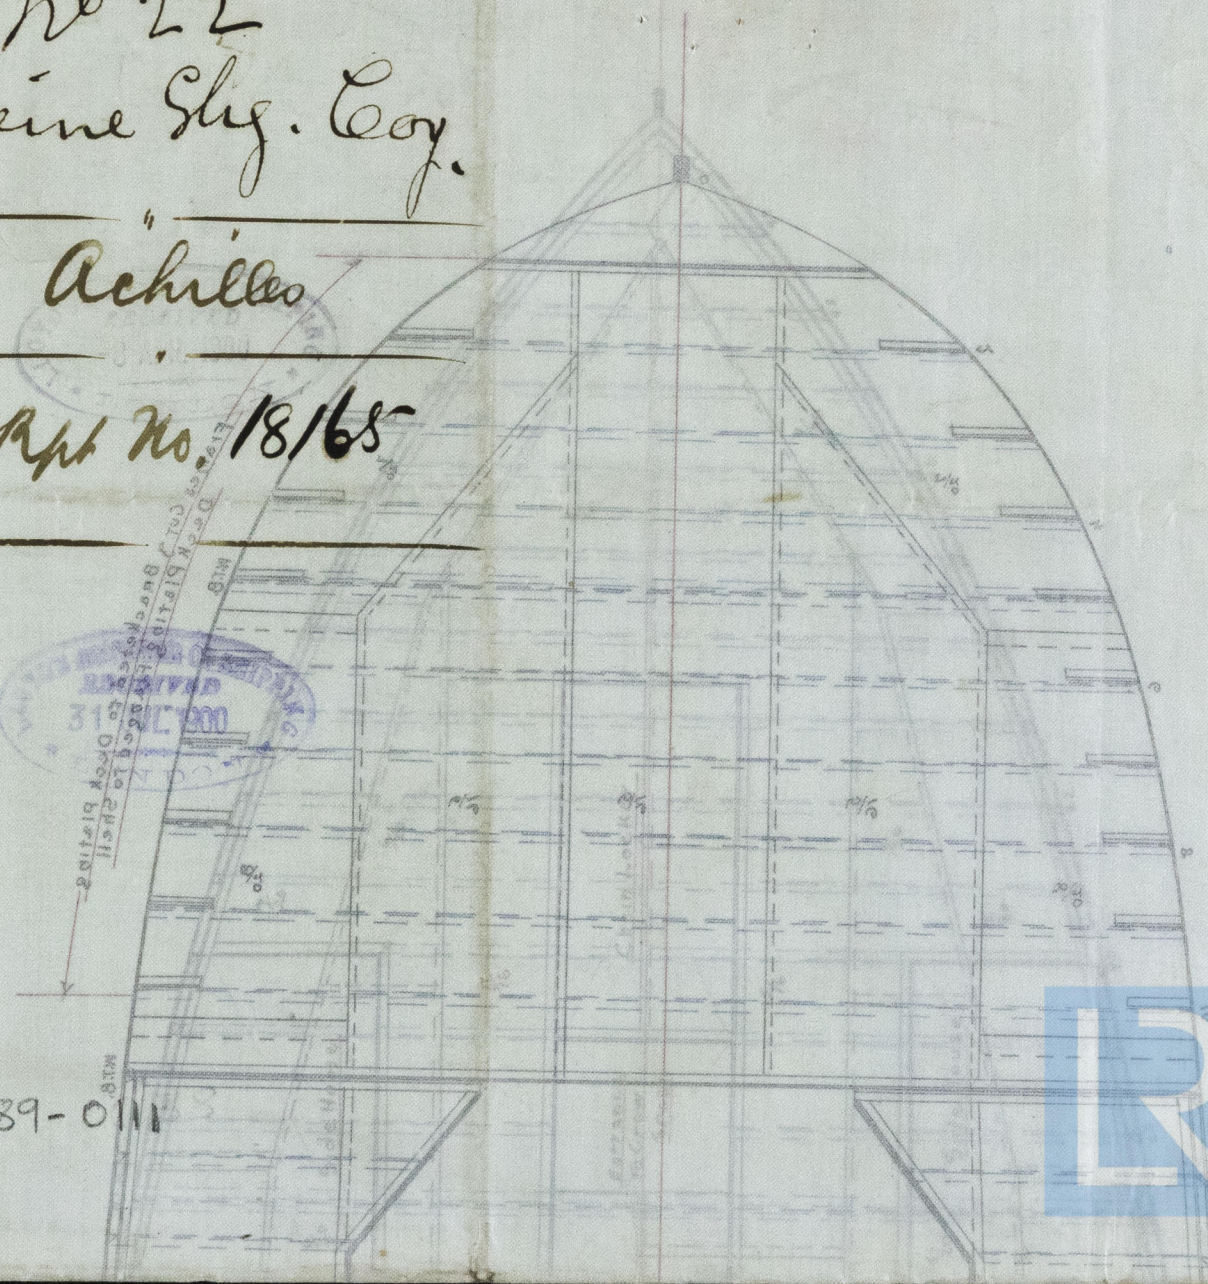

© 2019

Lloyd's Register  
Foundation