

S.S. "Pollux"

Received at

Office.

1899

Lloyd's Register of British and Foreign Shipping.

(Report on Vessel No. 18189, Port Glasgow.)

No. 6208 SHIP FORGINGS OR CASTINGS.

I have to report that the undermentioned Iron or Steel Forgings or Castings, manufactured by The Harbour Forge Coy of Irvine for the Vessel No. 227, being built by Mess Mackie & Thomson of Glasgow have been inspected by me as set forth below, and found to be, so far as can be seen, Sound & efficient

The words FORGINGS or CASTINGS, IRON or STEEL, should be struck out, as may be required.

Added in N. 214
Pollux


Mark on Forgings.

Lloyd's
No. 6208
WH

William Hamilton
Glasgow

	STERN FRAME.	RUDDER FRAME.	STEM.
Material*		Scrap iron	
How made		Forged	
Dimensions		3 3/4 to 3 3/4 x 3	
Progress on Inspection		Forging & smithing	
Date when Inspected		11/8/99 to 24/10/99	

SKETCHES OF FRAMES SHOWING POSITION AND DESCRIPTION OF WELDS OF FORGINGS, OR PARTICULARS OF TESTS APPLIED TO CASTINGS.

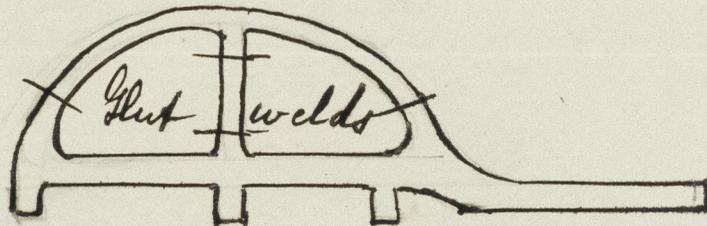

Fee (if any chargeable) £

To be paid at



© 2019

Lloyd's Register
Foundation