

## Lloyd's Register of British and Foreign Shipping.

*5/8" Machine*(Report on Vessel No. *18394* Port *Glasgow*)No. *4718*

## SHIP FORGINGS OR CASTINGS.

I have to report that the undermentioned Iron or Steel Forgings or Castings,  
 manufactured by *Messrs Emerson Walker & Thompson*  
 of *Dunston* for the Vessel No. *145*, being built  
 by *Messrs Scott & Co* of *Glasgow*  
*Mr Shaw &*  
 have been inspected by me as set forth below, and found to be, so far as can be seen,  
*Sound*

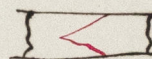
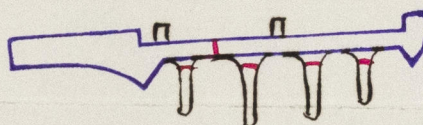
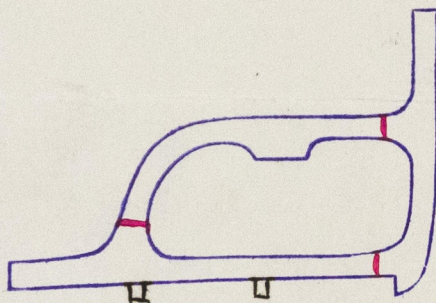
Mark on Forgings.

Lloyd's

No. *101365**JB**John C Craig**Newcastle**8.10.00*

	STERN FRAME.	RUDDER FRAME.	STEM.
Material*	<i>Scrap</i>	<i>Scrap</i>	
How made	<i>Forged</i>	<i>Forged</i>	
Dimensions	<i>6 - 2 1/2</i>	<i>3 3/4 - 2 1/4</i>	
Progress on Inspection	<i>Forged &amp; Smithed</i>	<i>Forged &amp; Smithed</i>	
Date when Inspected	<i>February 8 to 19/00</i>	<i>September 3 to 21/00</i>	

SKETCHES OF FRAMES SHOWING POSITION AND DESCRIPTION OF WELDS OF FORGINGS, OR PARTICULARS OF TESTS APPLIED TO CASTINGS.

*welds*

Fee (if any chargeable) £

To be paid at