


S.S. N° 256

SCALE $\frac{1}{8}" = \text{ONE FOOT}$


UPPER DECK

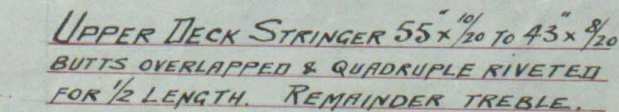

Upper Deck plating $\frac{3}{16}$ to $\frac{7}{16}$
Butts overlapped and double riveted for $\frac{1}{2}$ Length
Remainder single riveted

Landings all single riveted

MAIN DECK.

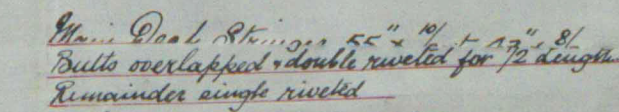

Landings all single riveted

C. CONNELL & CO

Shrubbuilders

GLASGO

GLS292-0026 Lloyd's Register Foundation

C. Connell &
256 of Dunbar
86 apr no 18574

GL3292-0026



© 2019

Lloyd's Register
Foundation