



# SECTION SHEWING HORIZONTAL STIFFENER

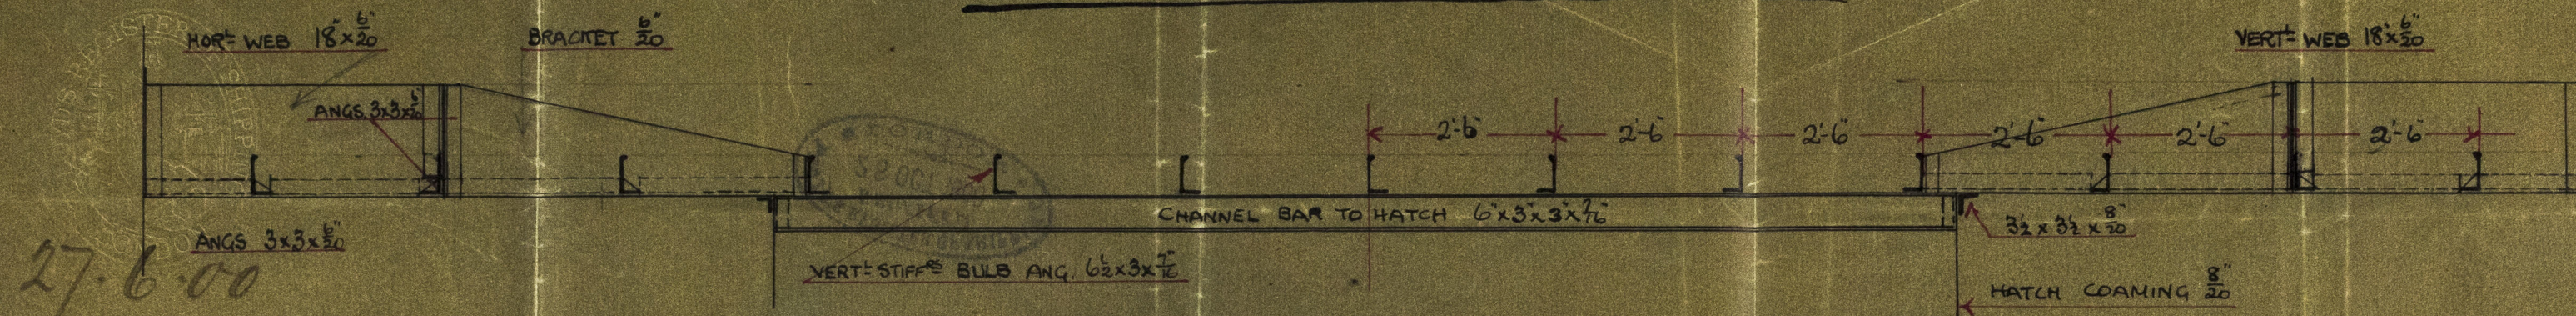

27.6.00

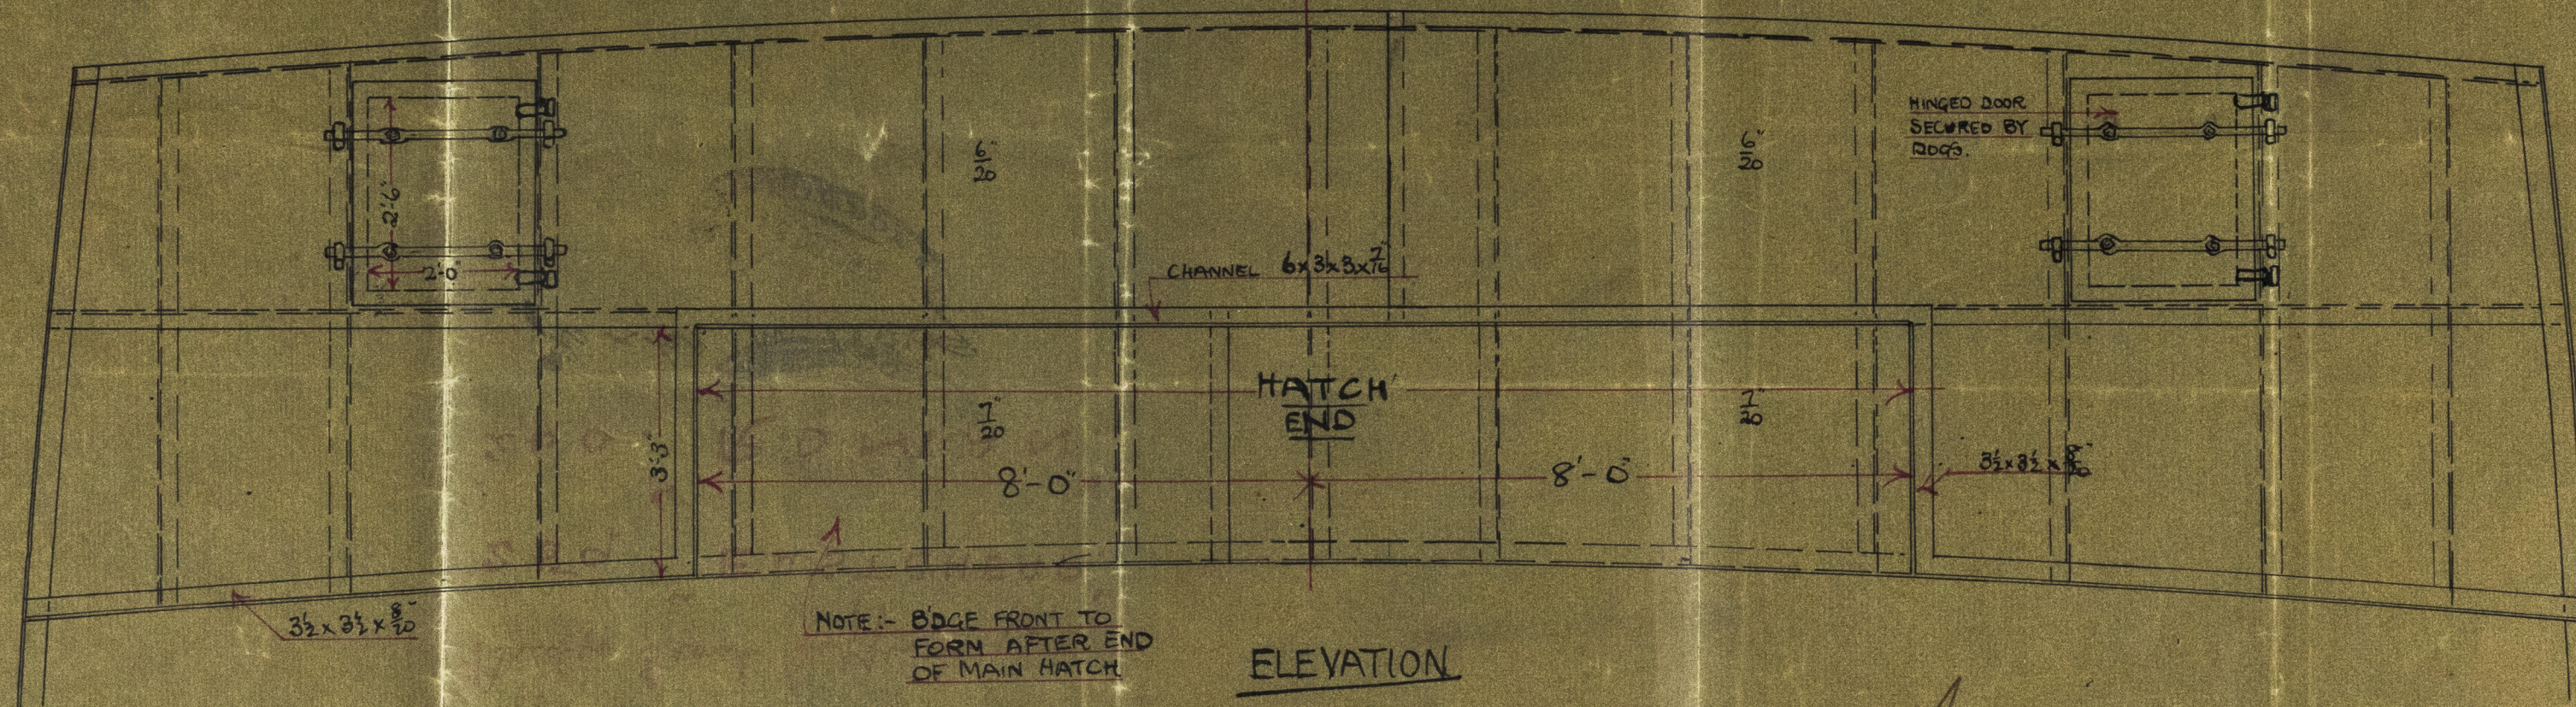


NOTE:- EDGE FRONT TO FORM AFTER END OF MAIN HATCH

ELEVATION

27.6.00

## EXTRA STIFFENING OF BRIDGE FRONT

Nos 259 + 260  
SCALE 1/2" = 1 FOOT

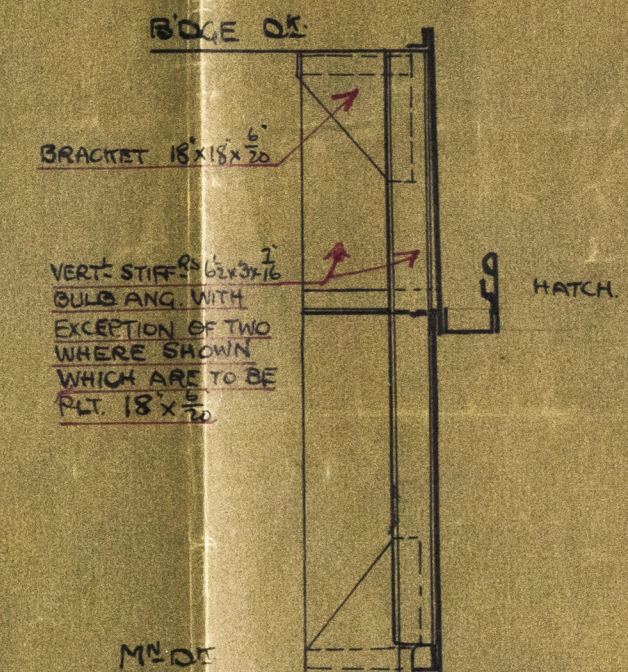

© 2019

Lloyd's Register Foundation  
GLS272-0018



Mackie & Thomson

N<sup>os</sup> 259 & 260

Bridge Street Dipping

259 "EASTCHEAP."

260 "ROMAN."

Ships No. 18889



GL3292-0048



© 2019

Lloyd's Register  
Foundation