

# Lloyd's Register of British and Foreign Shipping.

(Report on Vessel No. \_\_\_\_\_ Port Hull)

No. 4305 SHIP FORGINGS OR CASTINGS.

The words FORGINGS or CASTINGS, IRON or STEEL, should be struck out as may be required.

I have to report that the undermentioned Iron or Steel Forgings or Castings, manufactured by The Blaydon Forge Co of Blaydon for the Vessel No. 3, being built by Messrs Hagerup Doughty & Co of Hull have been inspected by me as set forth below, and found to be, so far as can be seen, Sound



Mark on Forgings.

Lloyd's  
No. 8129B  
76

John C Braij  
Newcastle

	STERN FRAME.	RUDDER FRAME.	STEM.
Material* ...	/	Scrap Forged 3 1/4 - 2 1/4 Forged & Smithed June 9 to July 1/28	/
How made ...			
Dimensions ...			
Progress on Inspection			
Date when Inspected			

SKETCHES OF FRAMES SHOWING POSITION AND DESCRIPTION OF WELDS OF FORGINGS, OR PARTICULARS OF TESTS APPLIED TO CASTINGS.

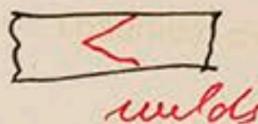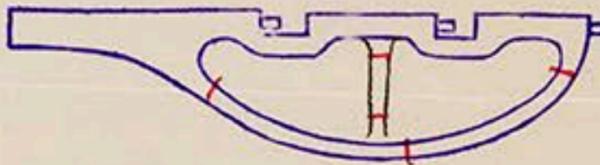

Fee (if any chargeable) £ : :

To be paid at \_\_\_\_\_

\* If of Iron, state whether scrap or puddled Iron.