


# MIDSHIP SECTION N<sup>o</sup> 17. S.S. "NUTTALIA".

CLASS 100 A.I. IRON.

NUMERALS  $10.70 + 12.83 + 19.75 = 43.28$   $10.70 + 12.83 + 19.75 \times 120 = 5193.60$

PROPORTIONS  $120 \div 12.83 = 9.35$   $120 \div 21.40 = 5.70$

SCALE  $\frac{1}{2}$ " = ONE FOOT.

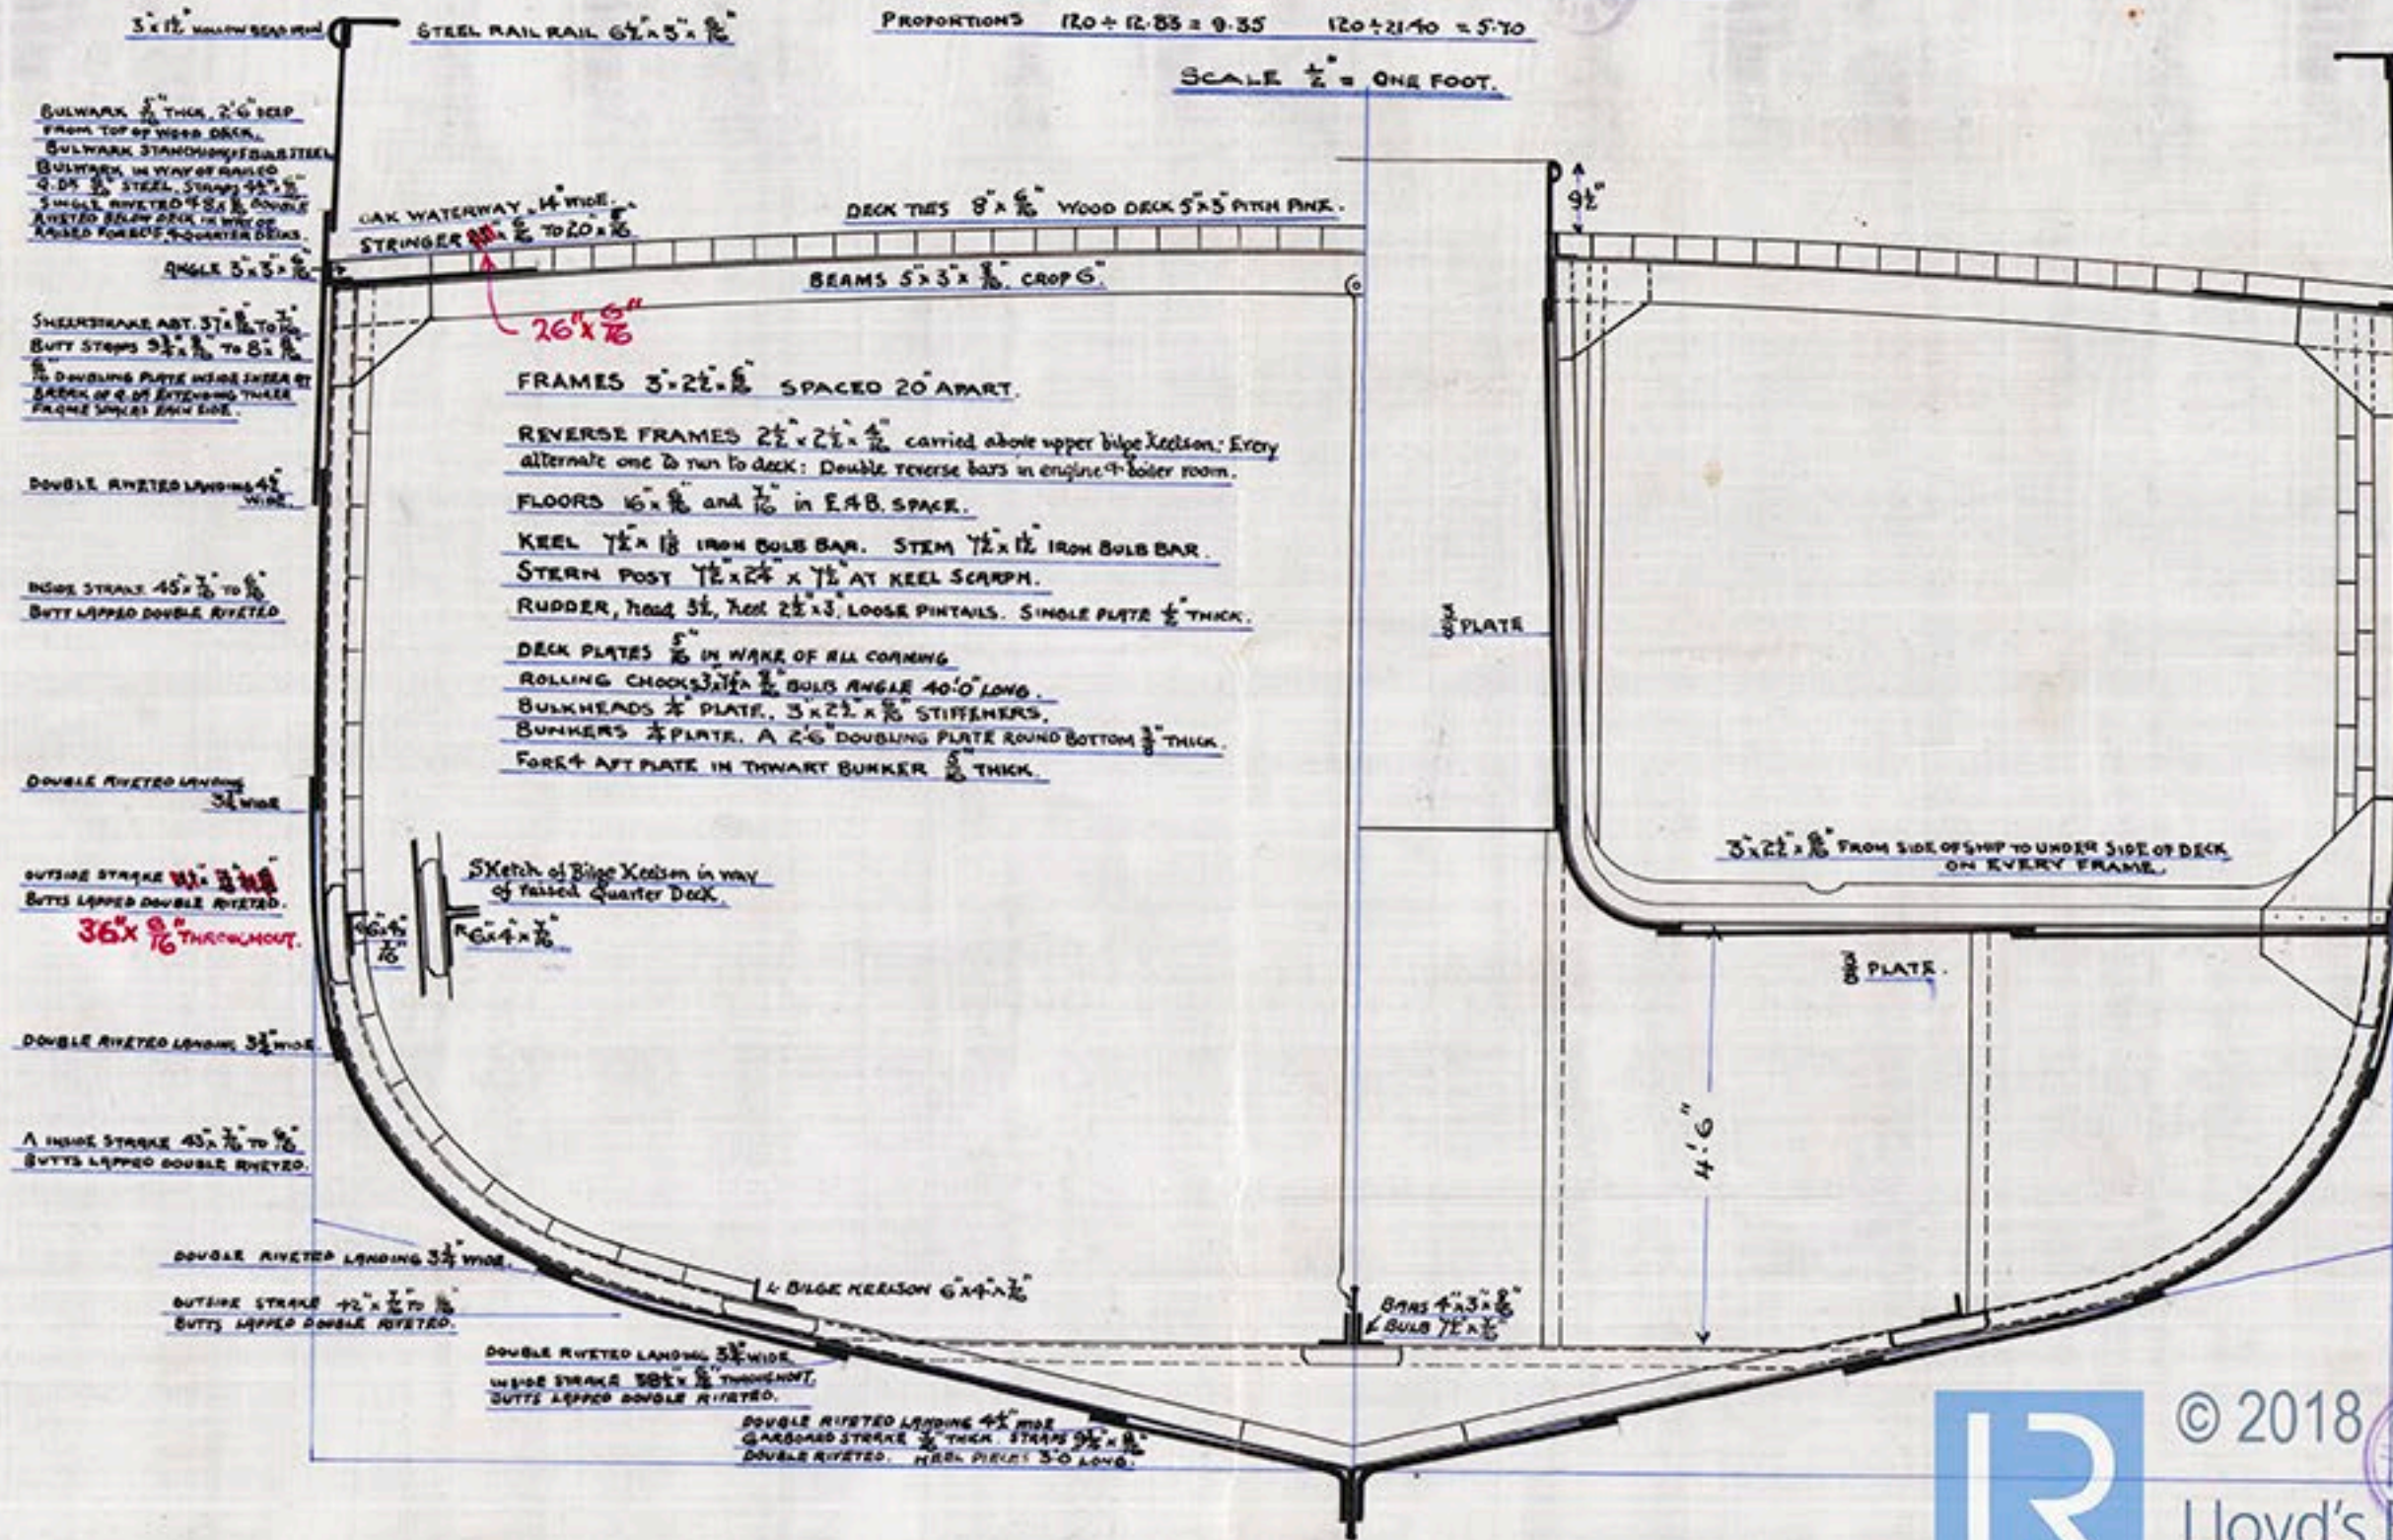

100 20 21 40  
22 22 22 22




© 2018

Lloyd's Register  
Foundation





Gms Rpt No 284

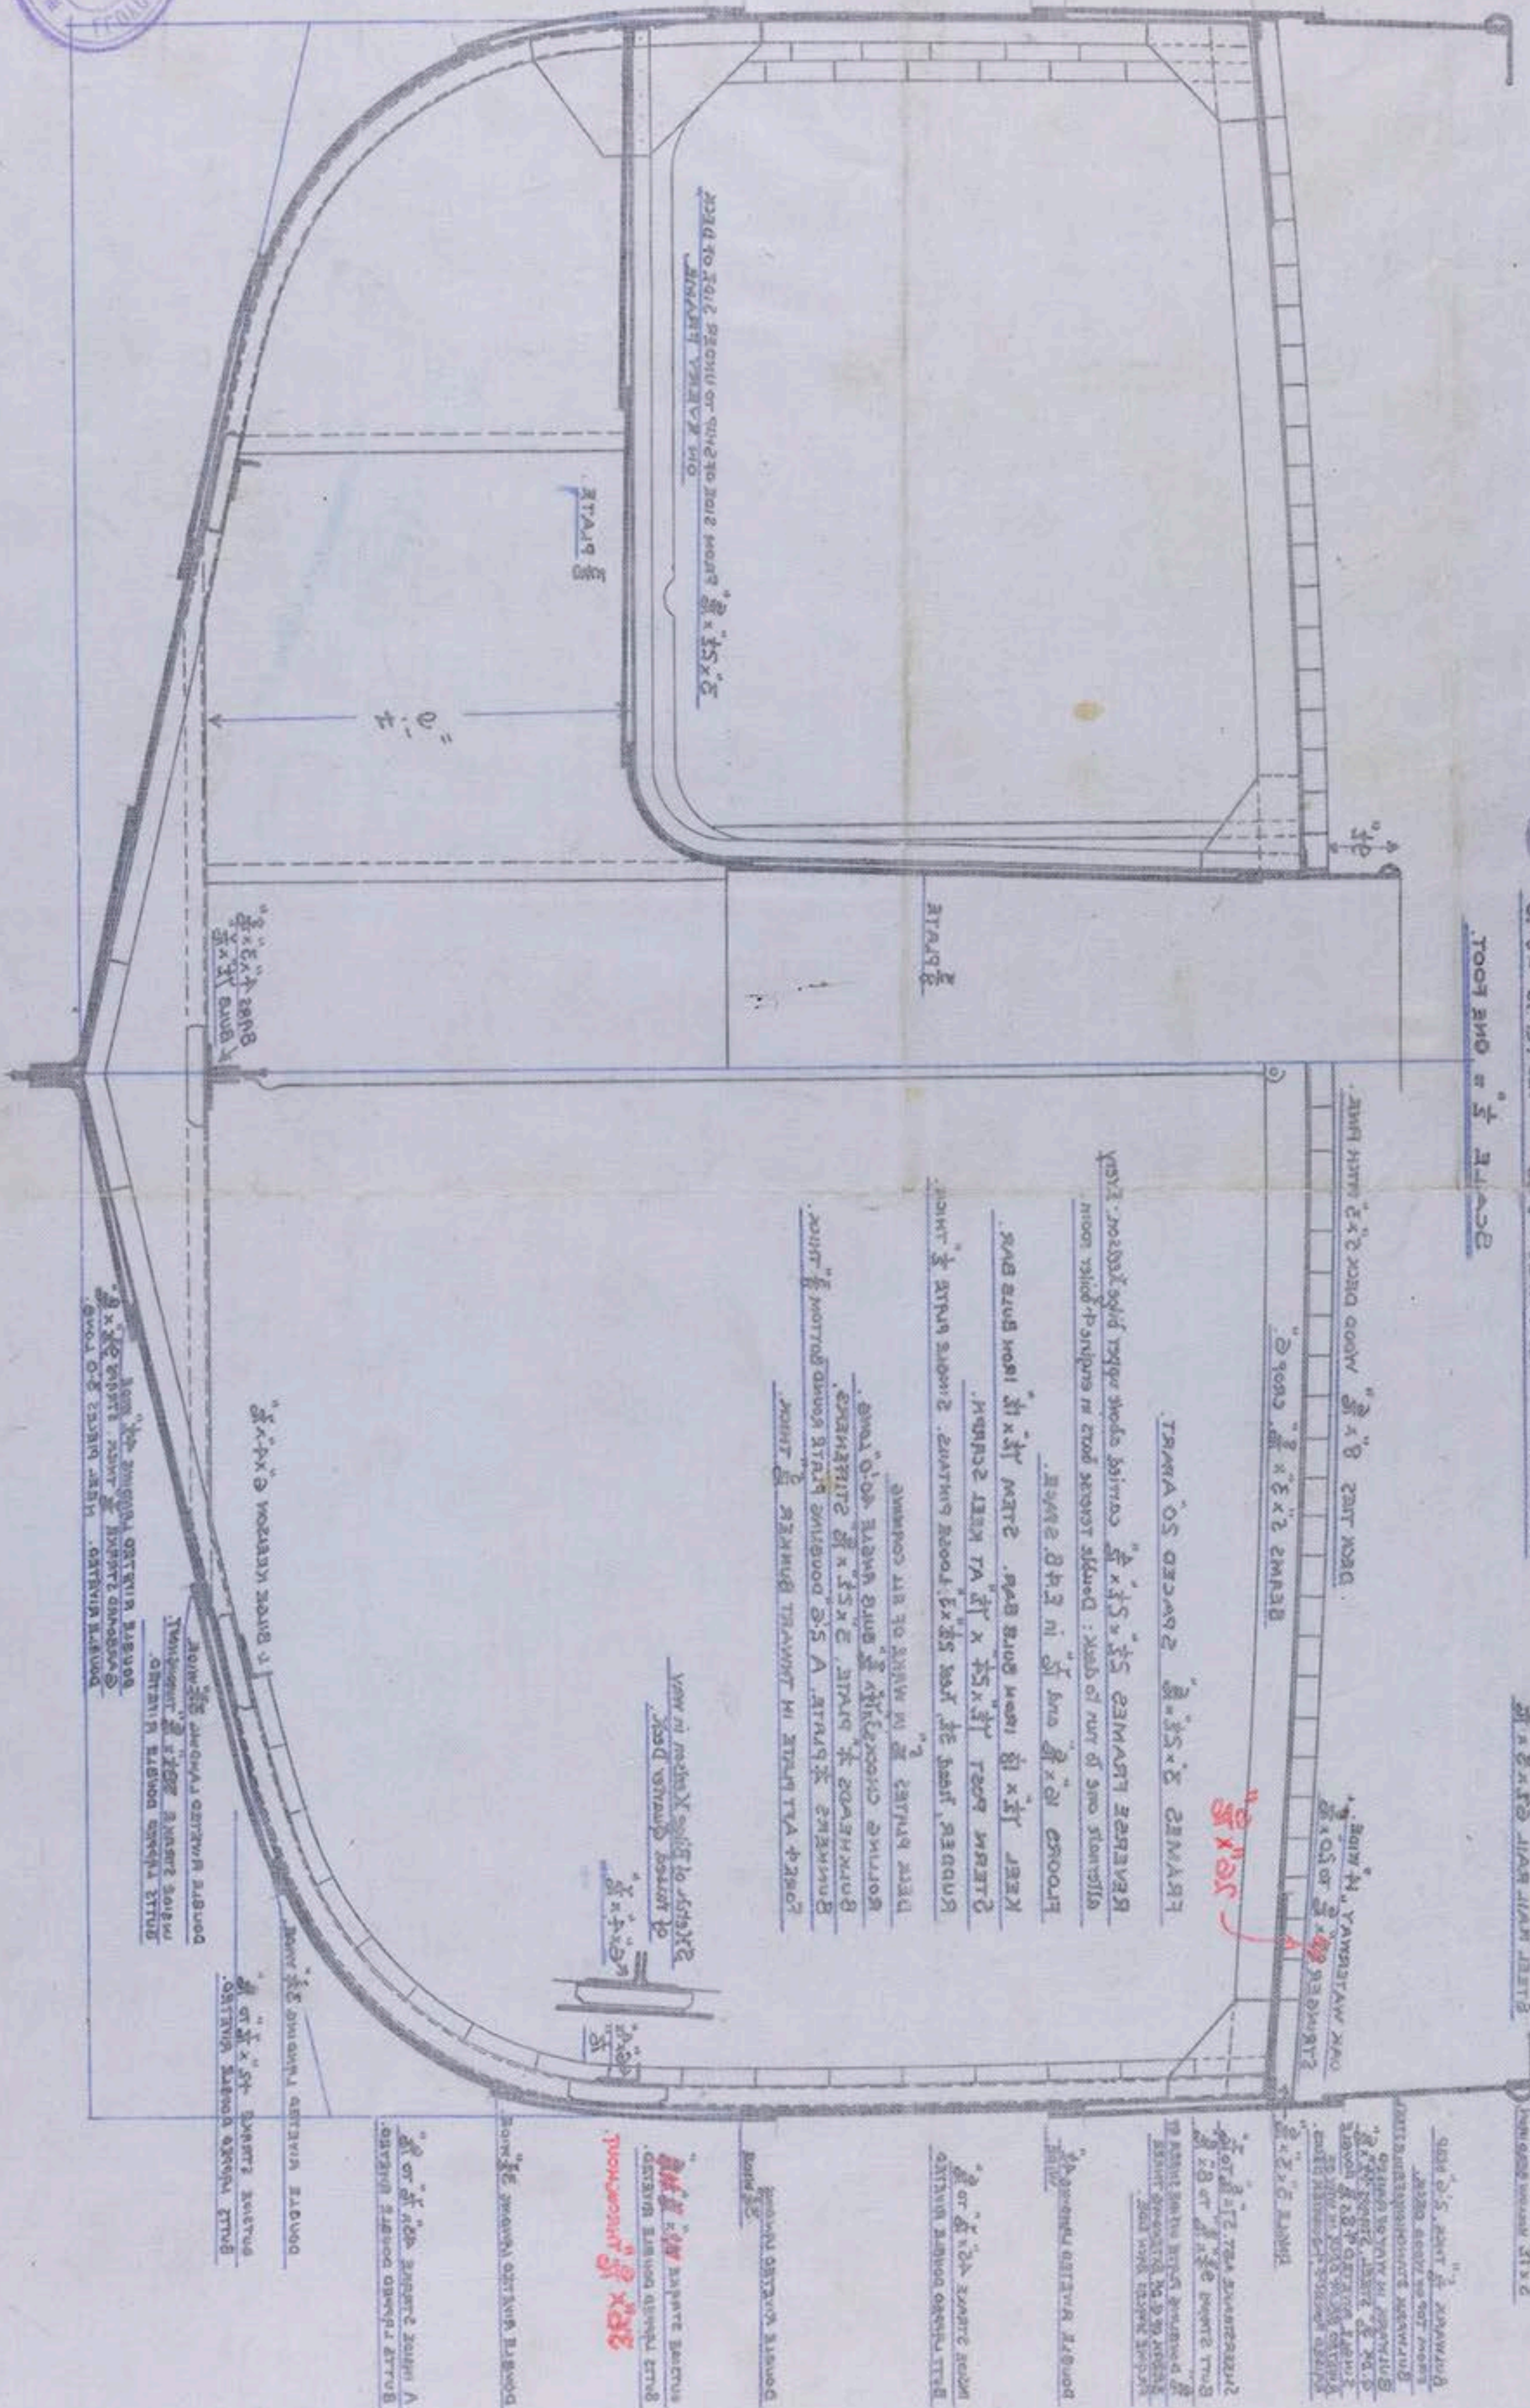

