

Received at



100

Lloyd's Register of British and Foreign Shipping.

(Report on Vessel No. _____ Port Hull)

No. 4920 SHIP FORGINGS ~~OR CASTINGS~~.

I have to report that the undermentioned Iron or Steel Forgings ~~or Castings~~,
manufactured by The Blaydon Forge Co
of Blaydon for the Vessel No. * 6, being built
by Messrs Hagerup D & S of Hull
have been inspected by me as set forth below, and found to be, so far as can be seen,
sound

The words FORGINGS or CASTINGS, IRON or STEEL, should be struck out as may be required.

* Fitted in 2 1/2 " keels" 18.9.0.




Mark on Forgings.

Lloyd's
No. 8131B
JB

John Craig
Newcastle
23.6.99

	STERN FRAME.	RUDDER FRAME.	STEM.
Material*	<u>Scrap</u>	<u>Scrap</u>	/
How made	<u>Forged</u>	<u>Forged</u>	
Dimensions	<u>6 - 2 1/2</u>	<u>3 3/4 - 2 1/4</u>	
Progress on Inspection	<u>Forged & Smithed</u>	<u>Forged & Smithed</u>	
Date when Inspected	<u>October 31 & November 25/98</u>	<u>April 7 & 22/99</u>	

SKETCHES OF FRAMES SHOWING POSITION AND DESCRIPTION OF WELDS OF FORGINGS, OR PARTICULARS OF TESTS APPLIED TO CASTINGS.

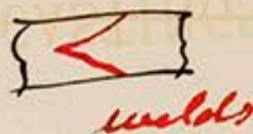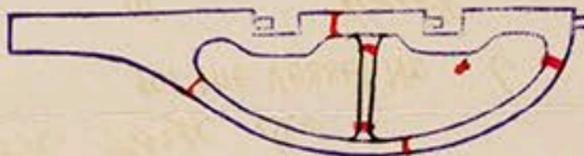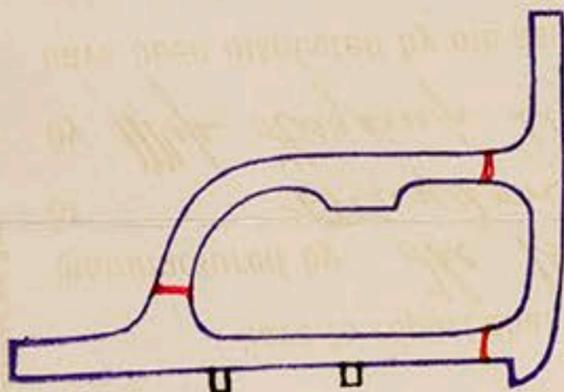

Fee (if any chargeable) £ : :

To be paid at _____

22 JUN 1899

* If of Iron, state whether scrap or puddled Iron.

