


LLOYD'S STAMP
LONDON
25 4. 98

Handwritten notes:
mainly 11' 11" 1/2
23' 11" 1/2
20' 11" 1/2
20' 11" 1/2

LLOYD'S STAMP
23 APR 1898
HULL DISTRICT
J. C.

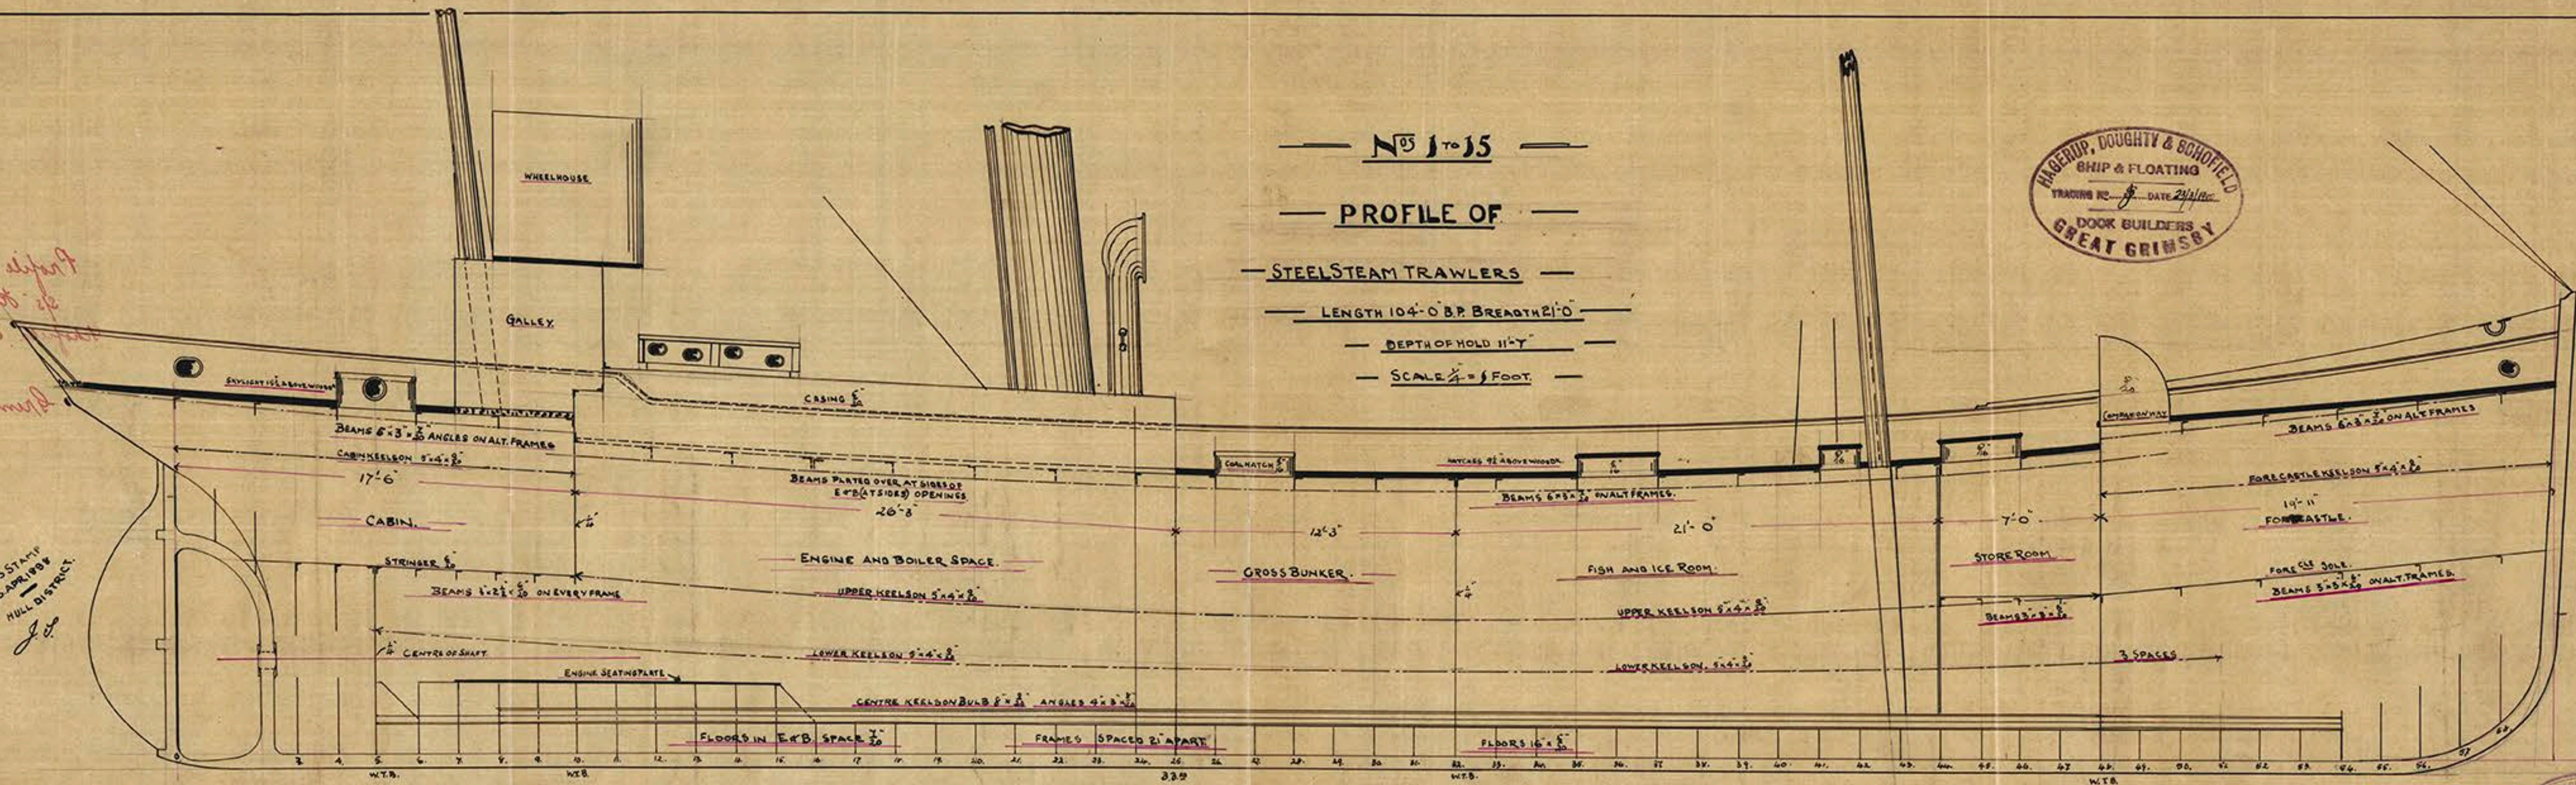

— N^o 1 to 15 —

— PROFILE OF —

— STEEL STEAM TRAWLERS —

— LENGTH 104'-0" B.P. BREADTH 21'-0" —

— DEPTH OF HOLD 11'-7" —


— SCALE 1/4" = 1 FOOT. —



Handwritten: J.H.B. 25/4/98



© 2018
Lloyd's Register
Foundation

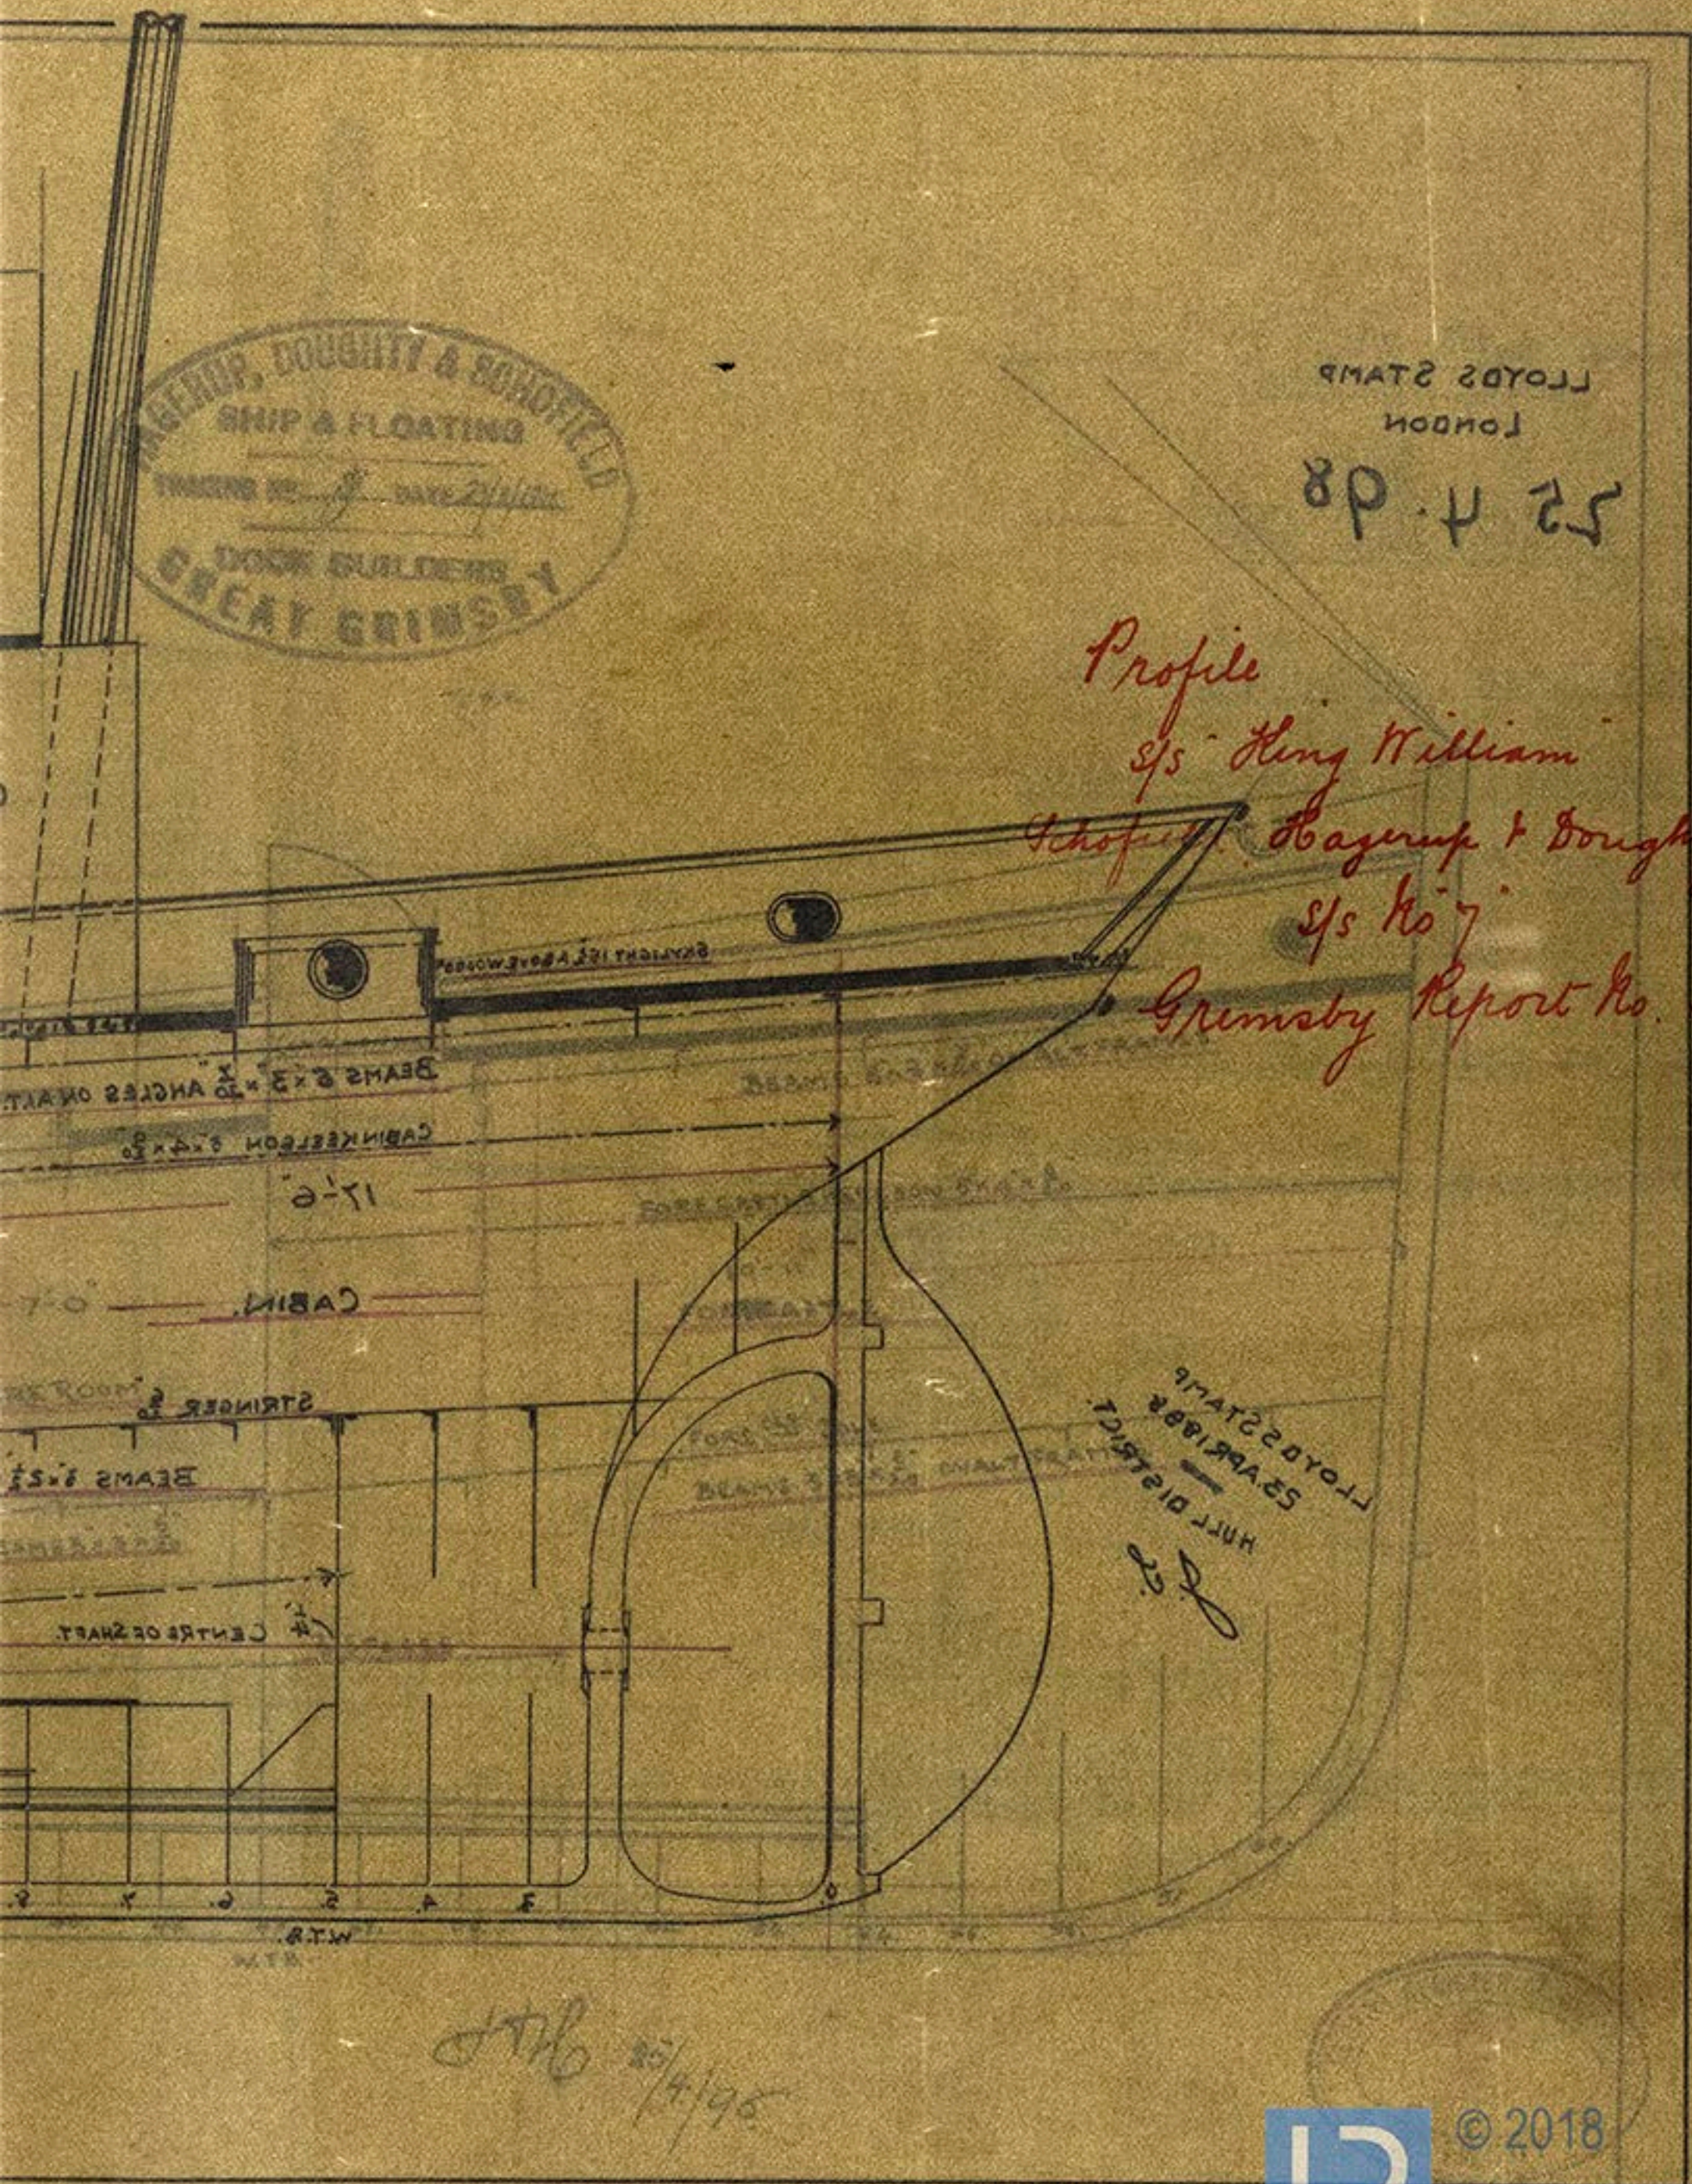

© 2018

Lloyd's Register
Foundation

GM 5357/87