

## Lloyd's Register of British and Foreign Shipping.

(Report on Vessel No. \_\_\_\_\_)

Port

*Hull*No. *4304*SHIP FORGINGS ~~OR CASTINGS~~.

I have to report that the undermentioned Iron or Steel Forgings ~~or Castings~~,  
 manufactured by *The Blaydon Forge Co*  
 of *Blaydon* for the Vessel No. *1*, being built  
 by *Messrs Hagerup Doughty & Co* of *Hull*  
 have been inspected by me as set forth below, and found to be, so far as can be seen,  
*Sound*

Mark on Forgings.



Lloyd's

No. *8128B**JB*

*John C Brair*  
*Newcastle*

	STERN FRAME.	RUDDER FRAME.	STEM.
Material* ...		<i>Scrap</i>	
How made ...		<i>Forged</i>	
Dimensions ...		<i>3 1/4 - 2 1/4 x 2 1/2</i>	
Progress on Inspection		<i>Forged &amp; Smithed</i>	
Date when Inspected		<i>June 9 to July 1/98</i>	

SKETCHES OF FRAMES SHOWING POSITION AND DESCRIPTION OF WELDS OF FORGINGS, OR PARTICULARS OF TESTS APPLIED TO CASTINGS.

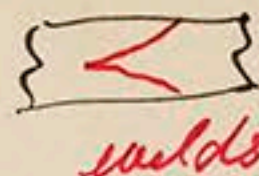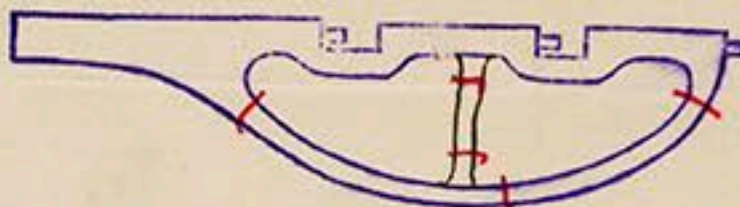

Fee (if any chargeable) £ : :

To be paid at \_\_\_\_\_

\* If of Iron, state whether scrap or puddled Iron.