

© 2018

Lloyd's Register  
Foundation




Profile

Schofield, Lagerup & Doughty, Ltd.

S/S No 10

S/S King Richard

Grimby Report No 613.

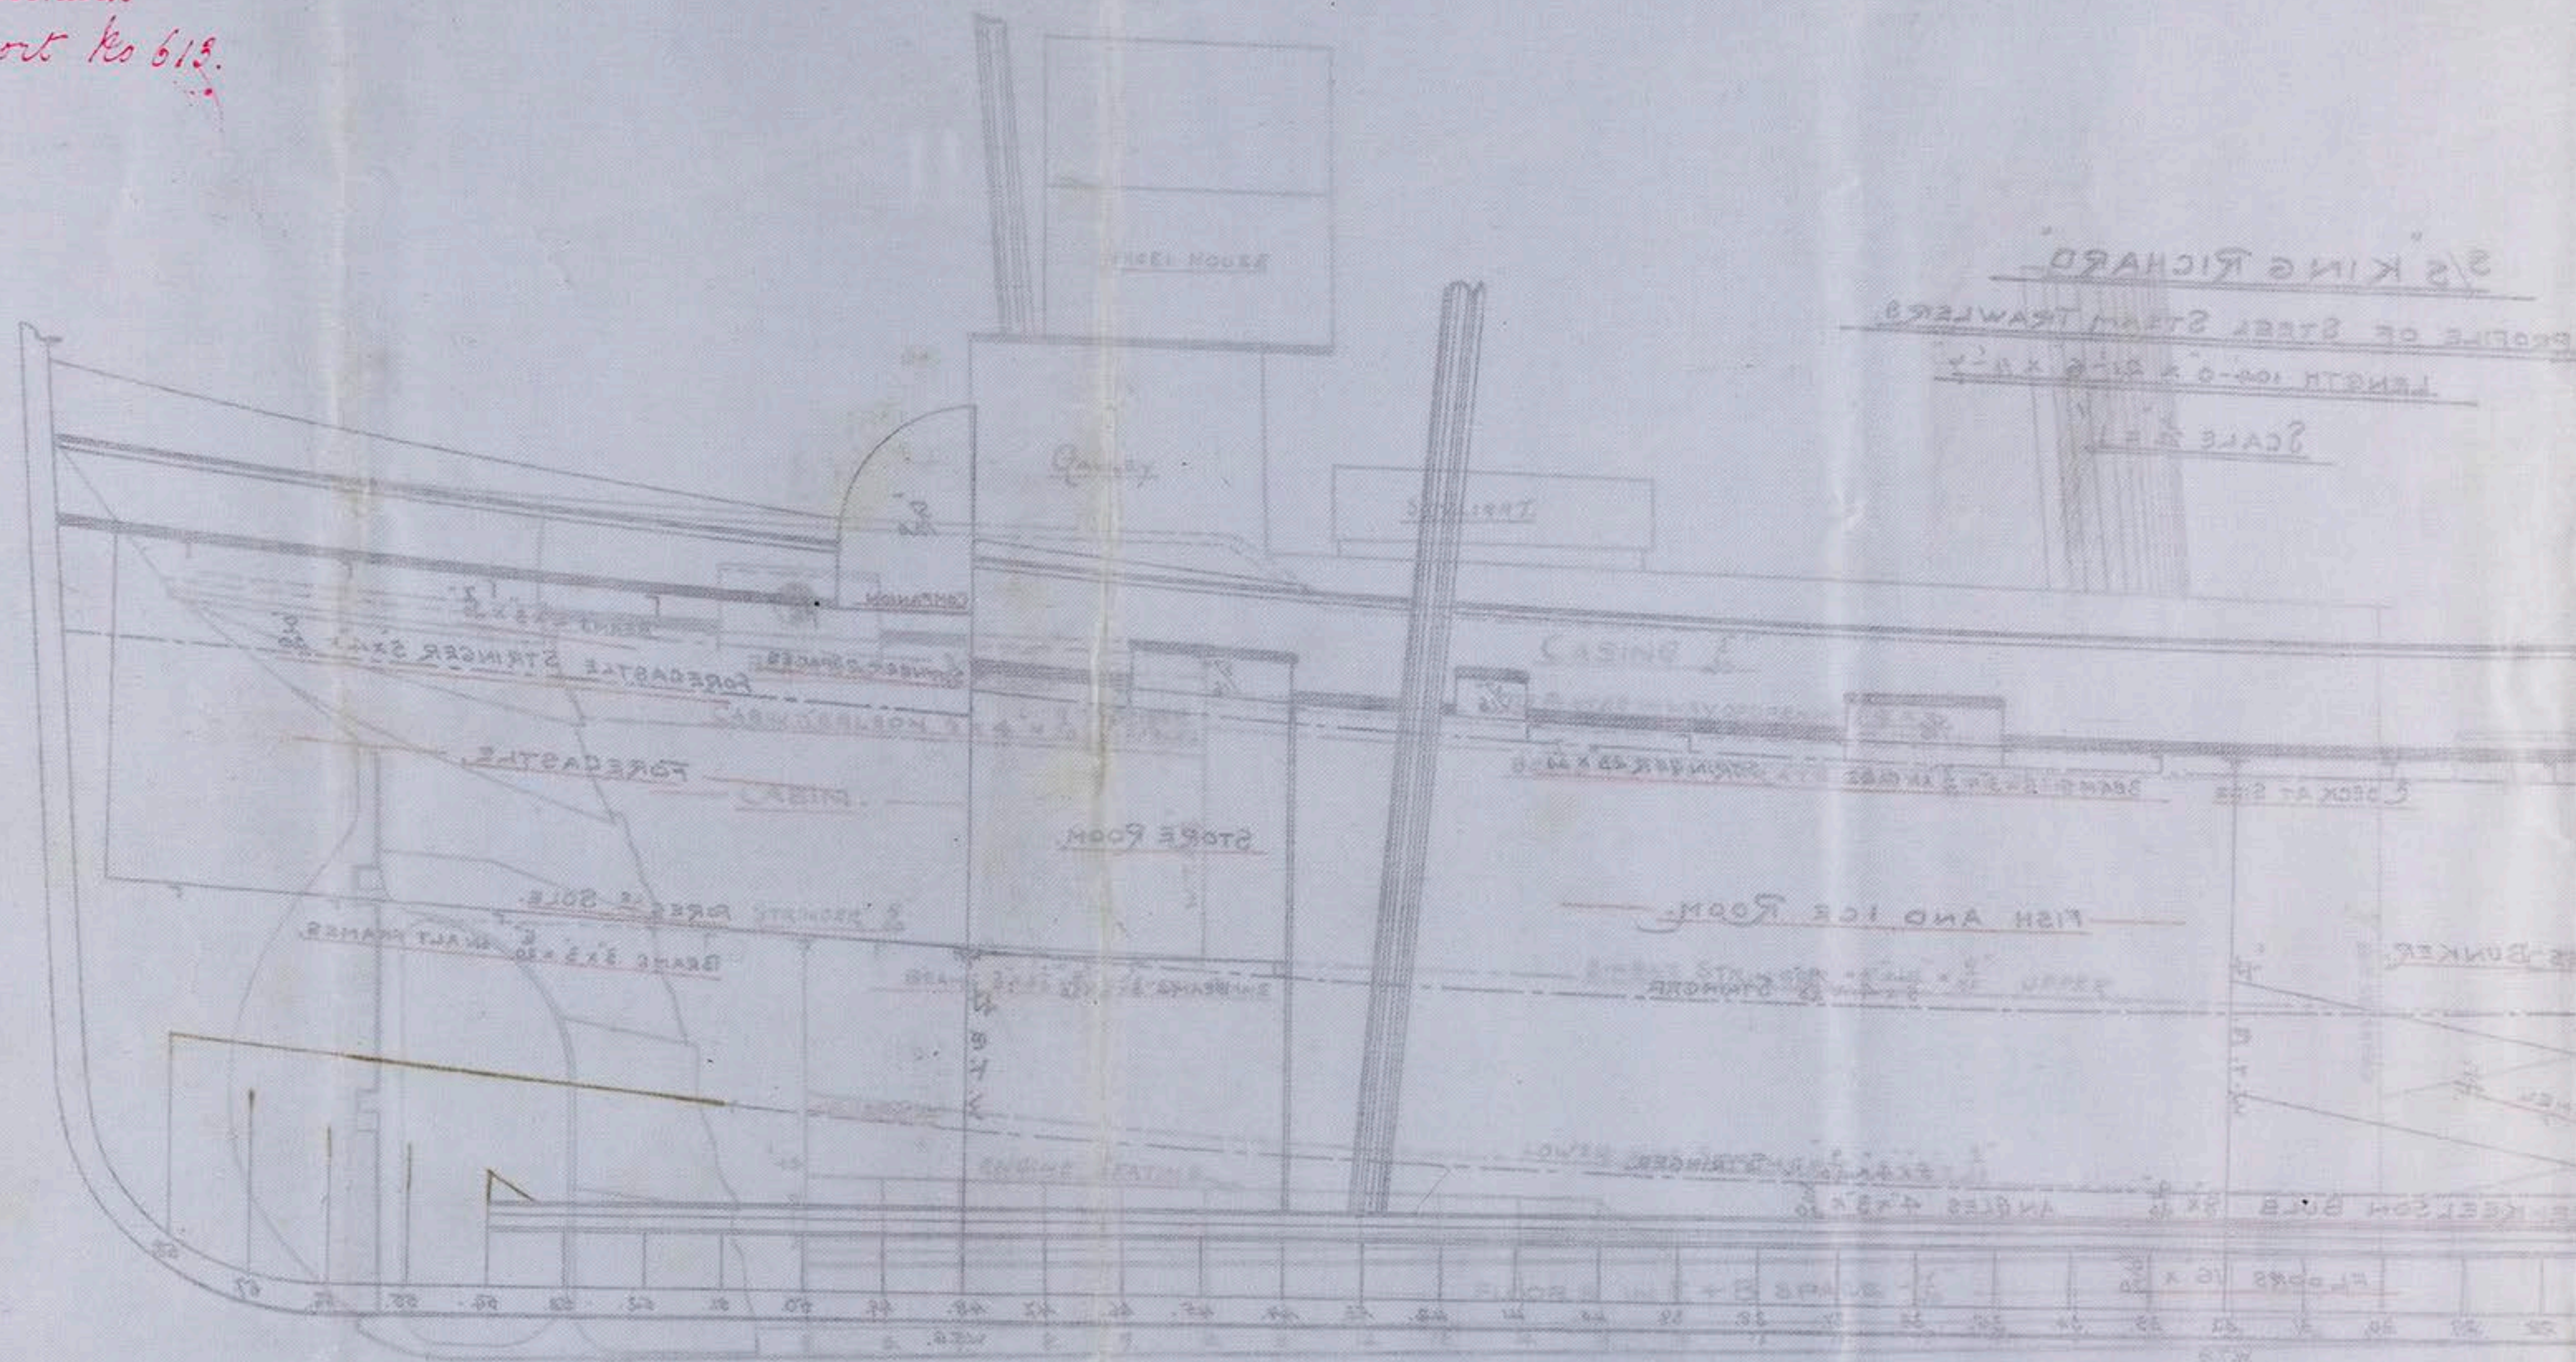

Approved  
22/11/40