

S/S KING

John.

Midship Section.

STEEL SCREW TRAWLERS

TO CLASS 100 A.L.LOYDS

SCALE $\frac{1}{2}$ = ONE FOOT.

DIMENSIONS


HALF MOULDED BREADTH	10.23
DEPTH FROM TOP OF KEEL	12.08
1/2 MIDSHIP GIRTH	17.23
LENGTH	103.75

NUMERALS

10.23 + 12.08 + 17.23	= 40.54
10.23 + 12.08 + 17.23 x 103.75	= 4156.27

PROPORTIONS

103.75 + 12.08	= 8.58
103.75 + 20.96	= 4.97

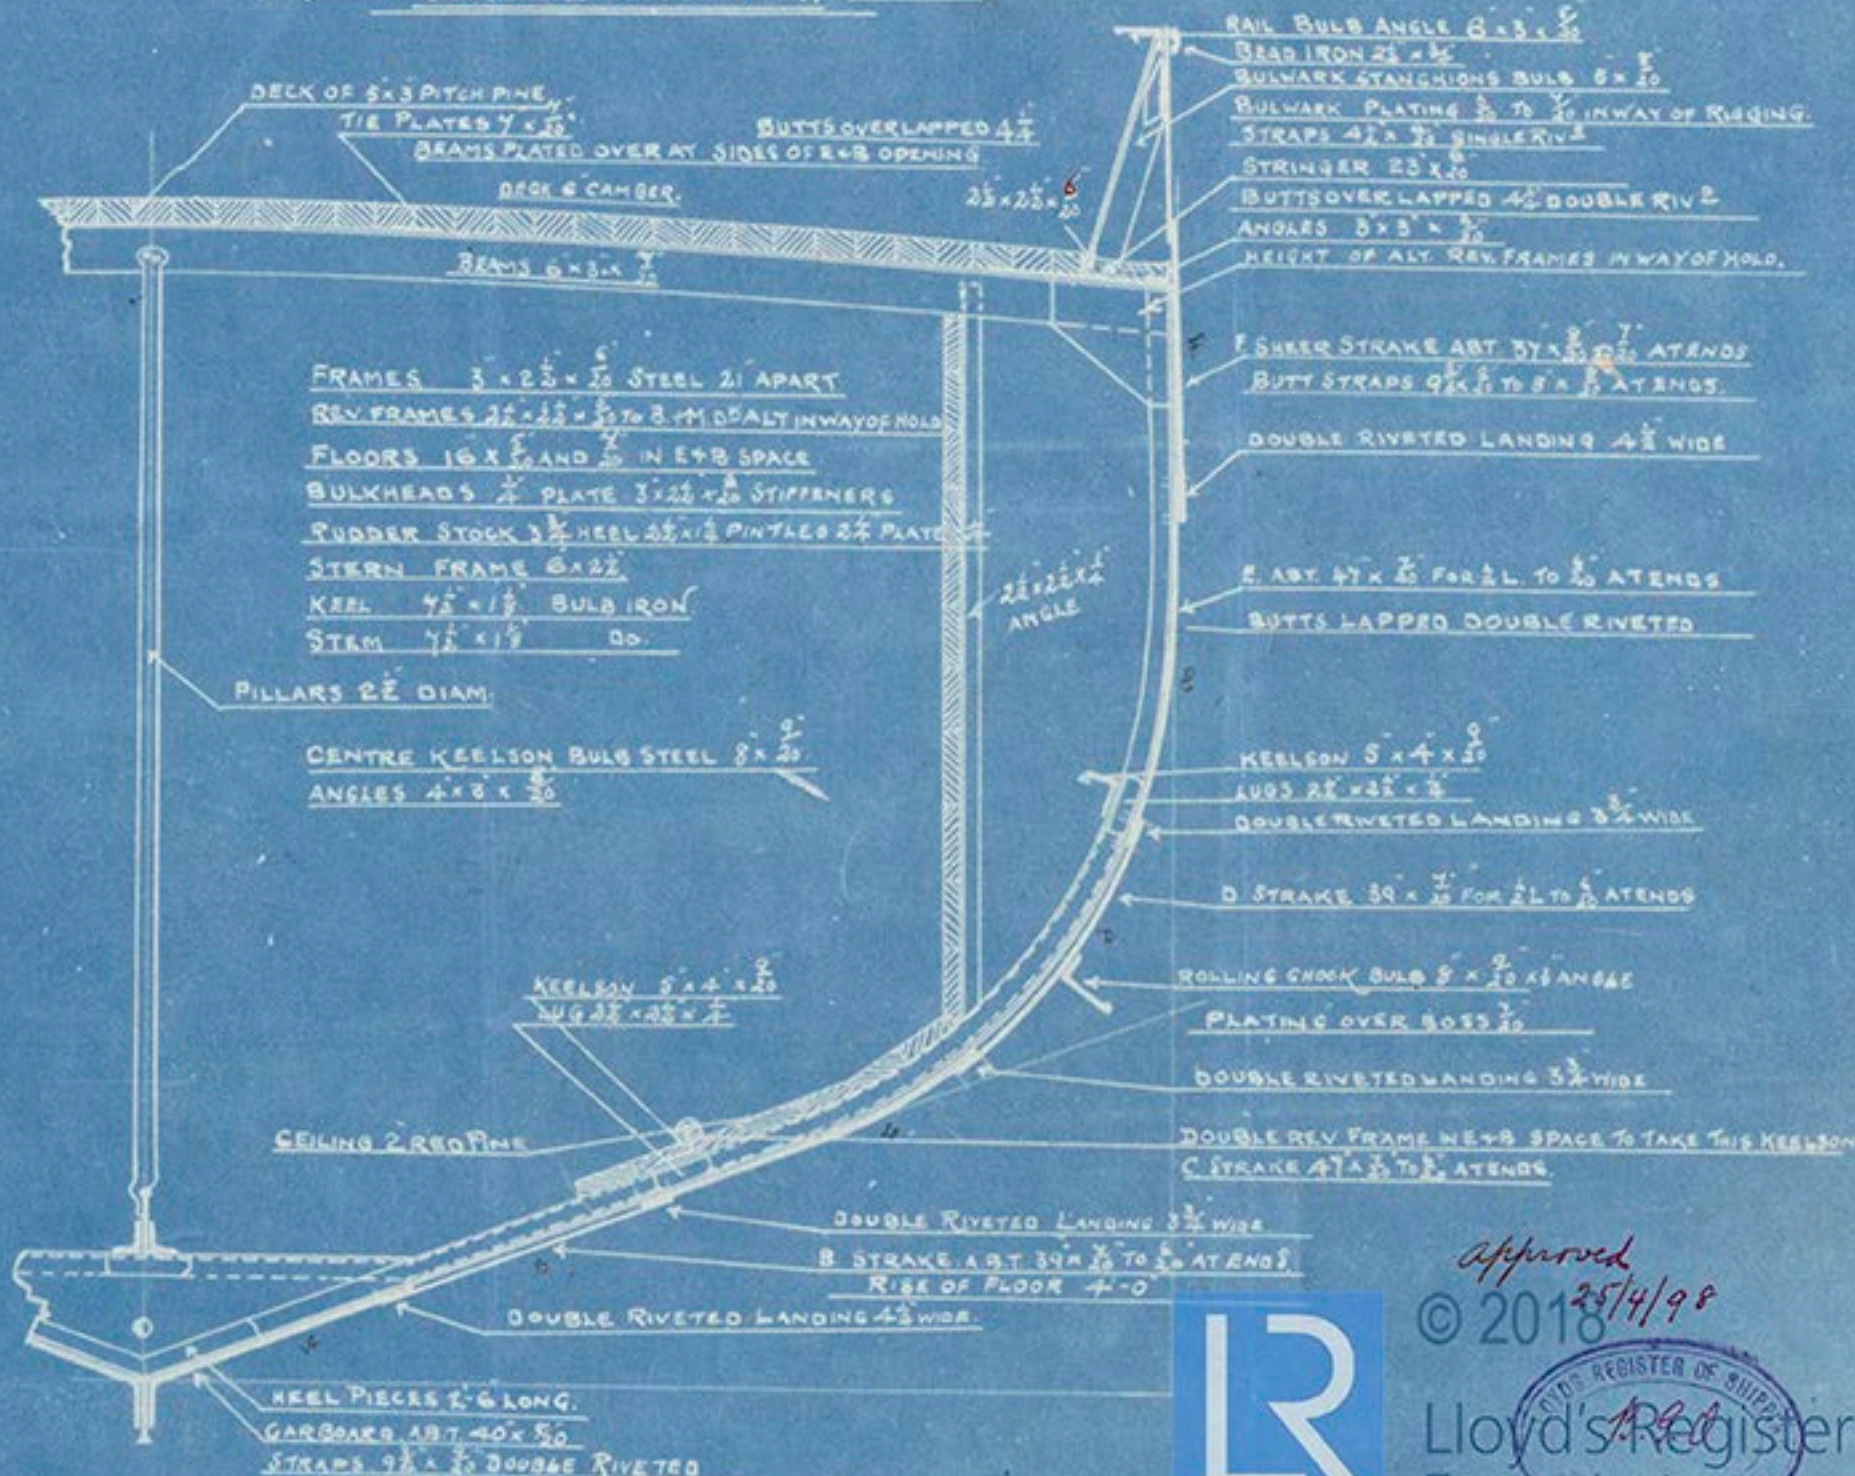

LR

Approved
25/4/98
© 2018

Lloyd's Register
Foundation

Midship Section

s/s "King John"

Schofield Hagerup & Doughty L^d

s/s "No 11"

Grimaby Report No 653