


22/1/09

STEEL BOILER 165 WP Nº A 15
TOLLØYD S




JANUARY 16TH 1909



Double Buff Straps
outside/inside $\frac{13}{16}$ thick
85.25% Plate } WP 169.7 lbs
106.0% Kwet }

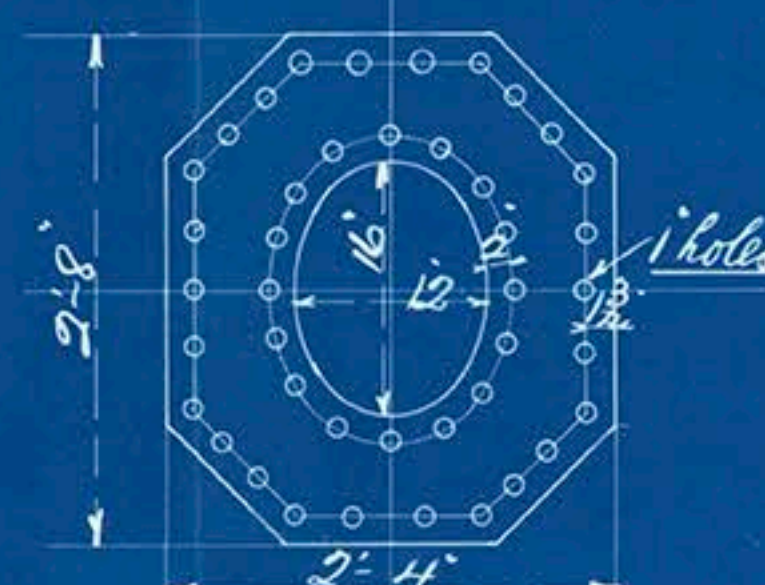Manhole Doubling Plate $\frac{13}{16}$ thick

Heating Surface	
Tubes	531 Sq. feet
Swiracles	54.7 "
Combustion Chambers	90 "
Tube plates	33 "
Total Heating Surface	718.7 "
Grate area	28 Sq. feet

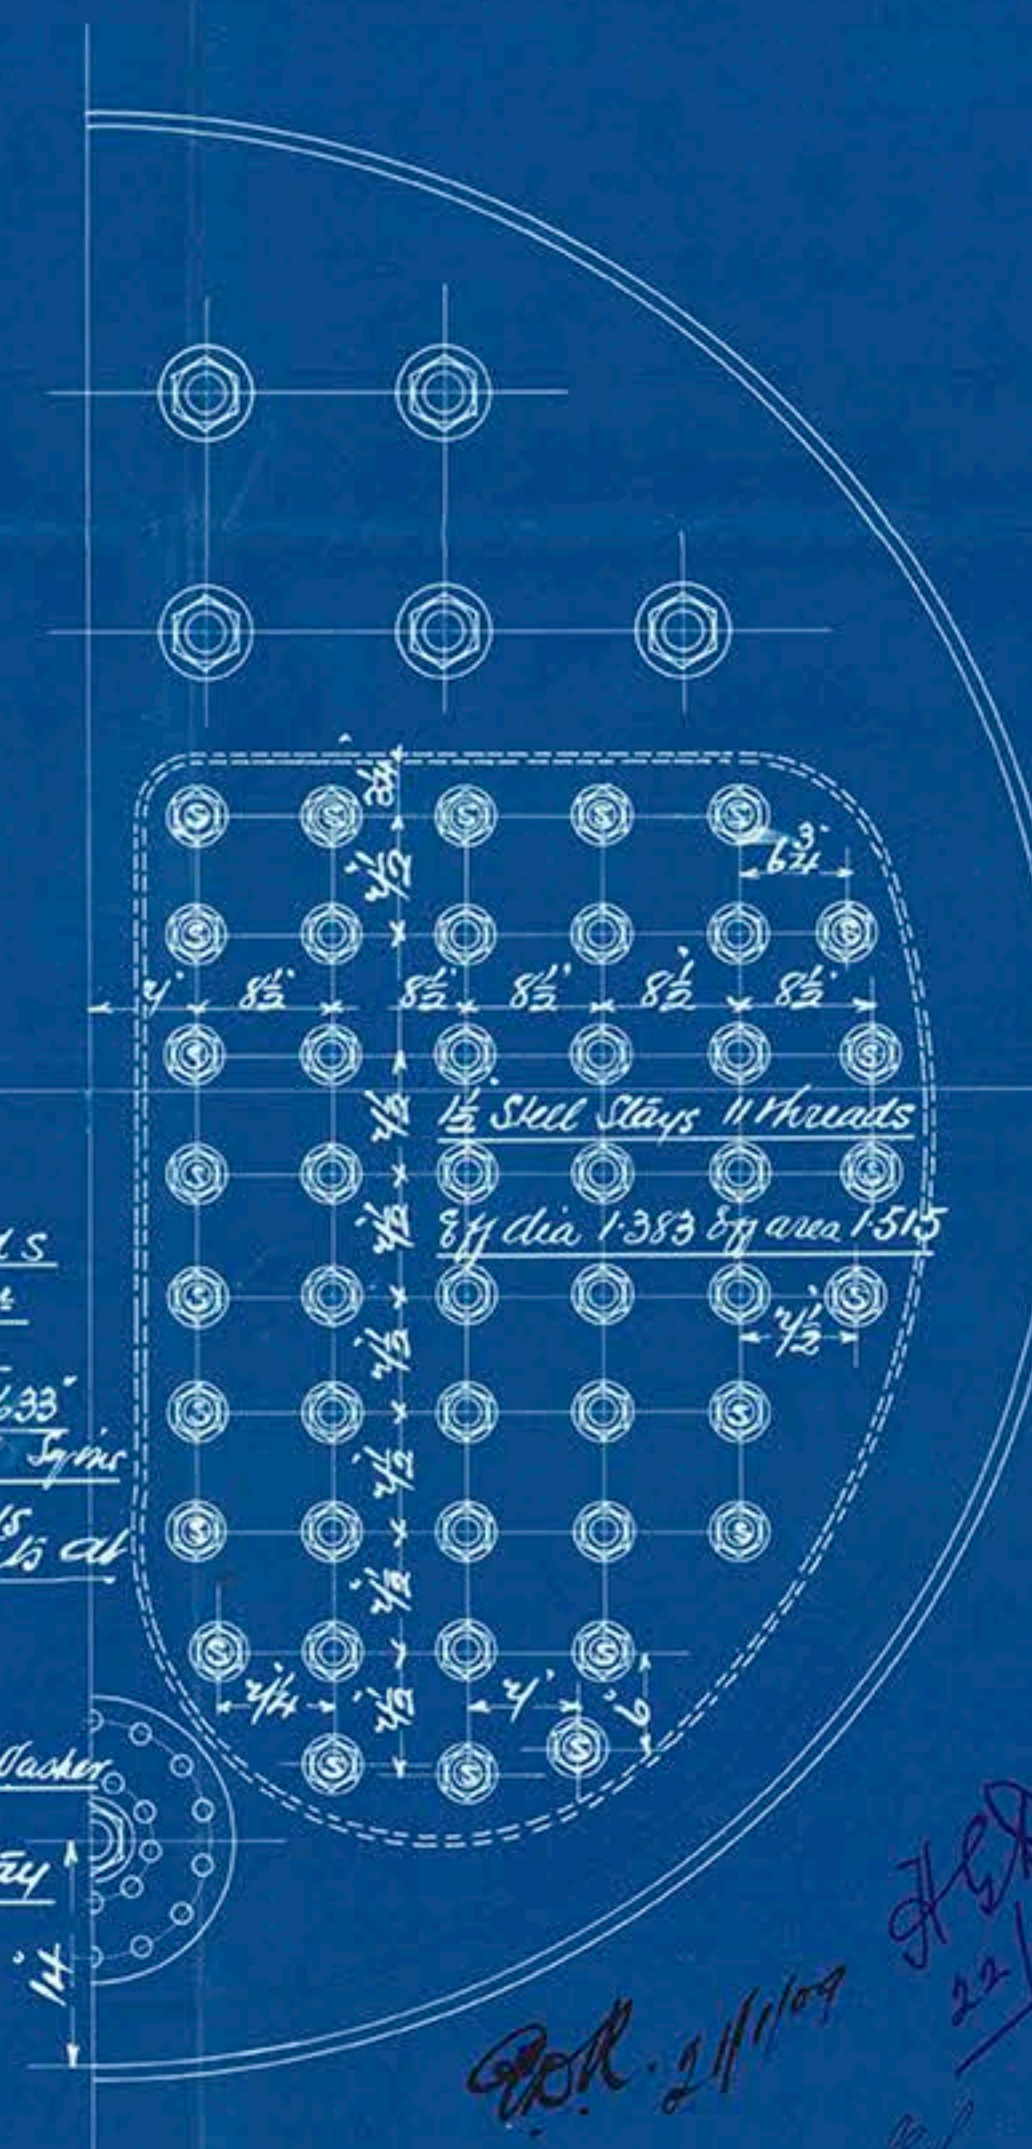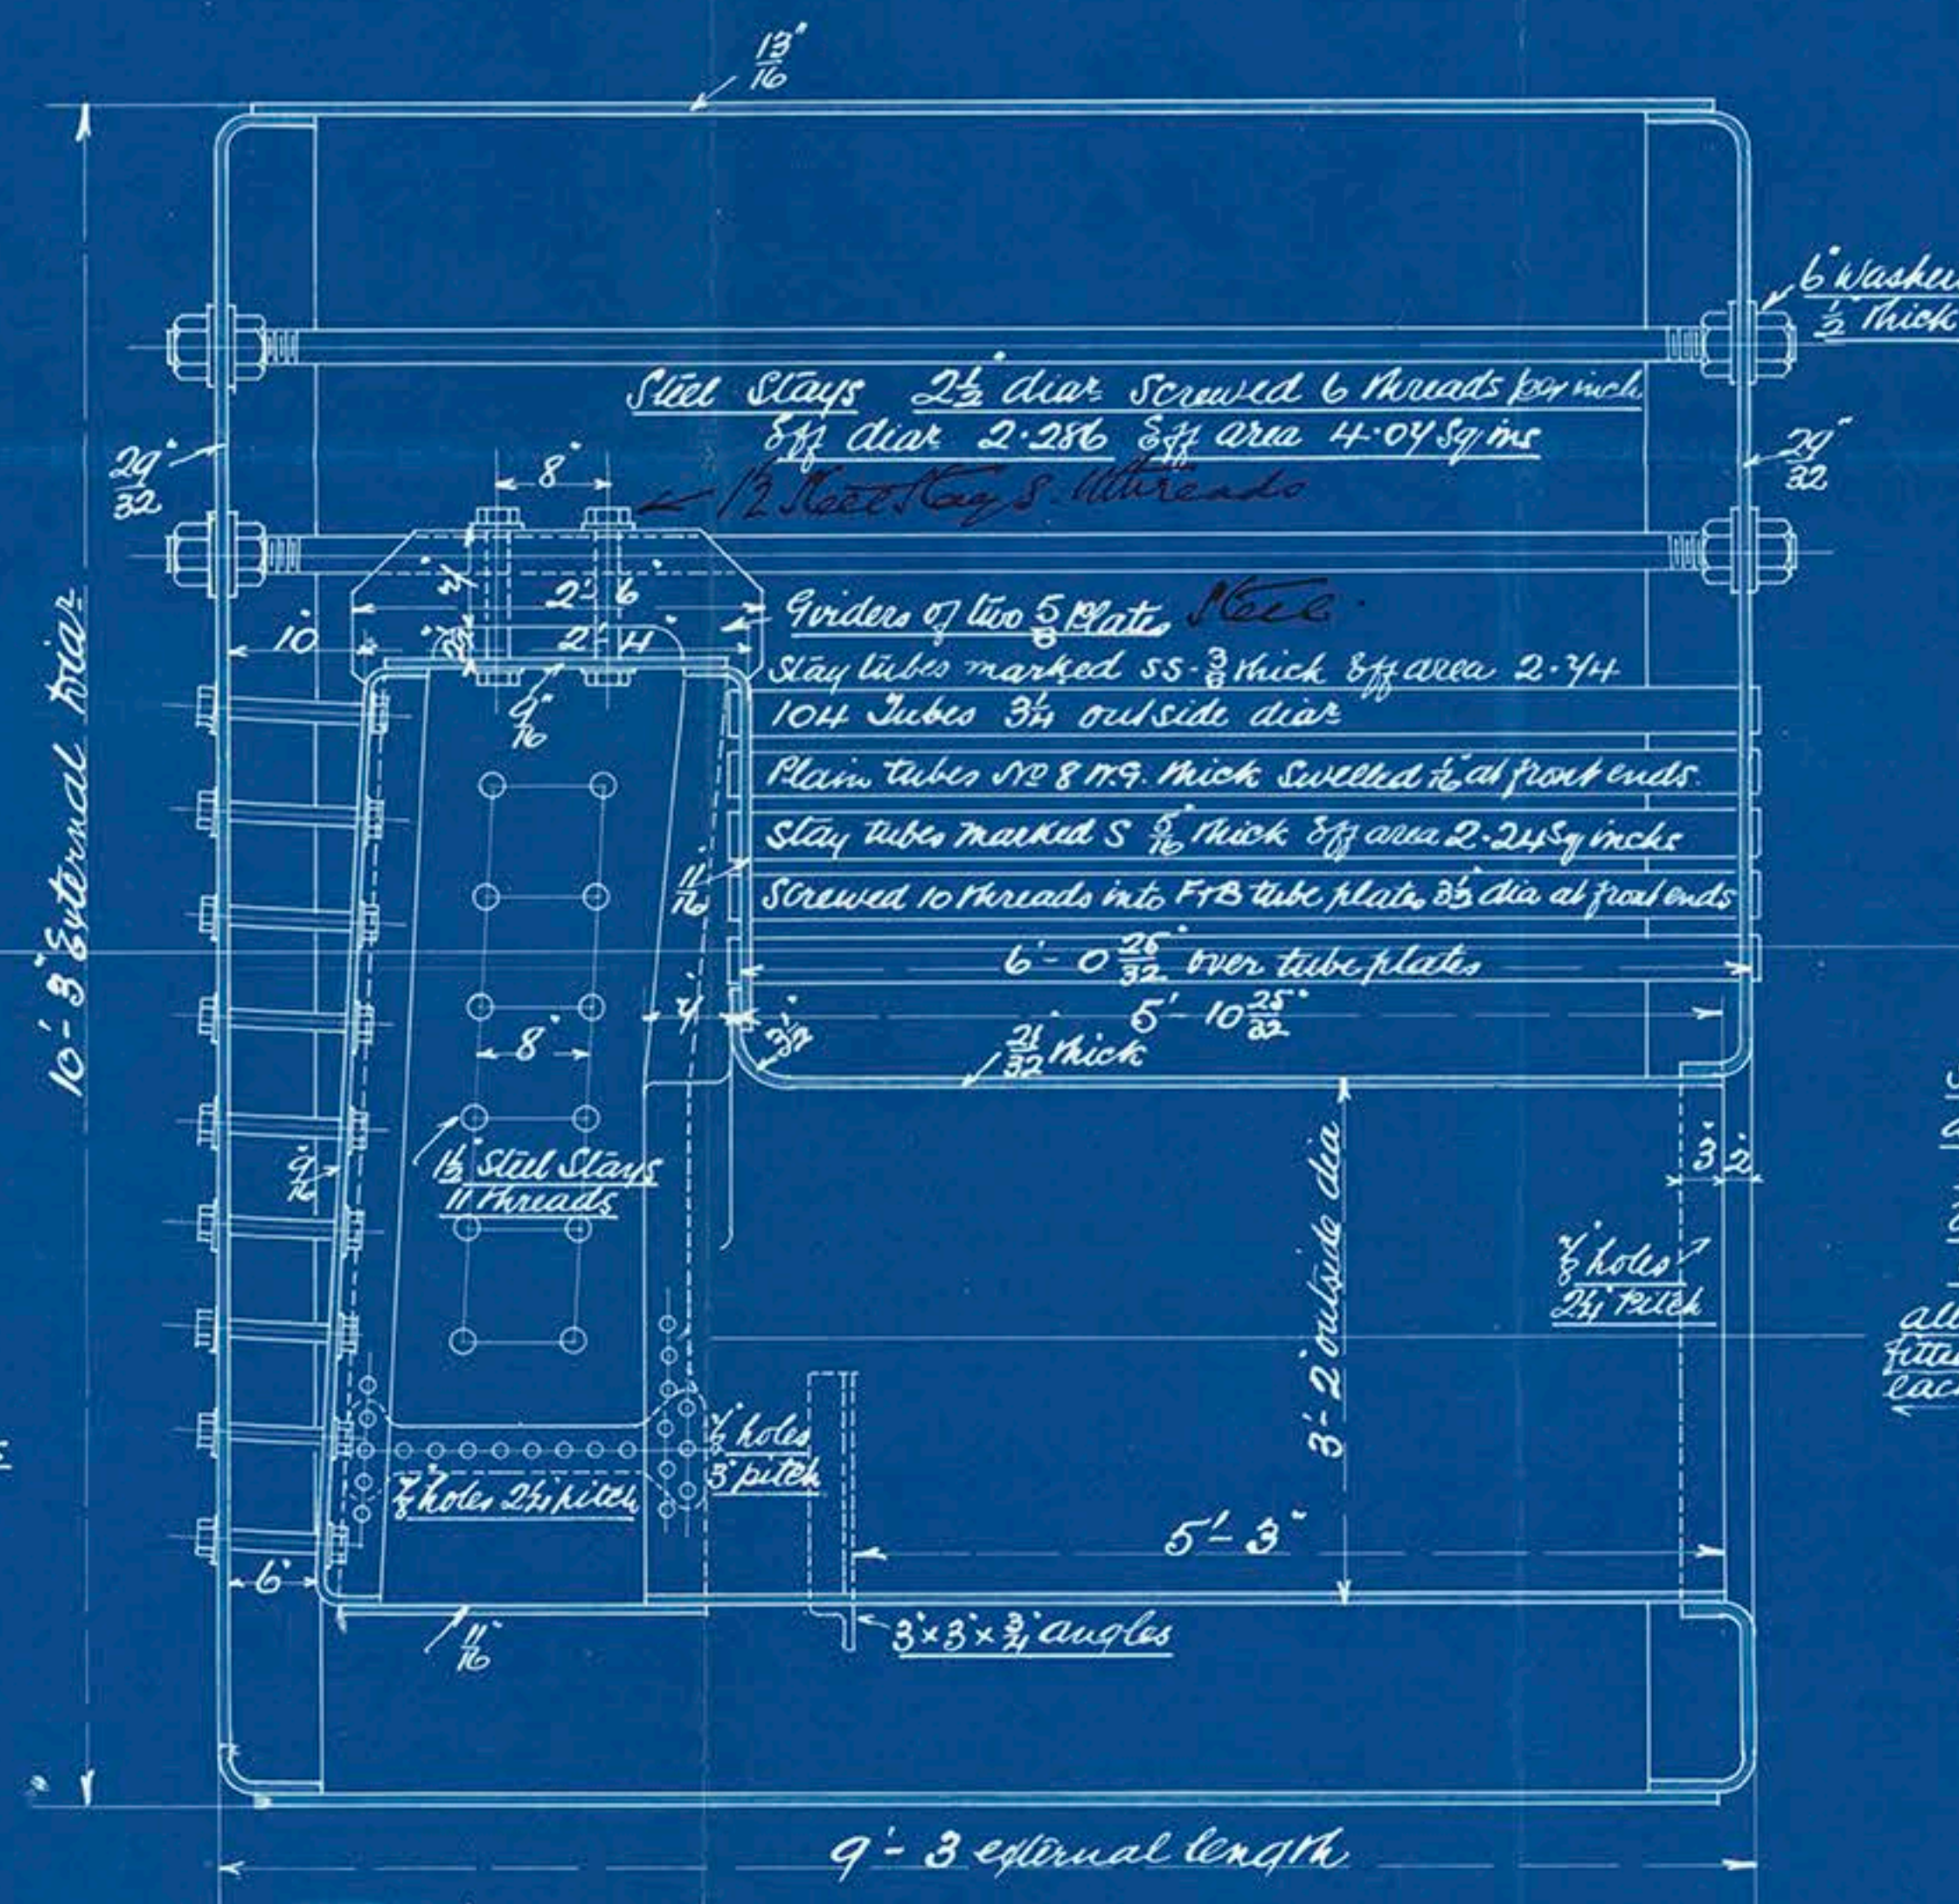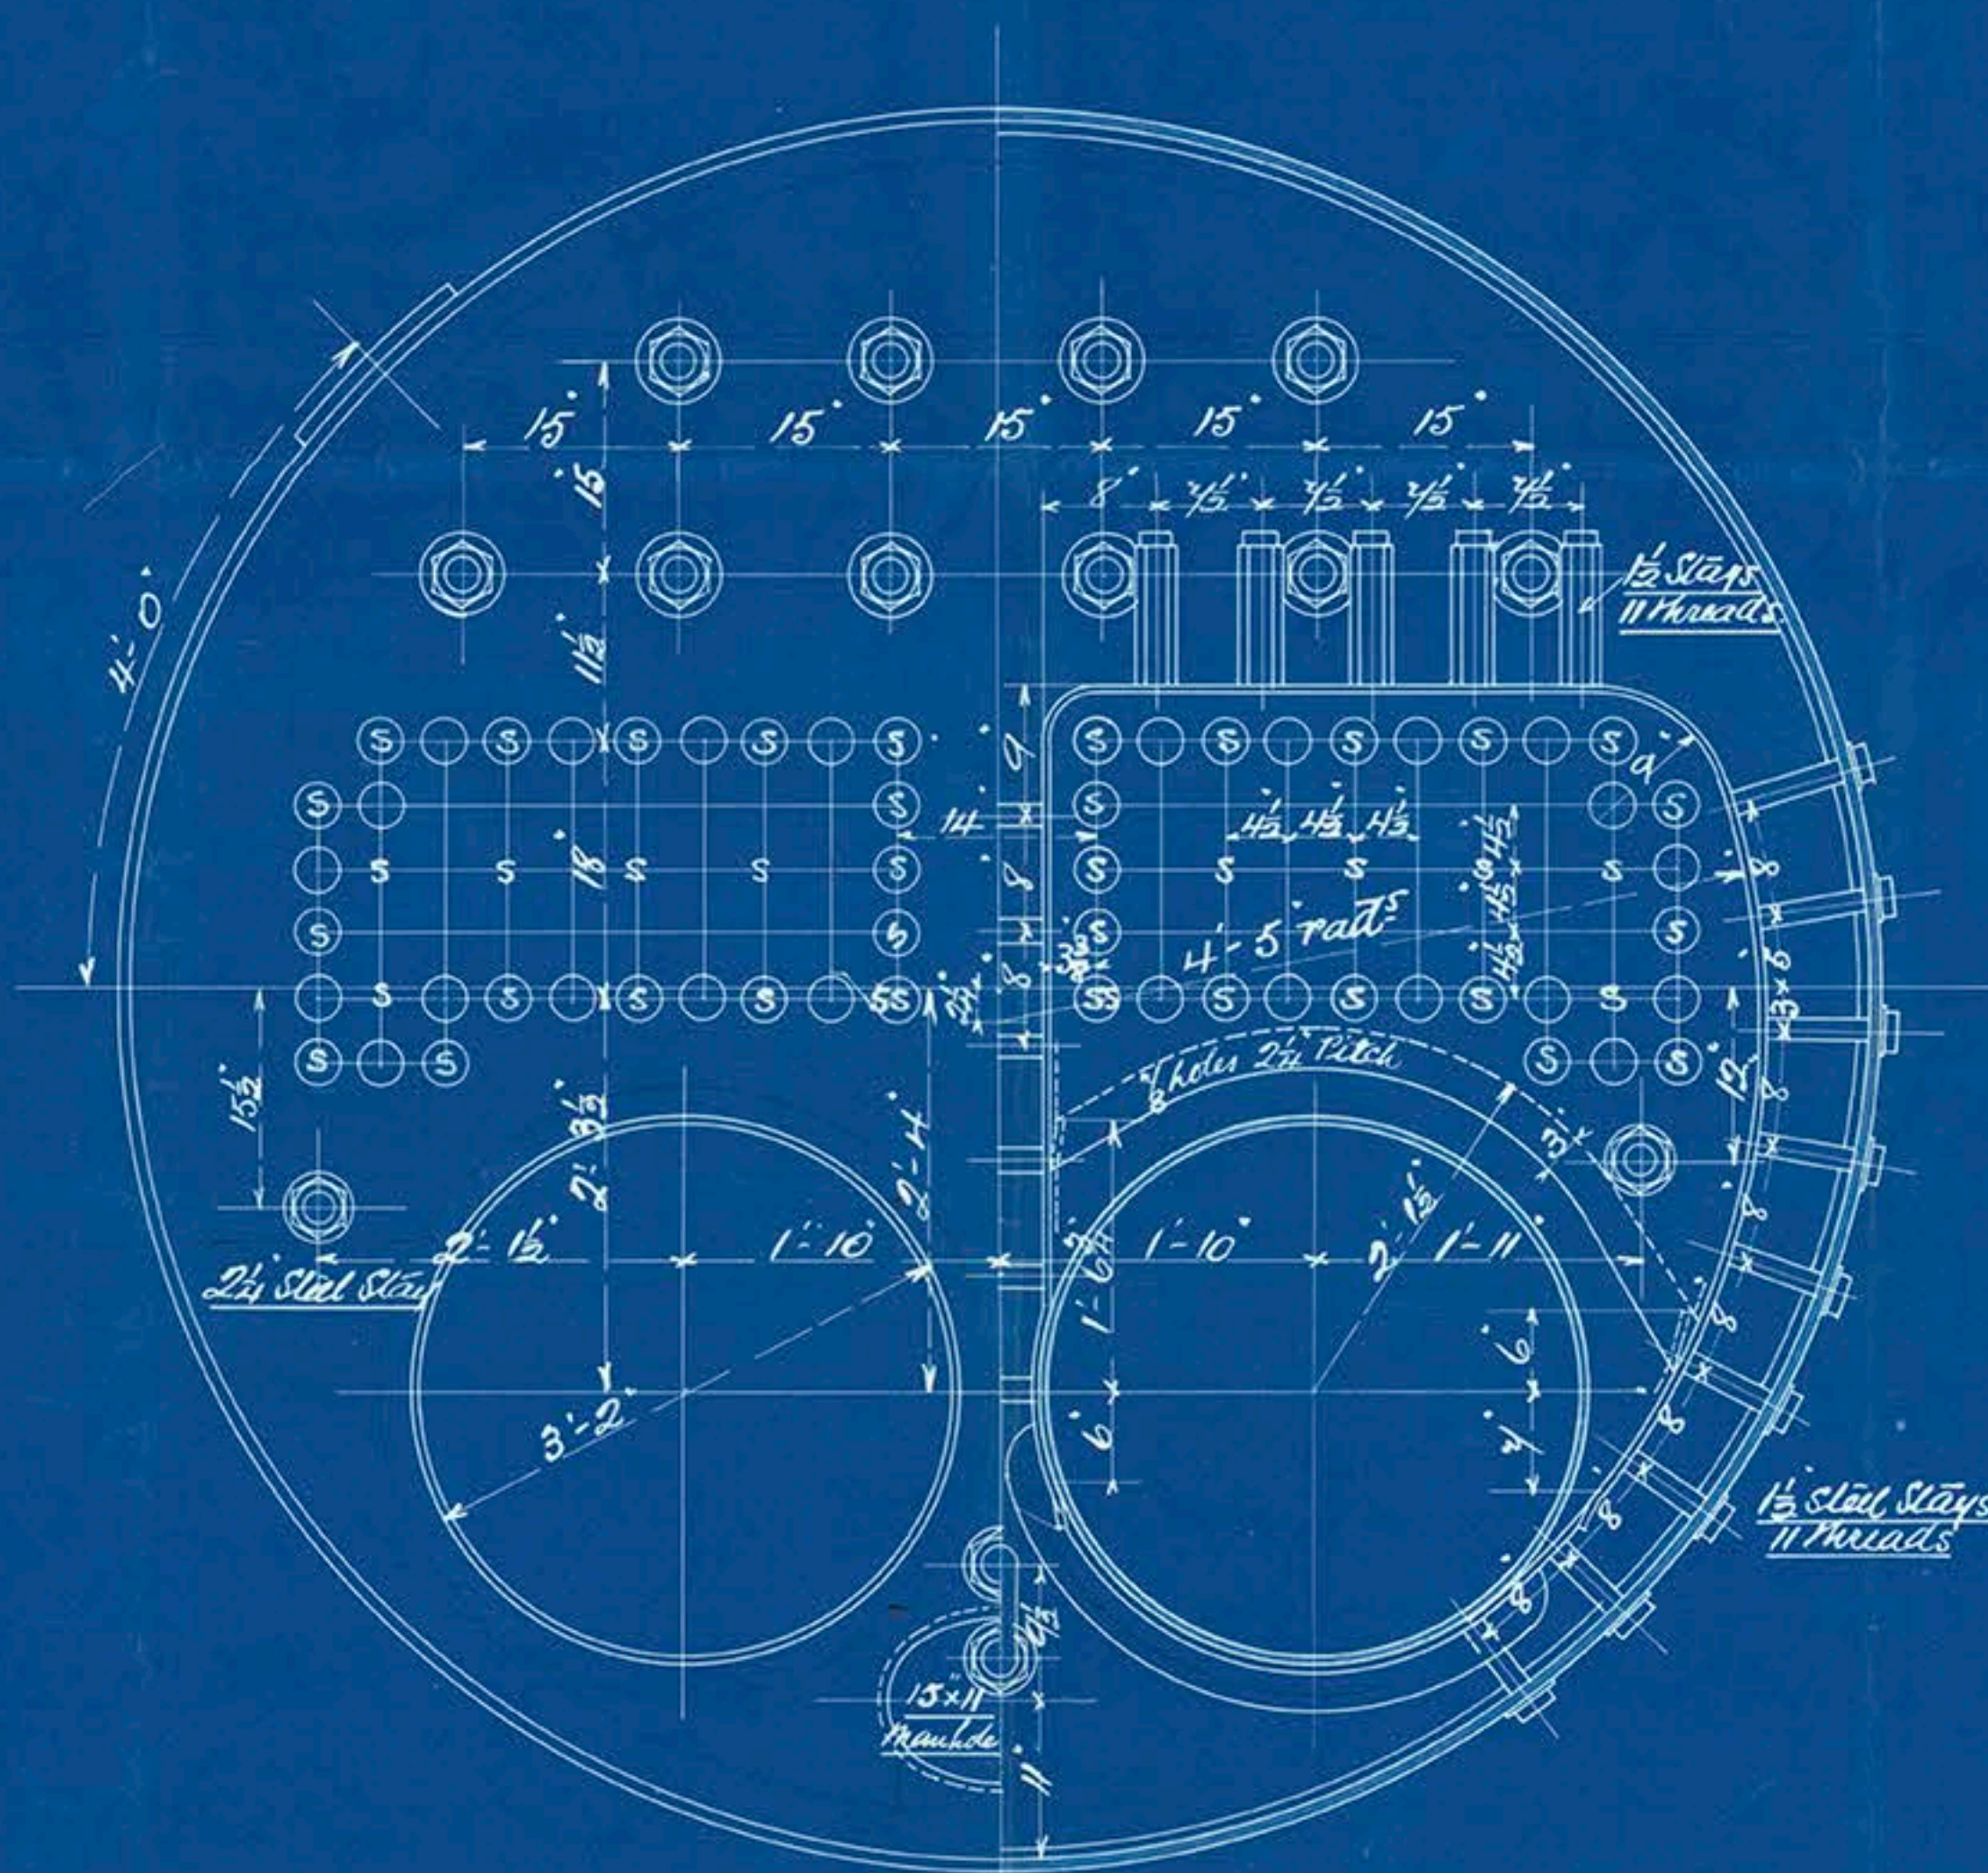

Nº A 15

St. Central Co. of Eng^l
Steel boiler for
165 lbs W.P.

Boiler A15.

Ins. Rept. No. 5879.



© 2018

Lloyd's Register
Foundation

GM5358/209