


6.3.74

(B)

SS No 10

Building at Troon

Dec 5/2/74

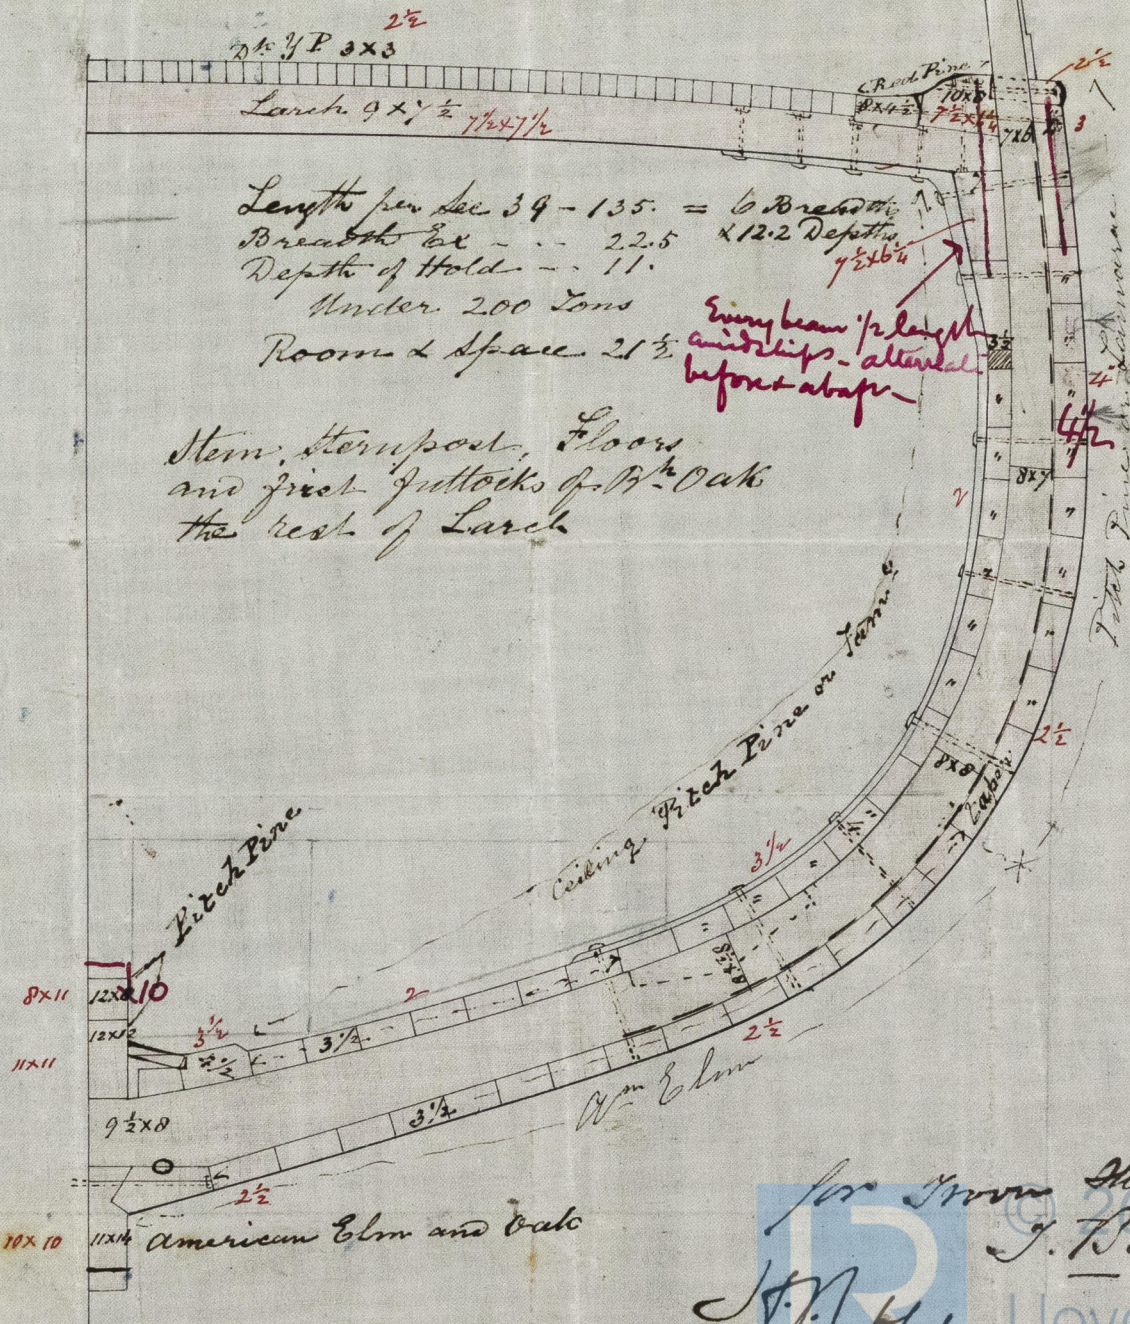

for Troon Shipbuilding Co
J.R.D.
J.R.D. 6/2/74

Lloyd's Register
Foundation

GRK296-0064