




6.10.77

Rec 4/10/77  
H


St. Mary of Campbelltown  
Greenock Report  
N<sup>o</sup> 4/404.

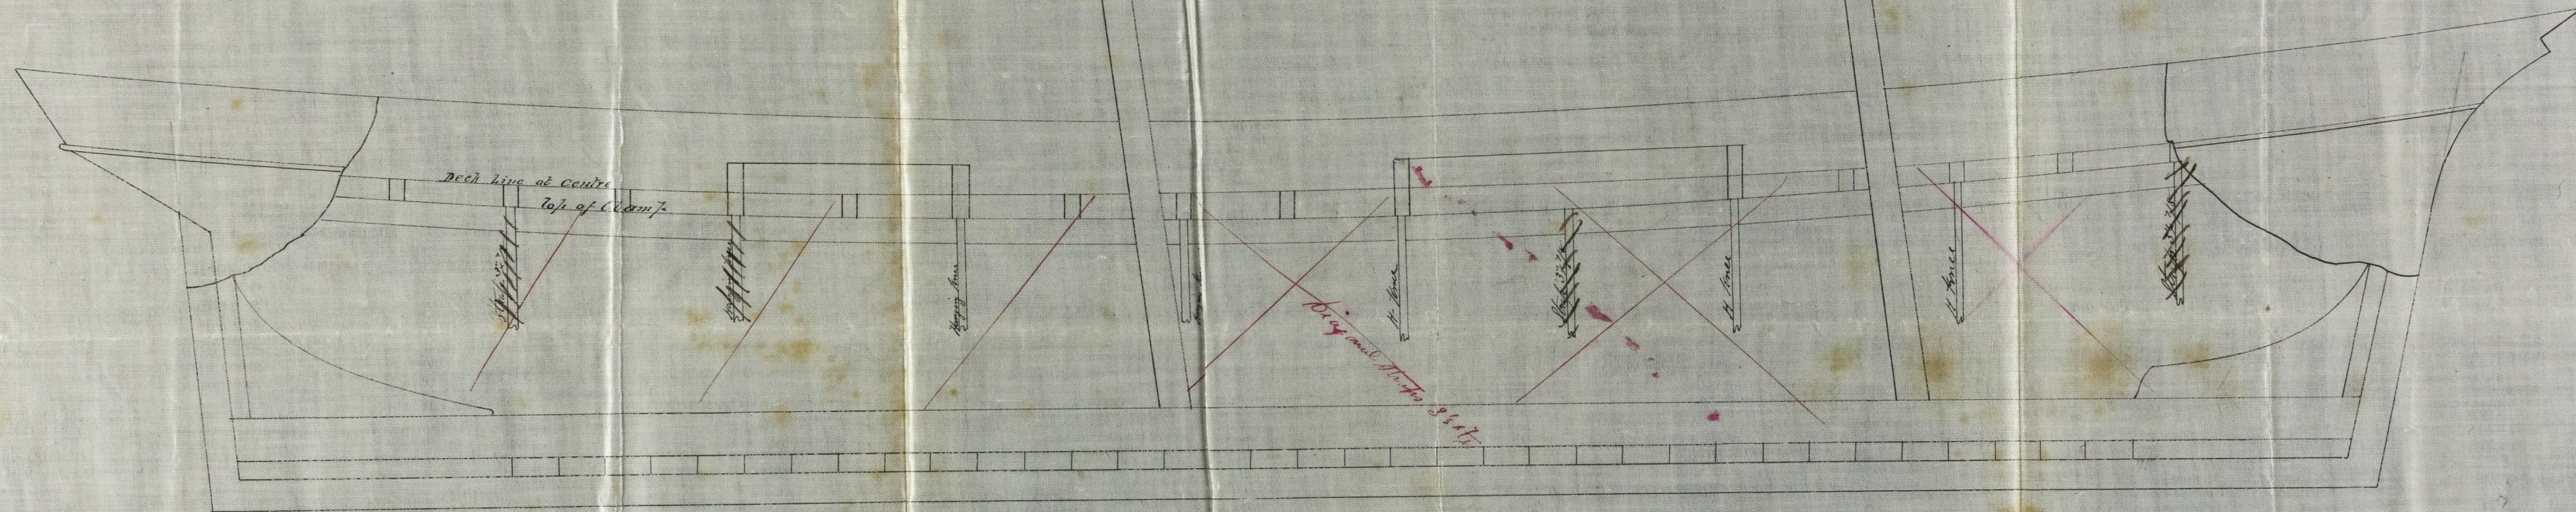

Campbelltown Shipbuilding Coy  
Oct 1<sup>st</sup> 1877

Wood Schooner 18<sup>th</sup>  
Length keel 18-0" x 22-0" 9' 1" wide  
Scale 1/4" = 1 foot

W.D.  
6/10/77

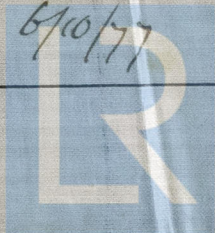

© 2019

Lloyd's Register  
Foundation