

N^o 149

Three Decked. Rule

S. S. James Watt
Greenock
Report
N^o 4940.

258.6 x 35.8 x 24.5

7.22 Breadths + 10.5 Depths.

ROBERT DUNCAN & CO

SHIPBUILDERS

PORT GLASGOW

2/3/80.

$$\frac{1}{2} G = 36.9$$

$$\frac{1}{2} B = 17.9$$

$$D = 24.5$$

$$\text{less } 79.3$$

$$72.3 = 1^{\text{st}} \text{ numeral.}$$

$$258.6$$


$$433.8$$

$$578.4$$

$$361.5$$

$$144.6$$

$$18696.78 = 2^{\text{nd}} \text{ numeral.}$$

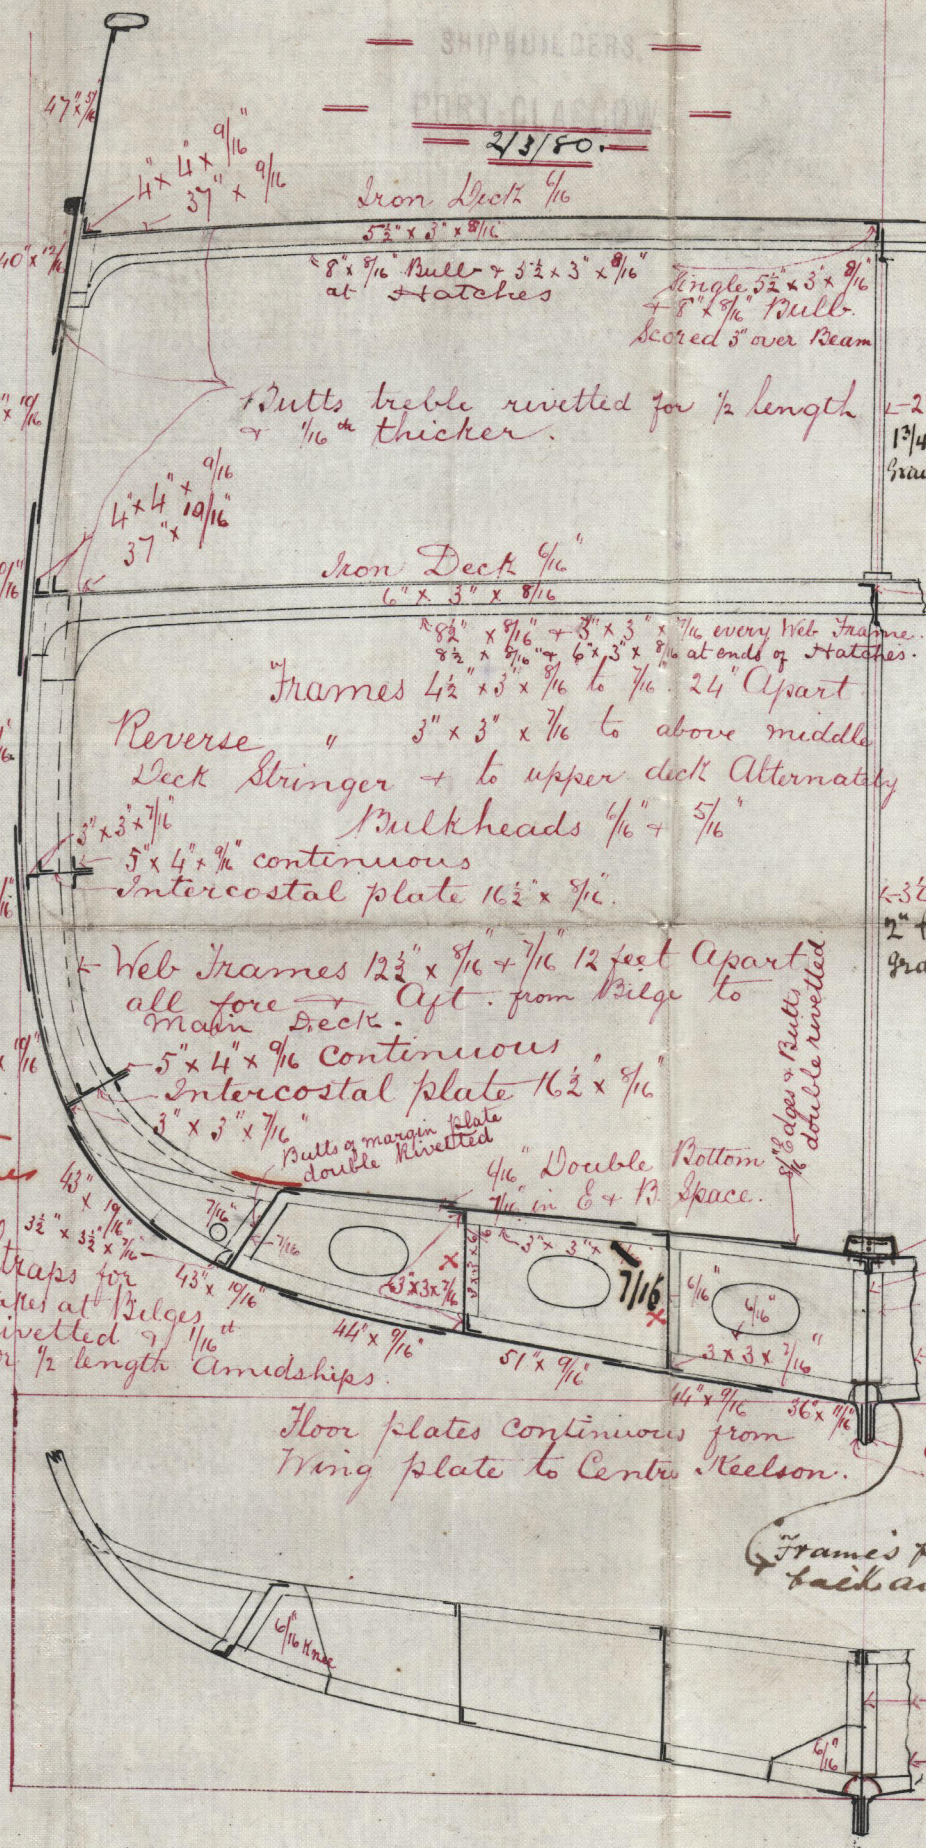

Single 6' x 3' x 7/16

8 1/2 x 7/16 Bulk scored

3 1/2 inches over Beams.

Reverse Frames to be double
the space + to extend to height
of Bilge Stringer as per Rule.



Scale 1/4 inch = 1 Foot.

3 1/2' and
2' bar for
main boards.

Shap at
web frames

Butt Straps for
Three Straps at Bilges
triple Rivetted 7/16
thicker for 1/2 length Amidships.

*Side Longitudinal Girders (Intercostal)

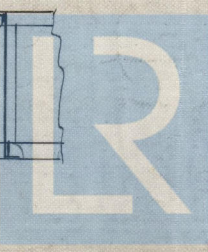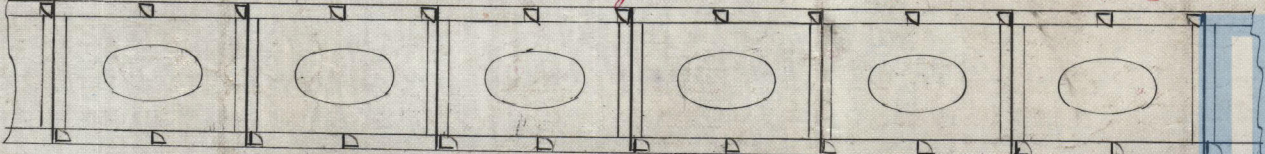

© 2020

Lloyd's Register
Foundation

GRK296-0176