

3/9/80.


MIDSHIP SECTION S.S. No. 103

CLASSED 100 A1 AT LLOYDS

S. S. Strathallan
Greenock Report
No. 4952.

DIMENSIONS

Length [as per rule]	148.9	First numeral	54.6
Breadth [Moulded]	27.5	Second do.	9464.94
Depth [top of keel to top of beam]	15.2	Equipment do.	10744.43
Half girth	25.65	Breadths in lengths	6.5
Length of Gr. deck 64 feet [Depth in way same 9.3]		Depths do.	11.4

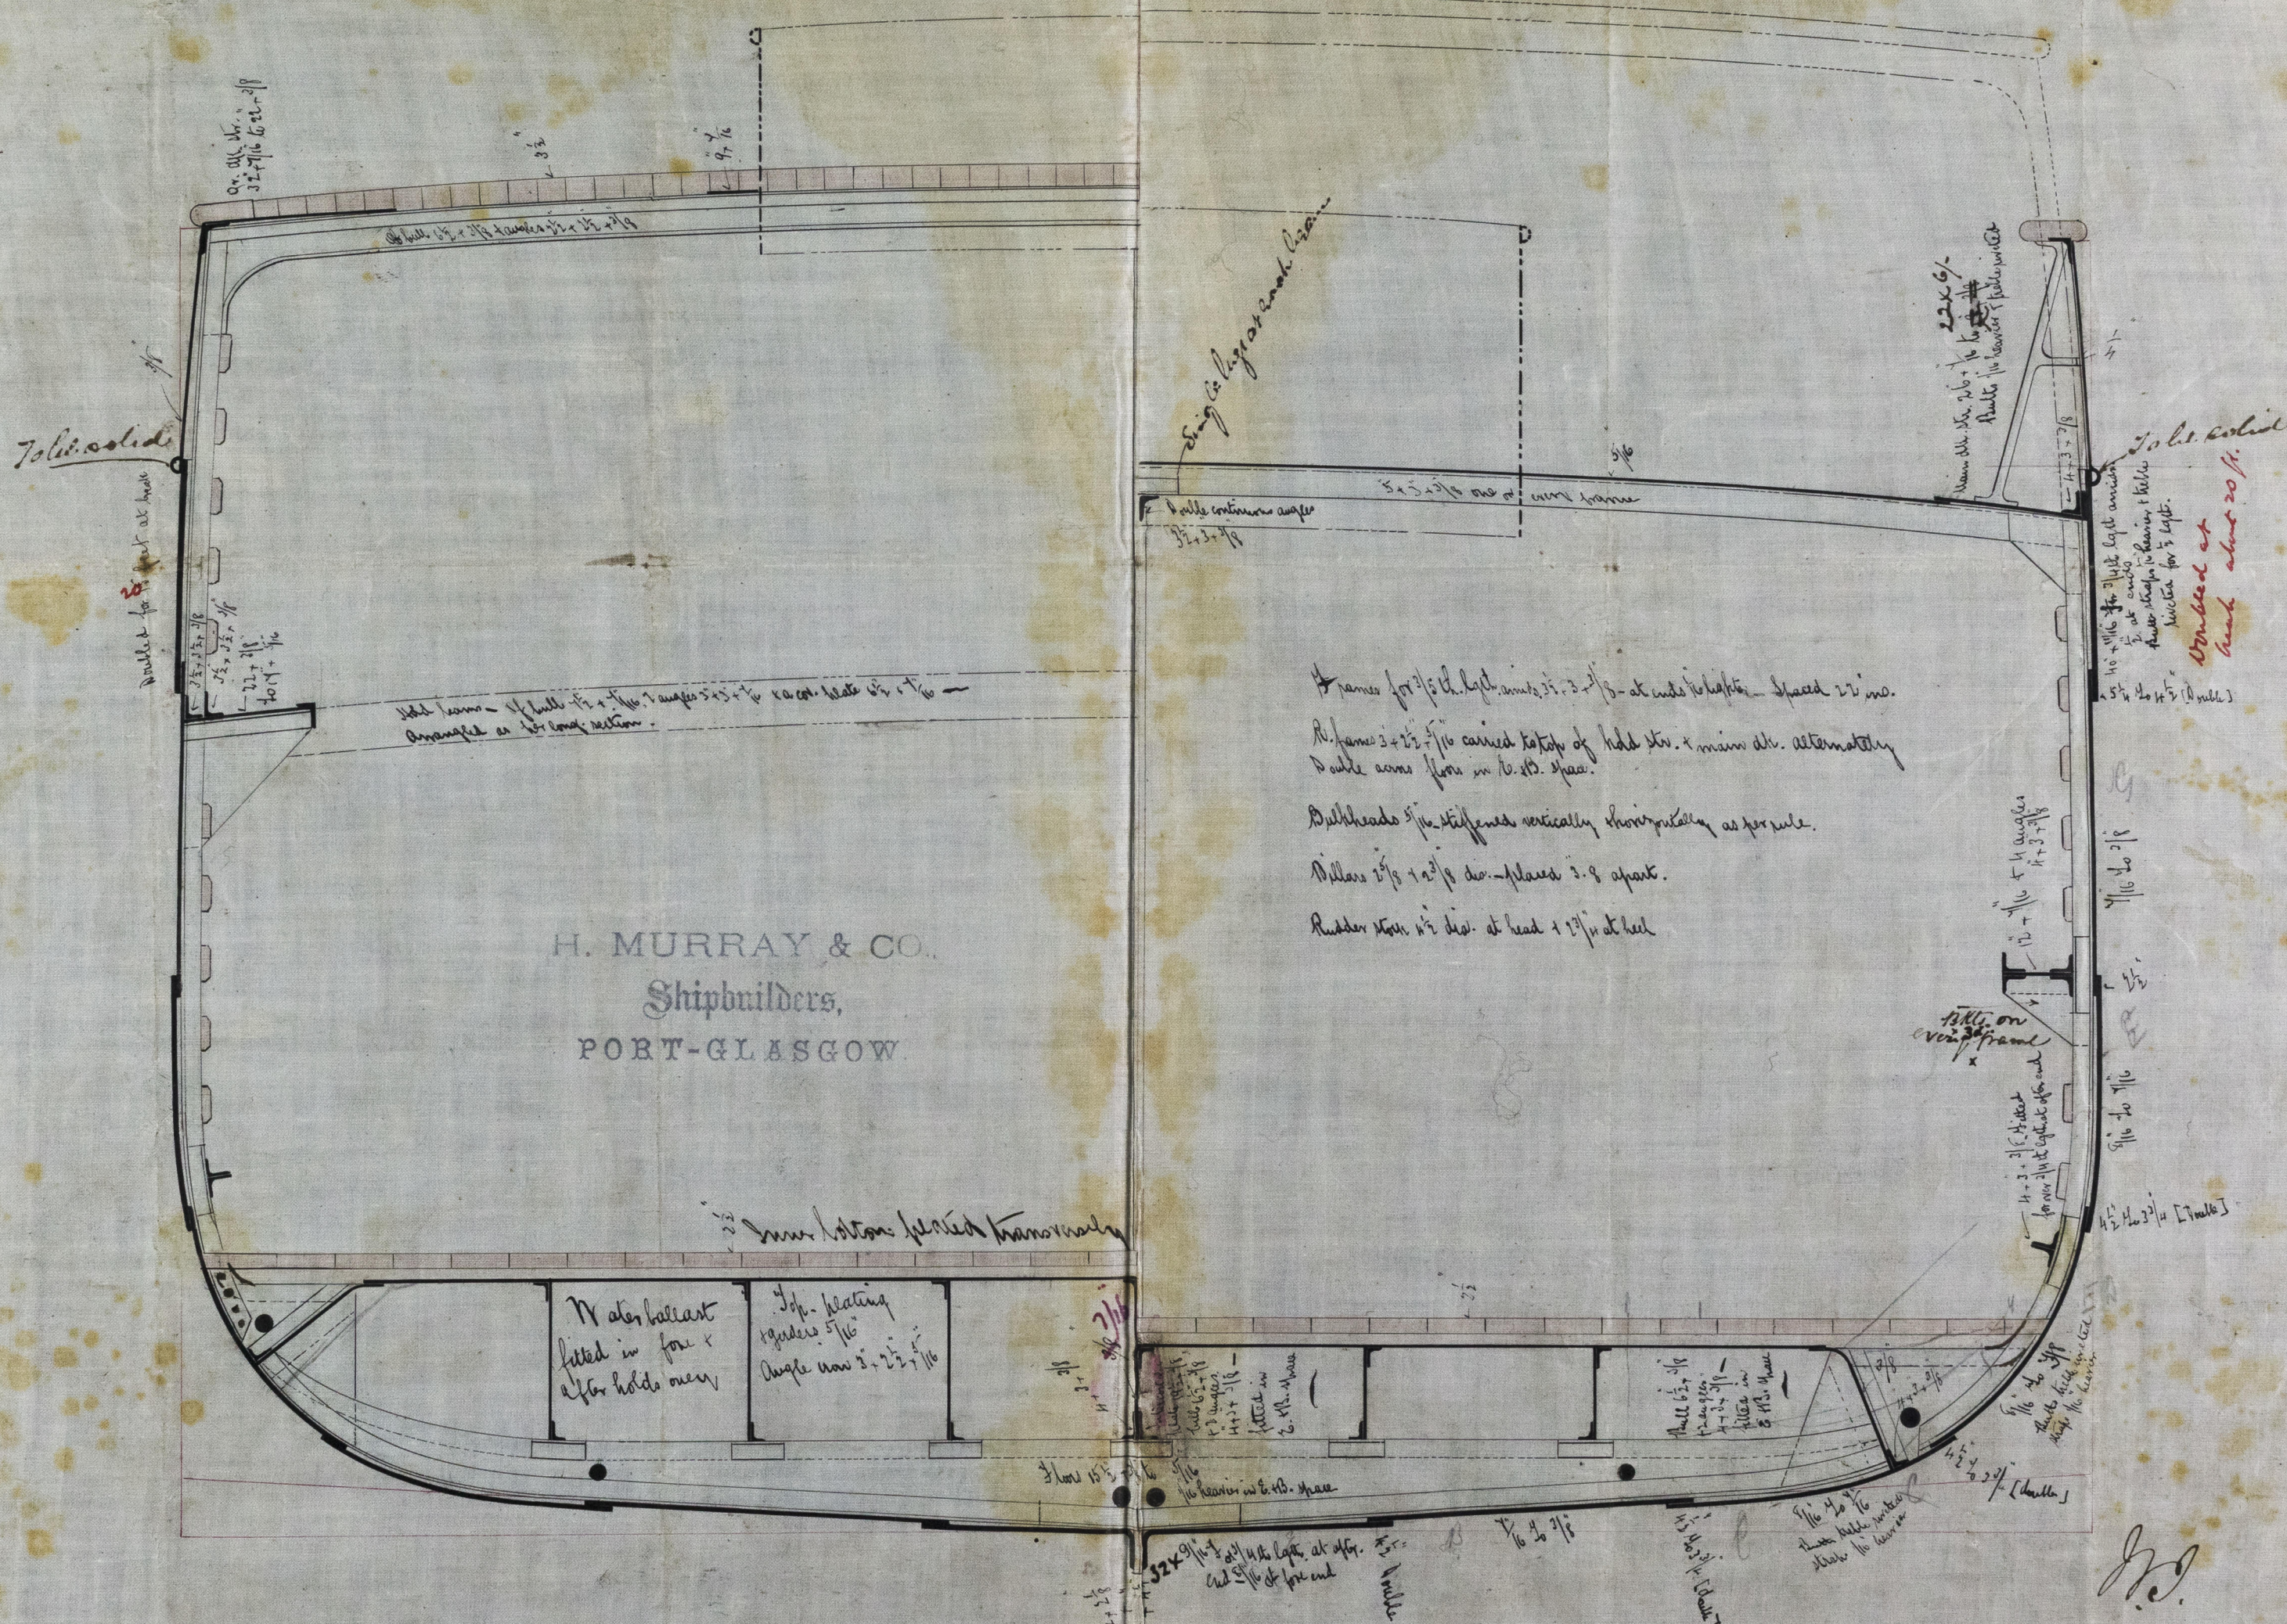

SCALE 1/2 INCH = ONE FOOT