

Ltd Gmk.  
21 Decr 1880


S. S. Strathallan of Glasgow  
Greenock Report  
No. 4952.

# ARRANGEMENT OF PUMPS &C.

S.S. No. 103.

Dimensions 178.9 x 27.5 x 15.2

MD  
20.12.80

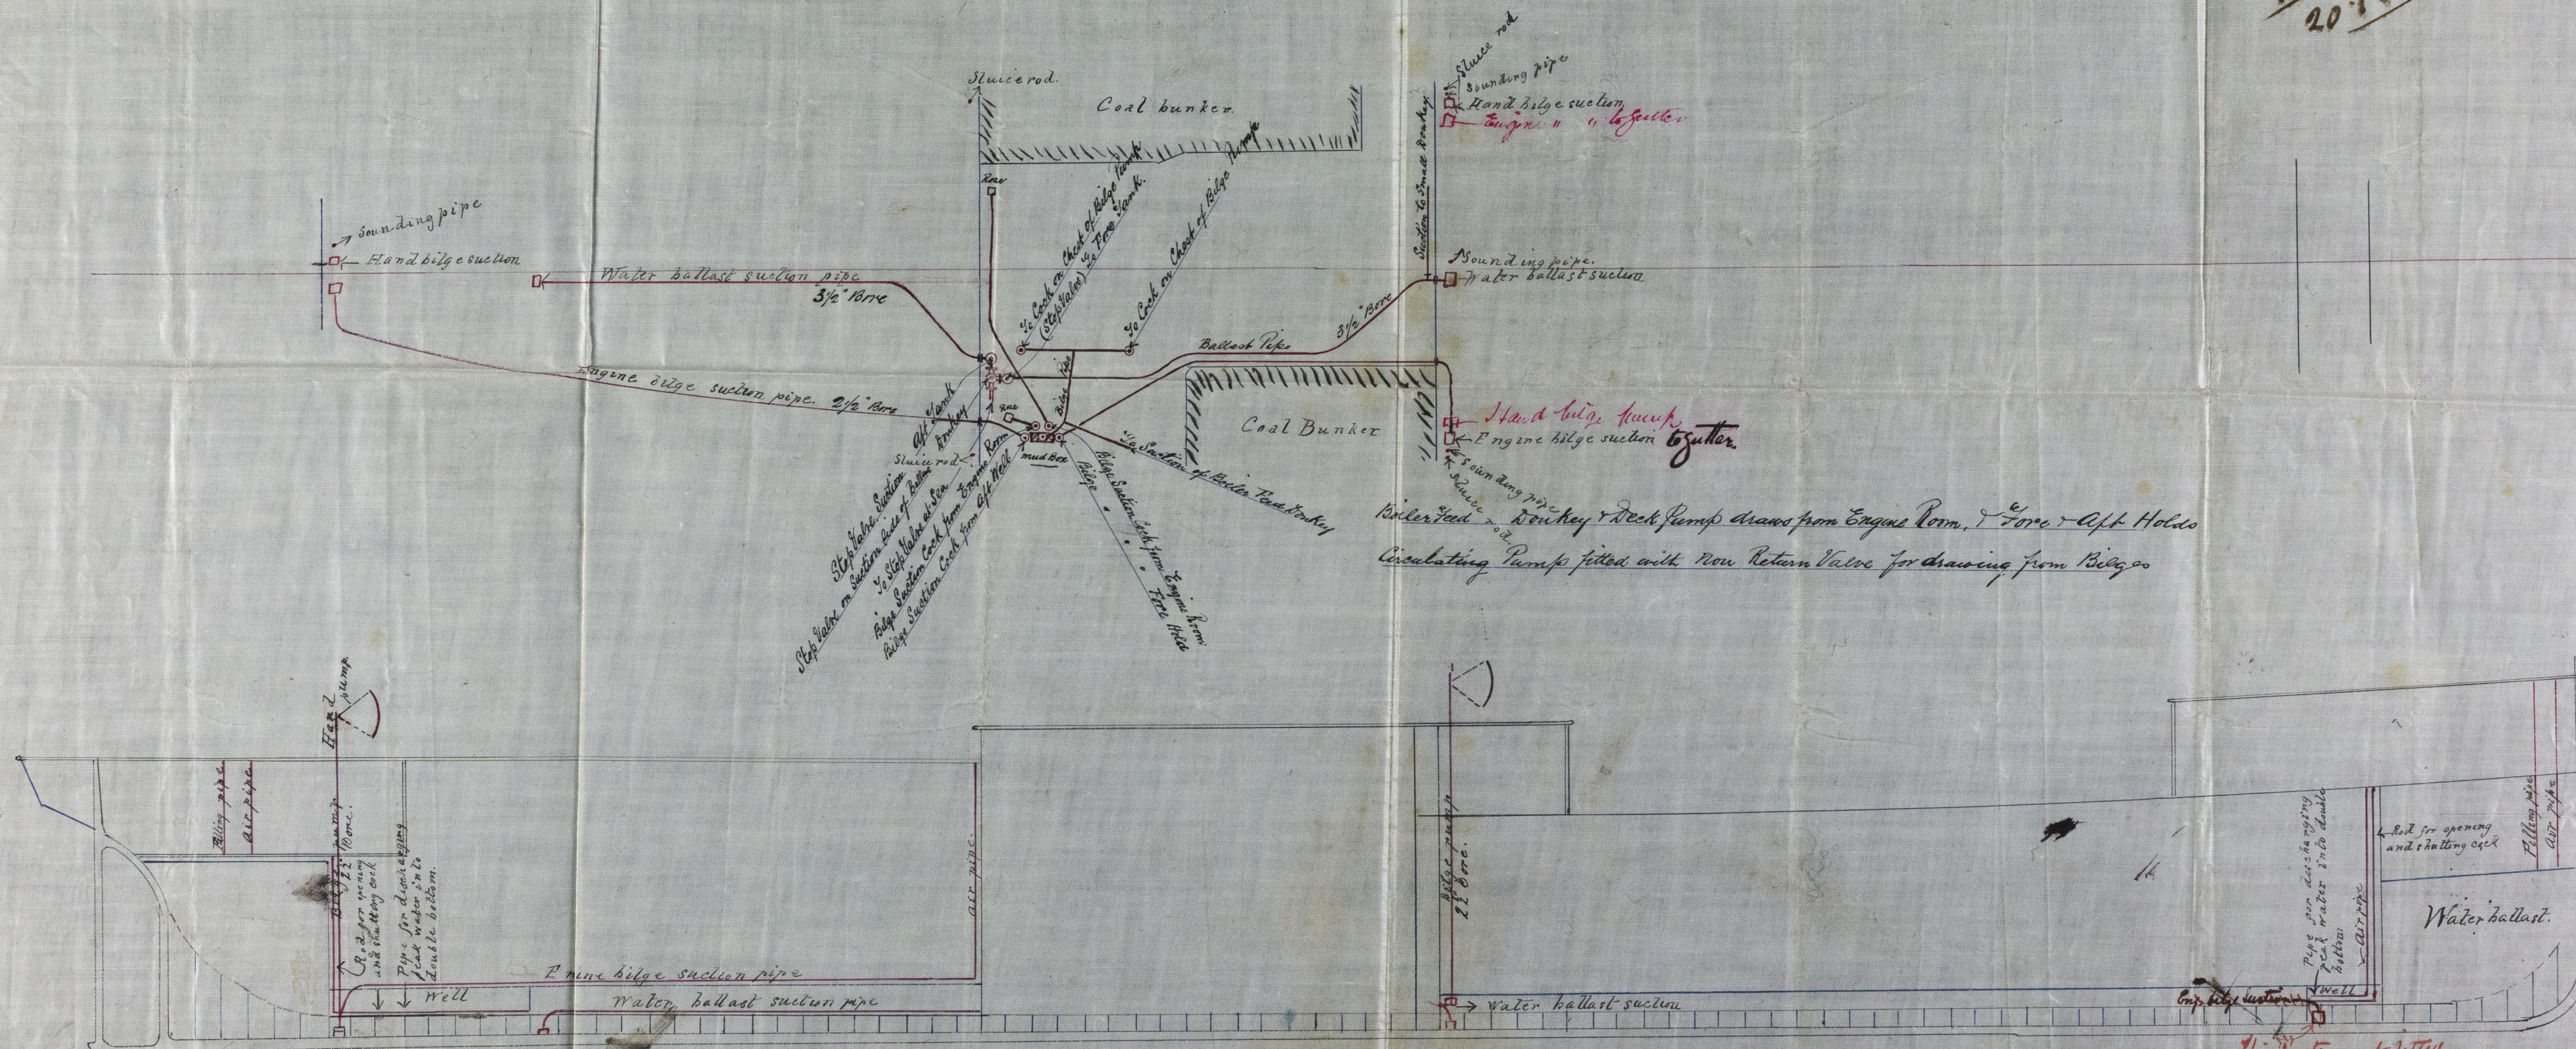

H. MURRAY & CO.  
Shipbuilders,  
PORT-GLASGOW.

This suction not fitted  
as well is cemented up to level of gutter



© 2019

Lloyd's Register  
Foundation

GRK246-0182