


S.S. "Laja" of Valparaiso  
Greenock Report  
No. 8004.

S.S. No. 6/P.

JOHN REID & CO  
Ship Builders  
PORT GLASGOW  
27 July 1880

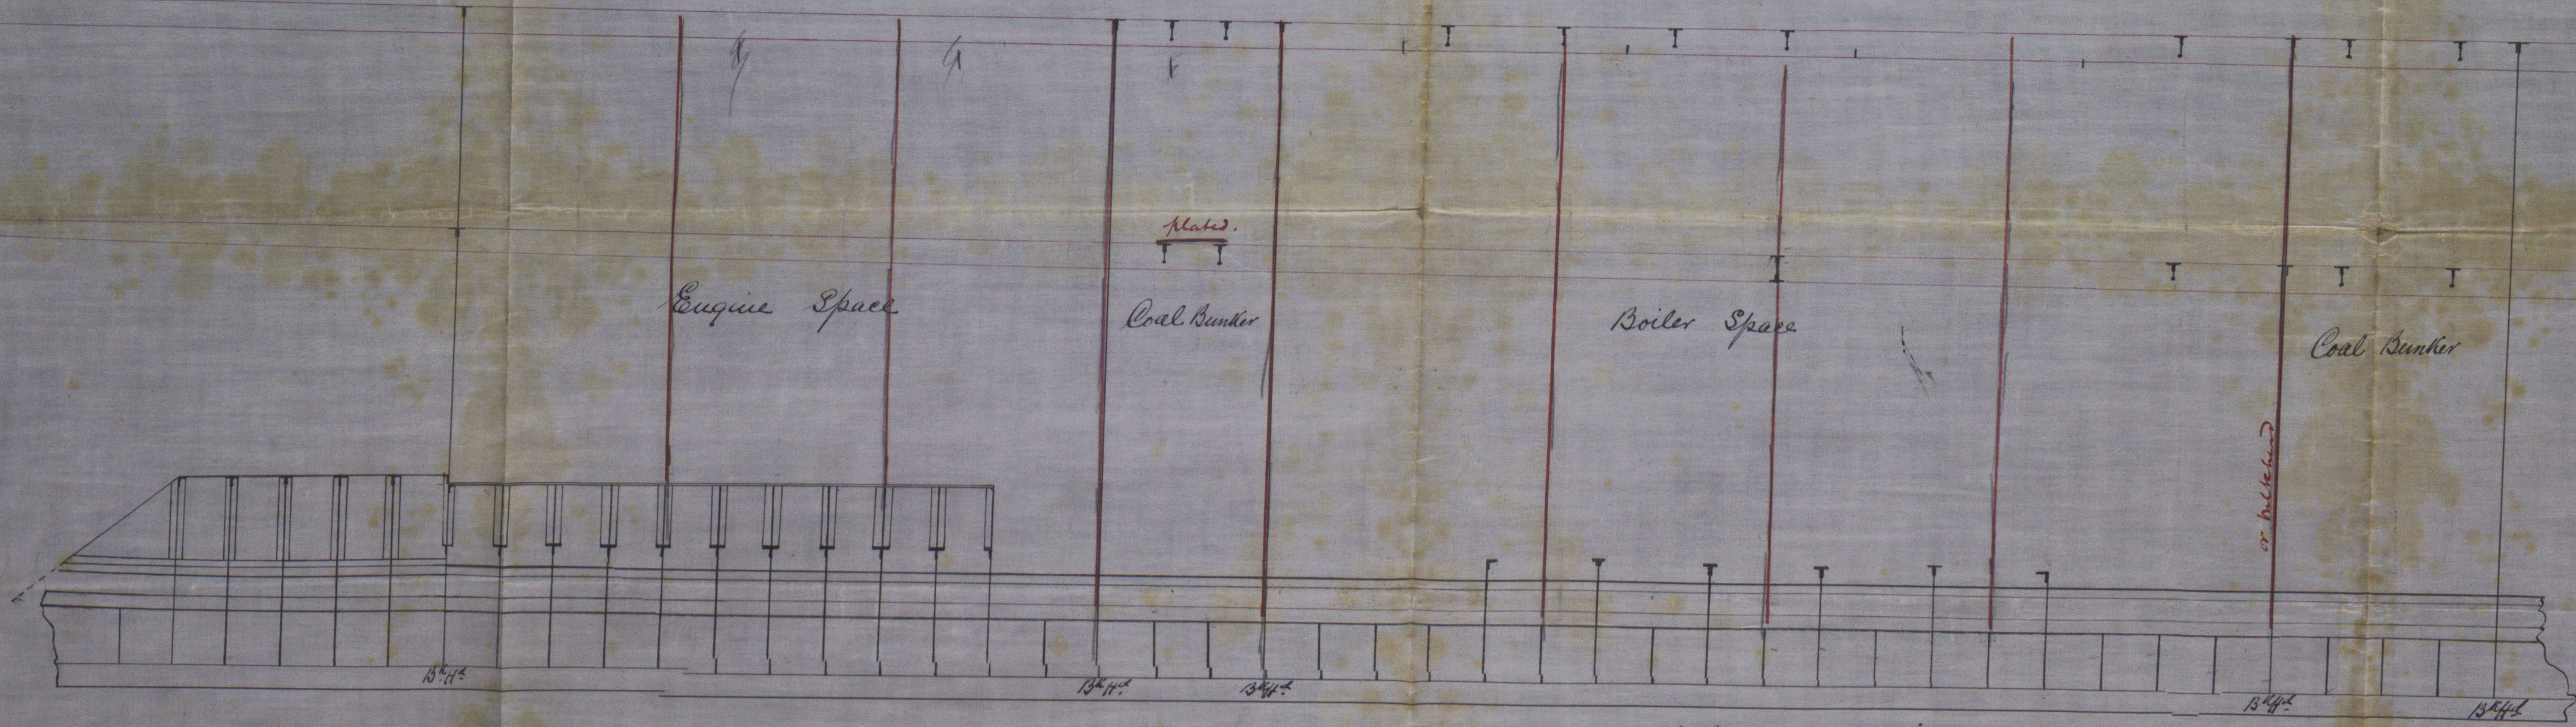

Web frames shown in red.

C. 176  
3/8/80