

Half Midship Section
of S. S. No 6/p

Scale 1/2 Inch = 1 Foot

to Class 90. A. Shade deck

S. S. No 6/p

1/2 Di. Circ 36.0

1/2 Breadth 19.95

Depth 22.95

48.9

320


2367

25248.0


1st Number

2nd Number

Proportions

(8.02) over 8 under 8 1/2 breadths

(13.7) over 13 under 14 depths

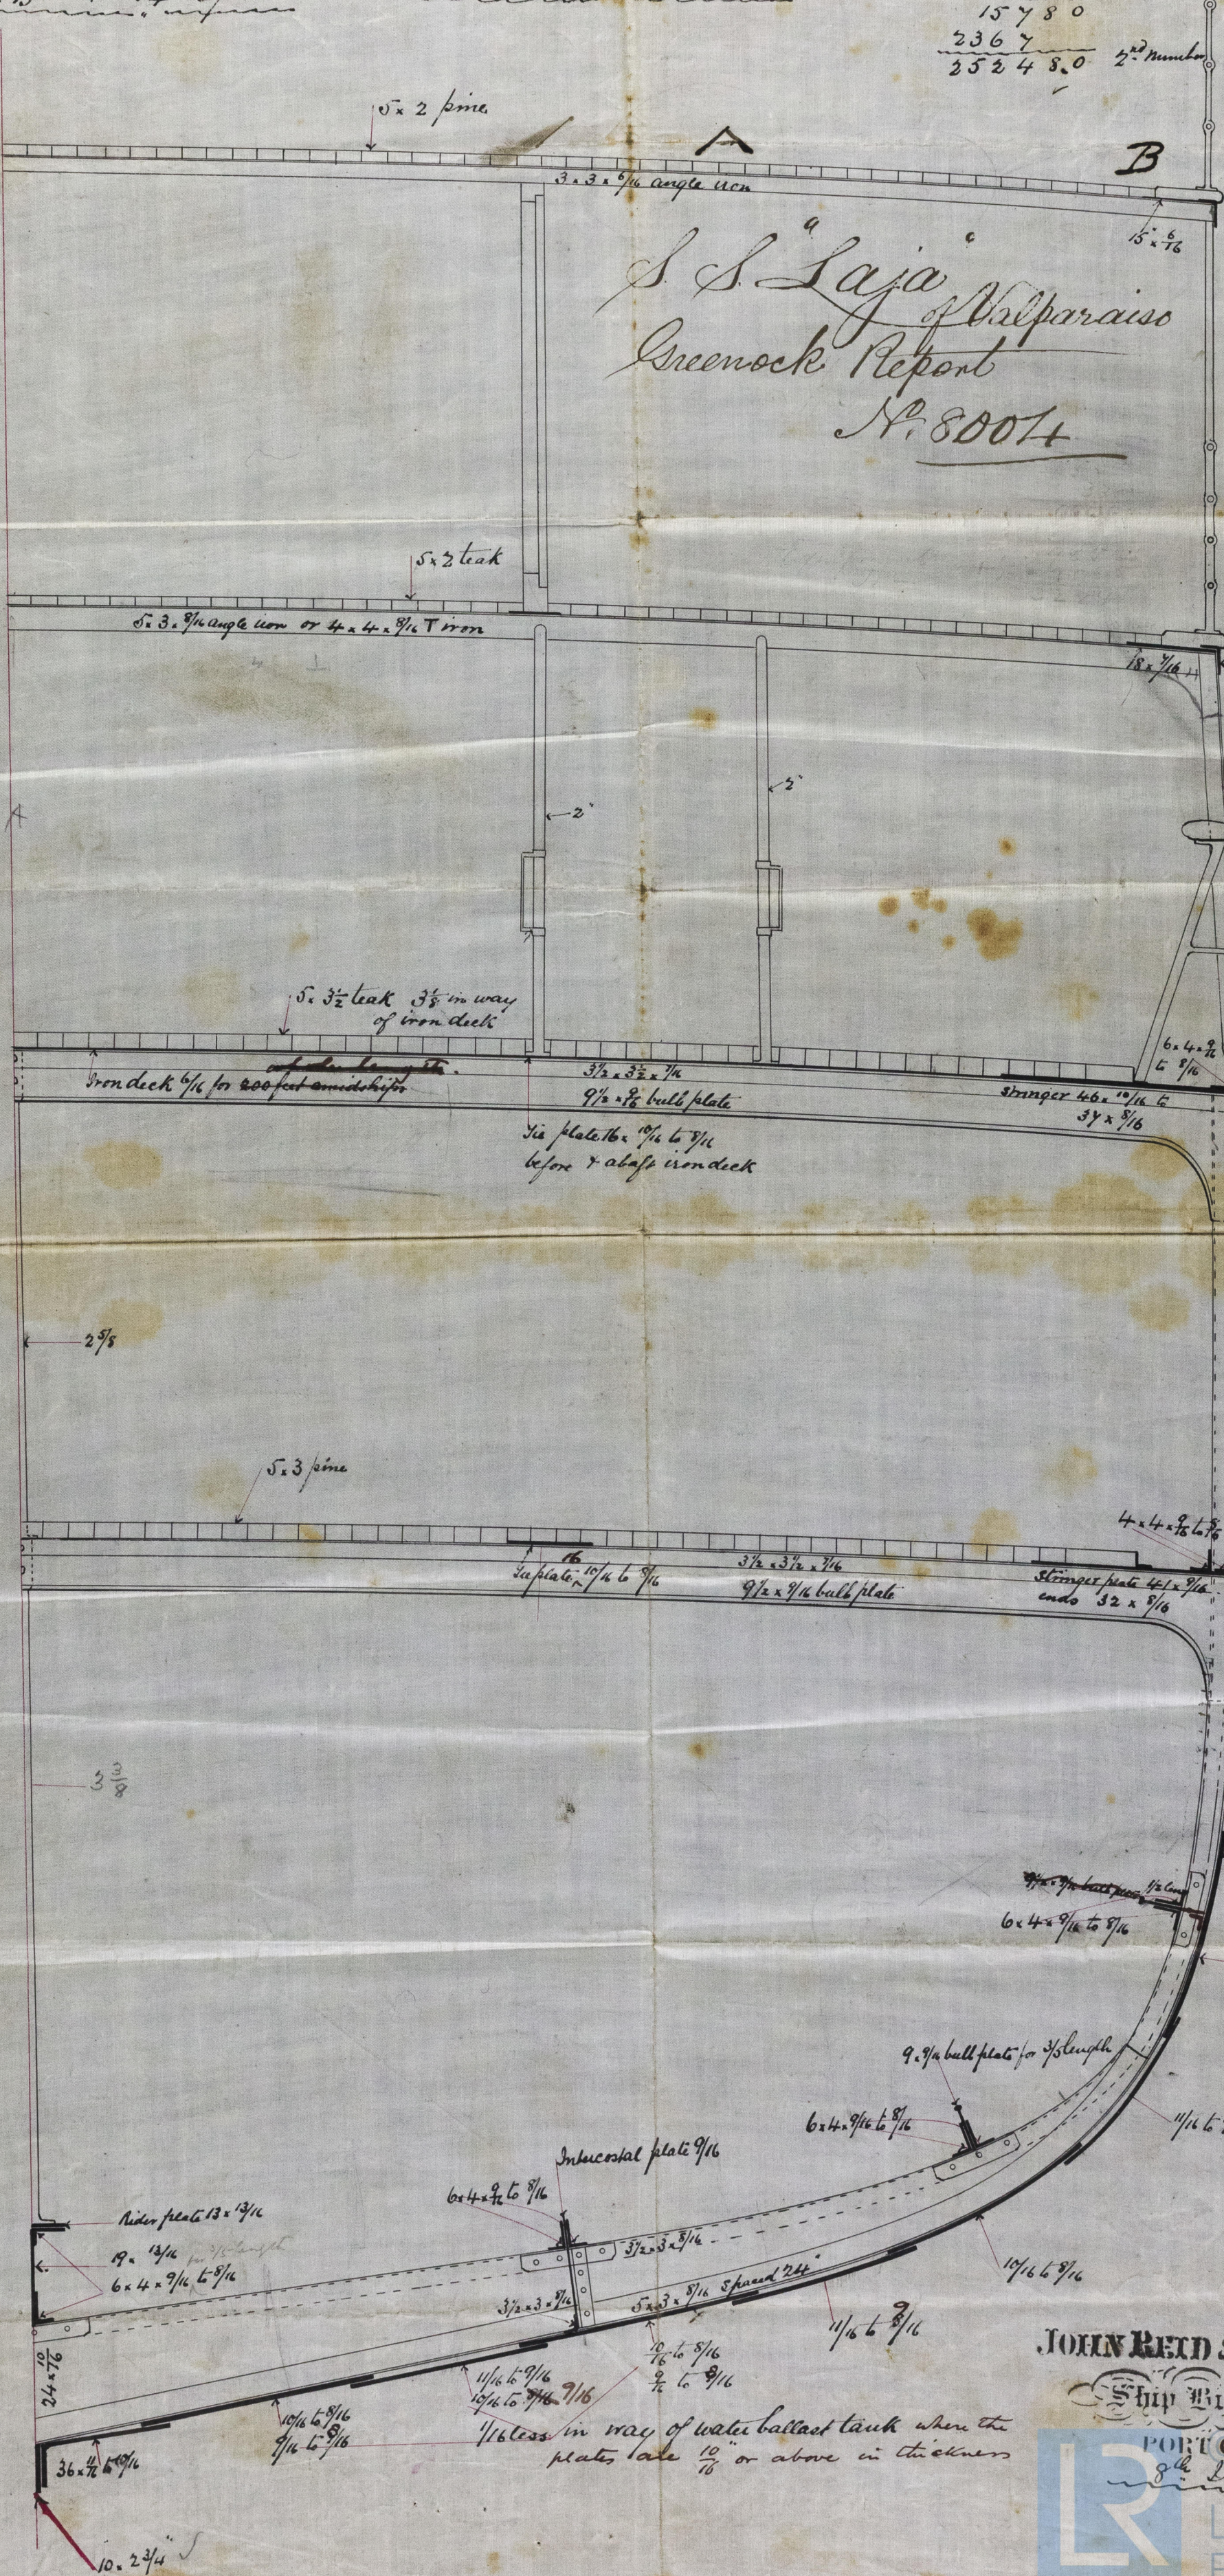

JOHN REID & CO

Ship Builders

PORT GLASGO

8th June 1880



Lloyd's Register Foundation