



Bth "Bolivia" of Liverpool Greenock Report No. 8052.

GRK 297-0002

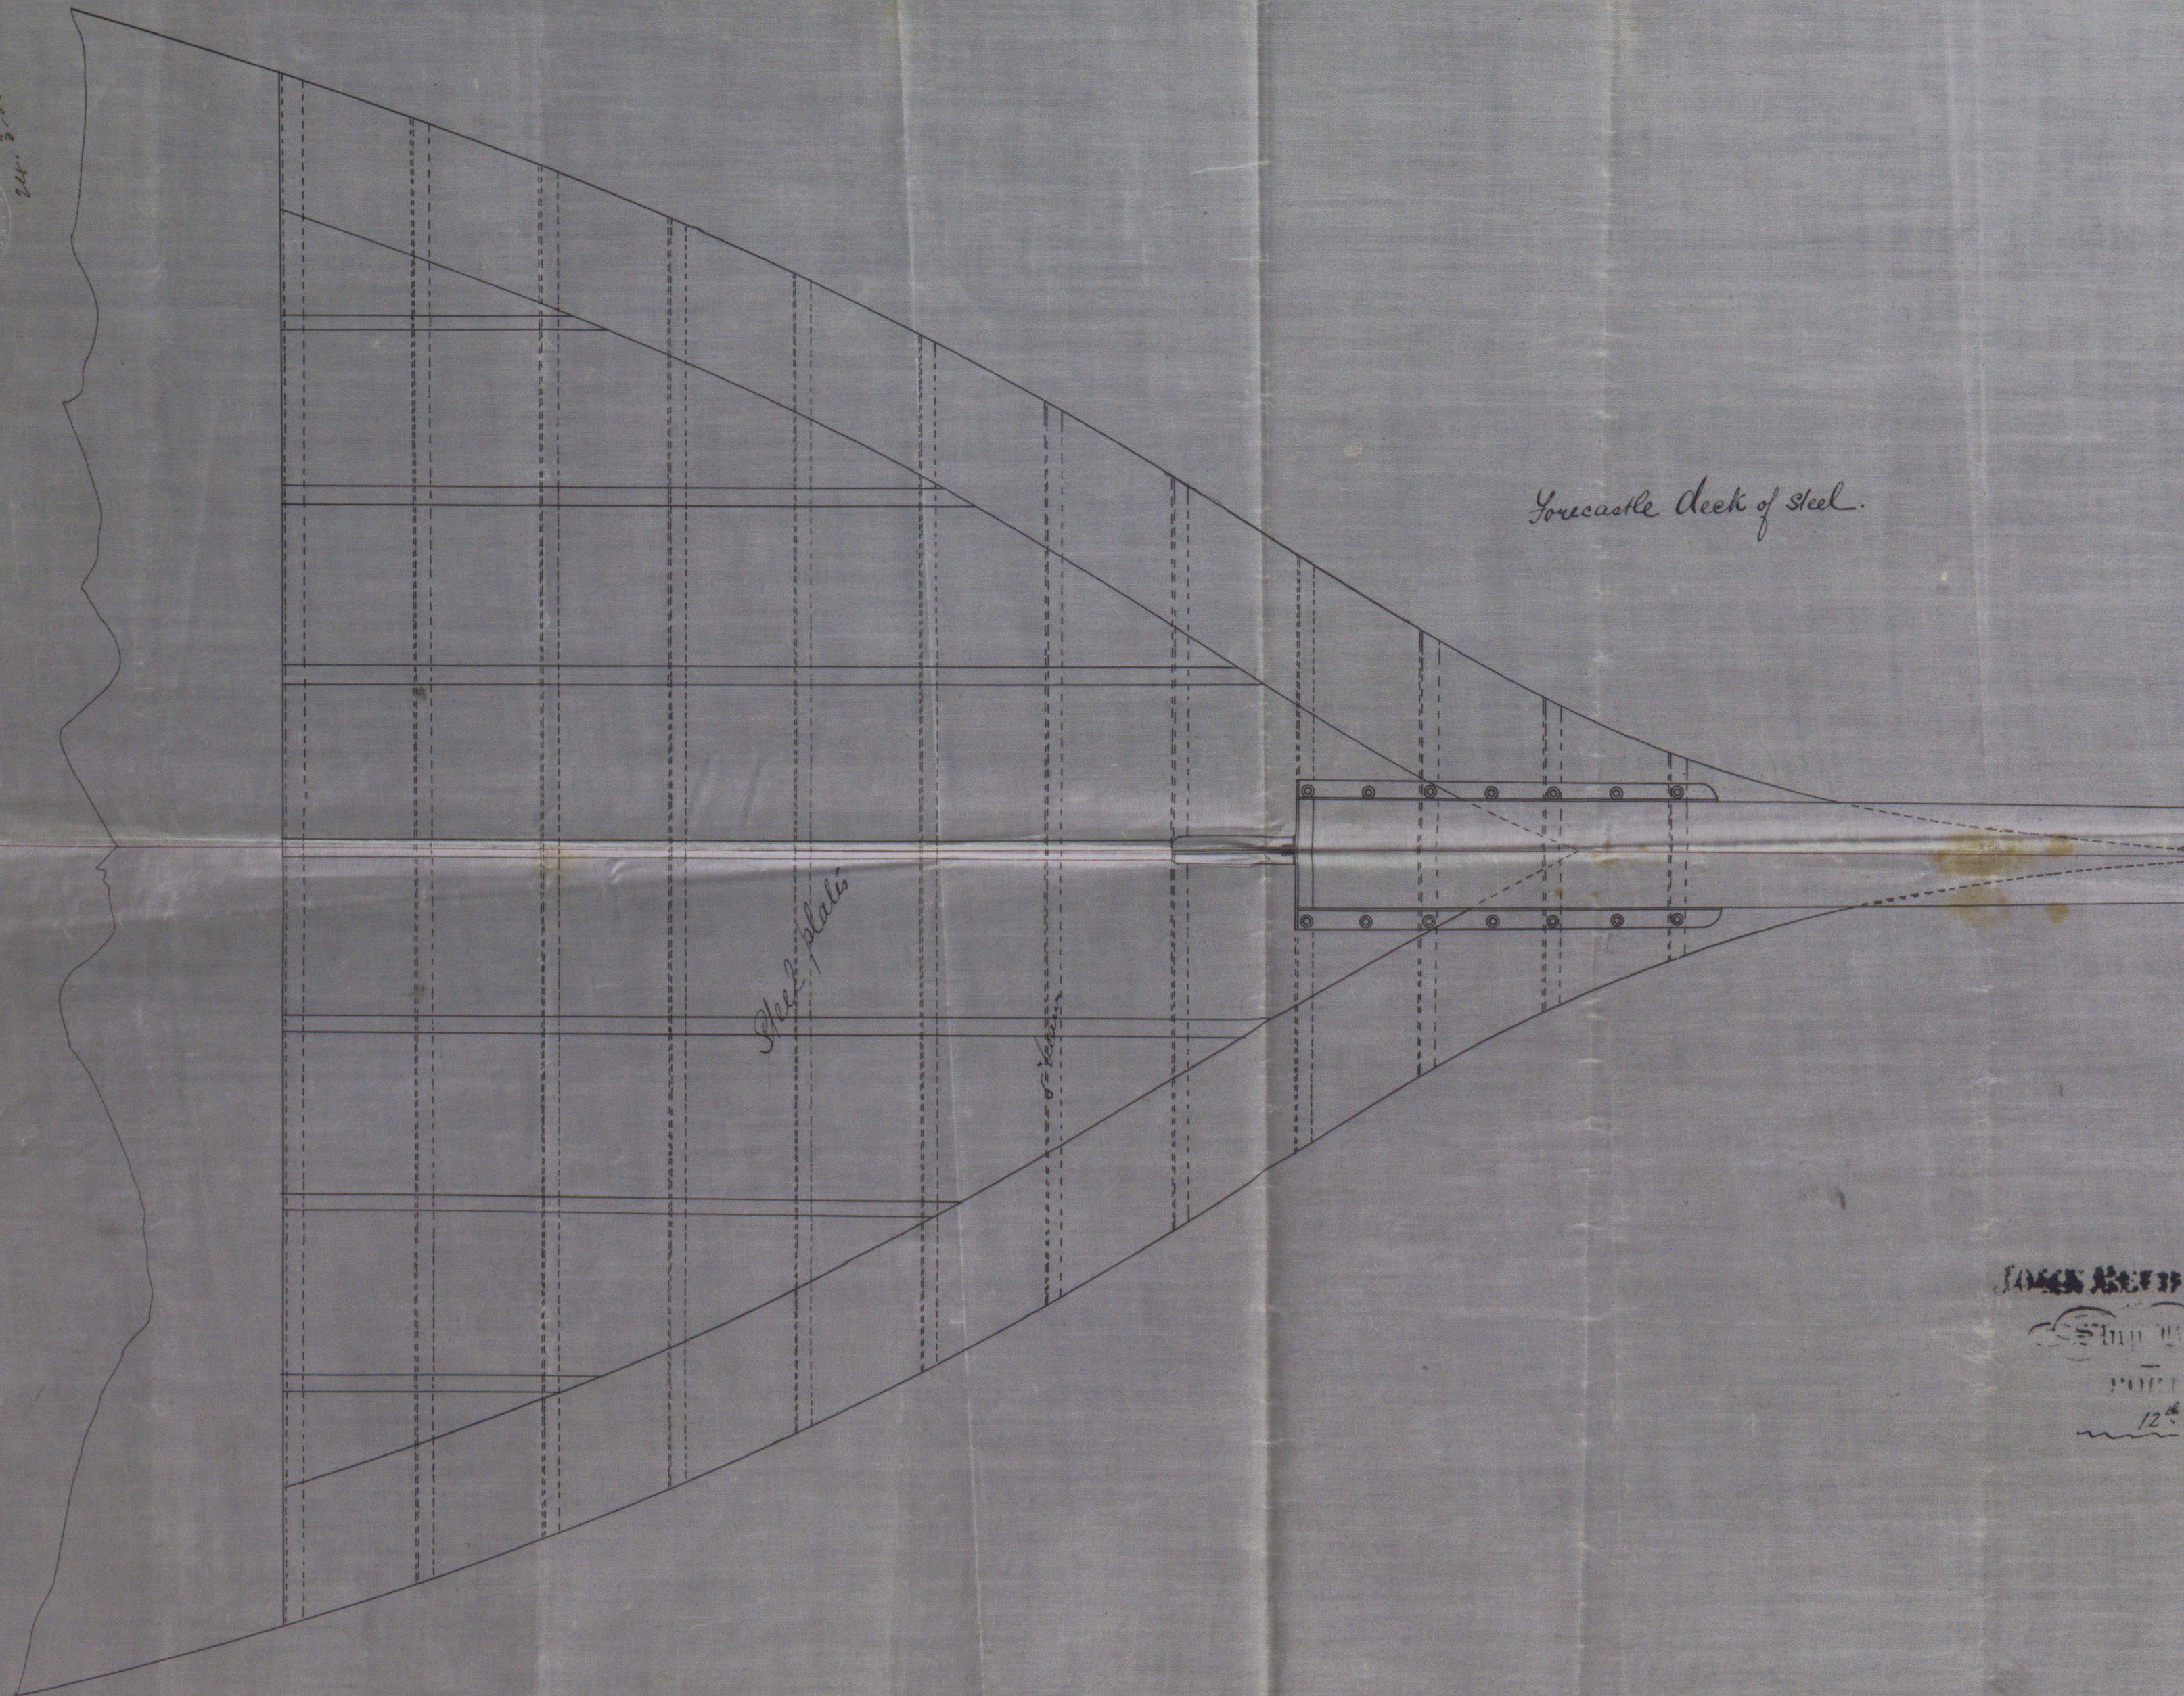


JOHN BETHUN
SHIP BUILDERS
PORT GLENN
12th March 81

Bowport of Barques 6/11 16/0
Scale 1/2 inch = 1 foot

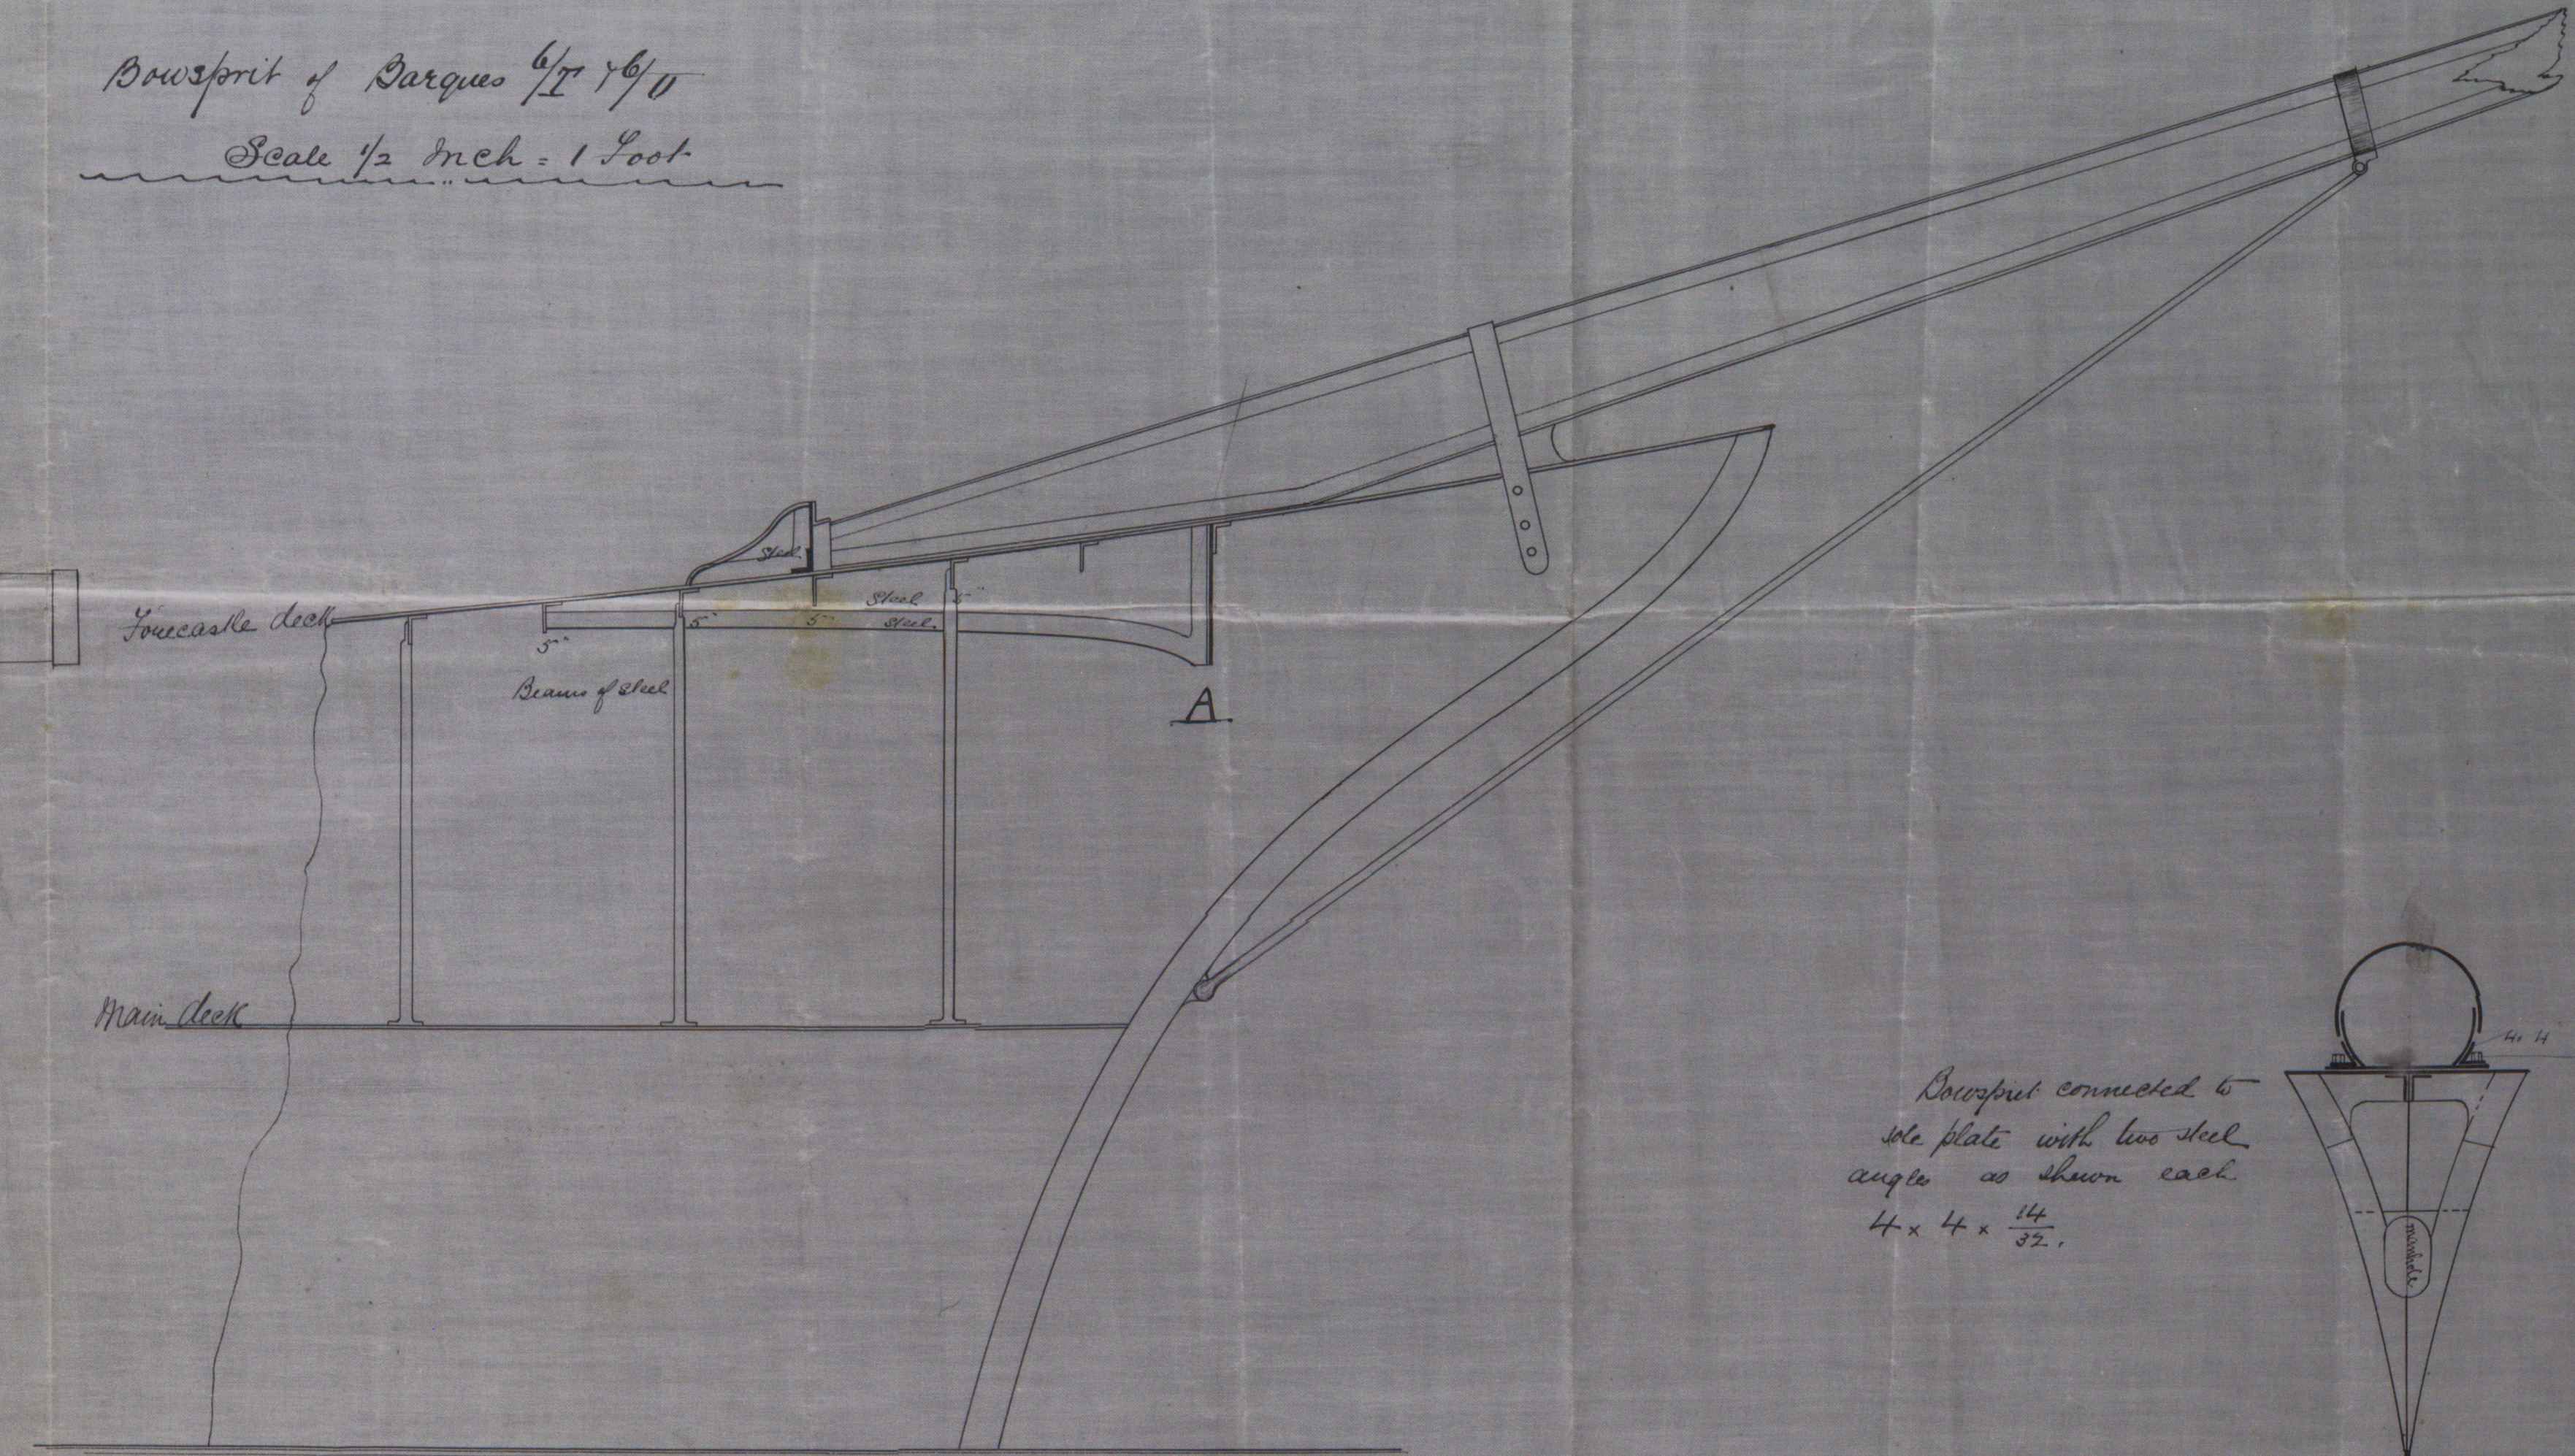

Bowport connected to sole plate with two steel angles as shown each 4 x 4 x 1/2.

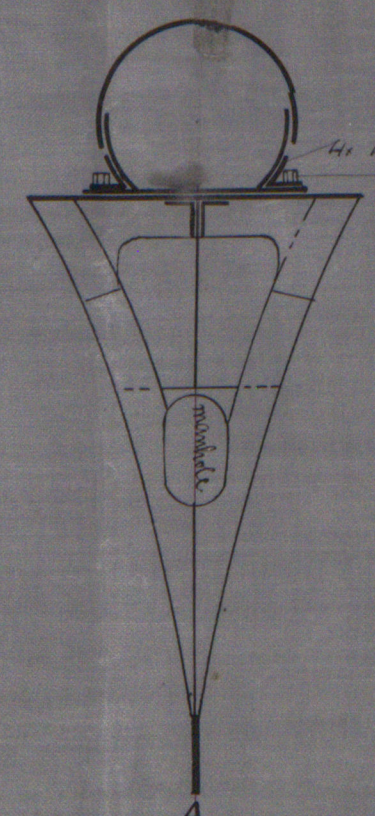

Bolts 1" dia
Bolts 11/2" apart properly fitted on each side of bowport 6 bolts distributed over the sole plate inside the bowport.

Cross Section through bowport

24/3/81
Lloyd's Register
GRK 297-0002

Pl. "Voliva" of Liverpool Greenock Report

Boarder of Barque 6/11 1/10

Scale 1/2 inch = 1 foot.



© 2019

Lloyd's Register
Foundation

GRK297-0002

