

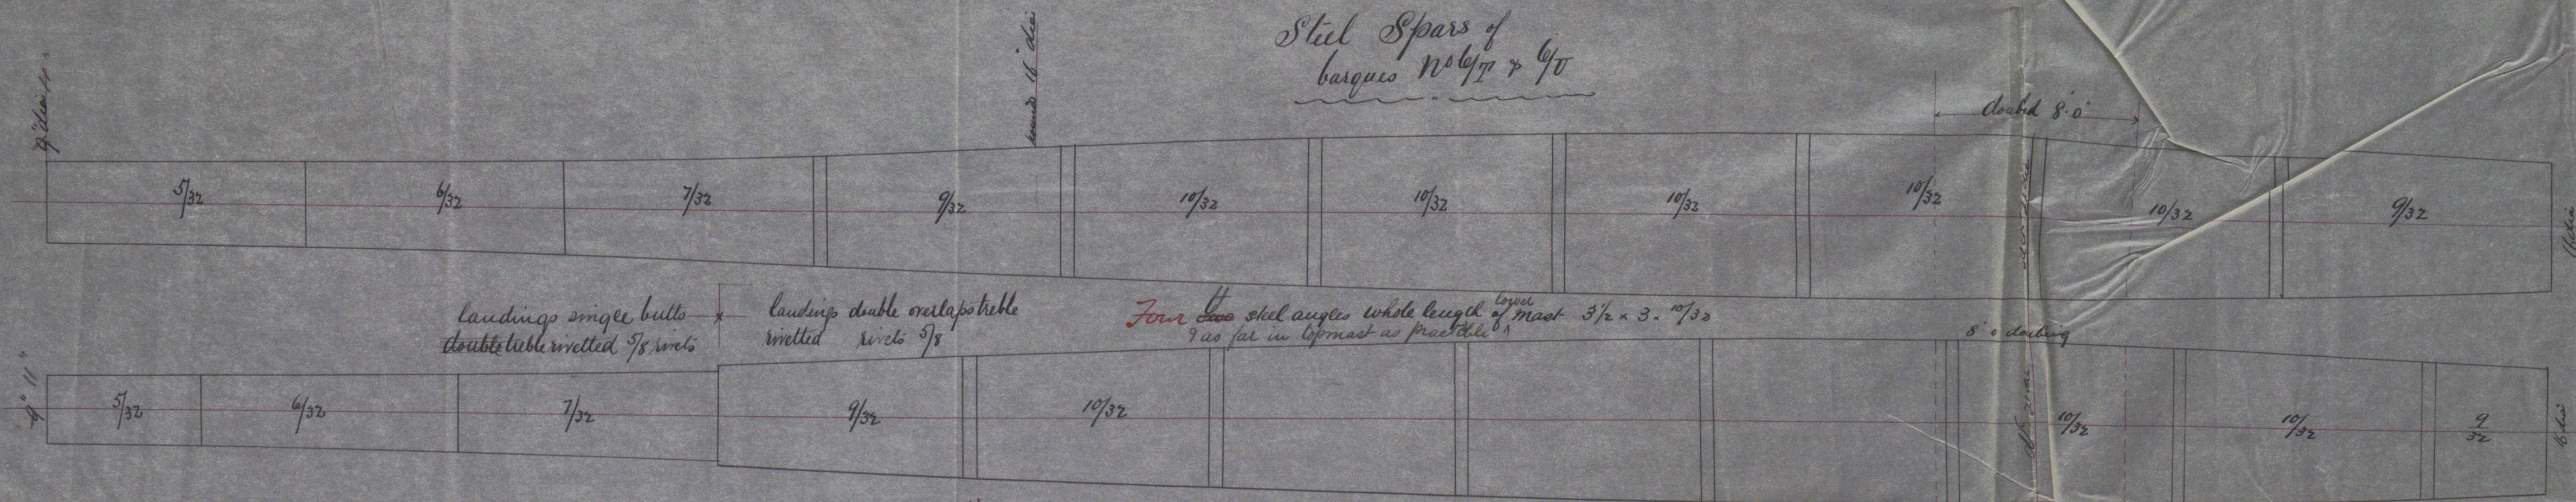


B/L "Bolivia" of Liverpool
 Greenock Report
 No. 8052-


JOHN REID & CO.
 Ship Builders
 11th March 81
 GRK 297-0005

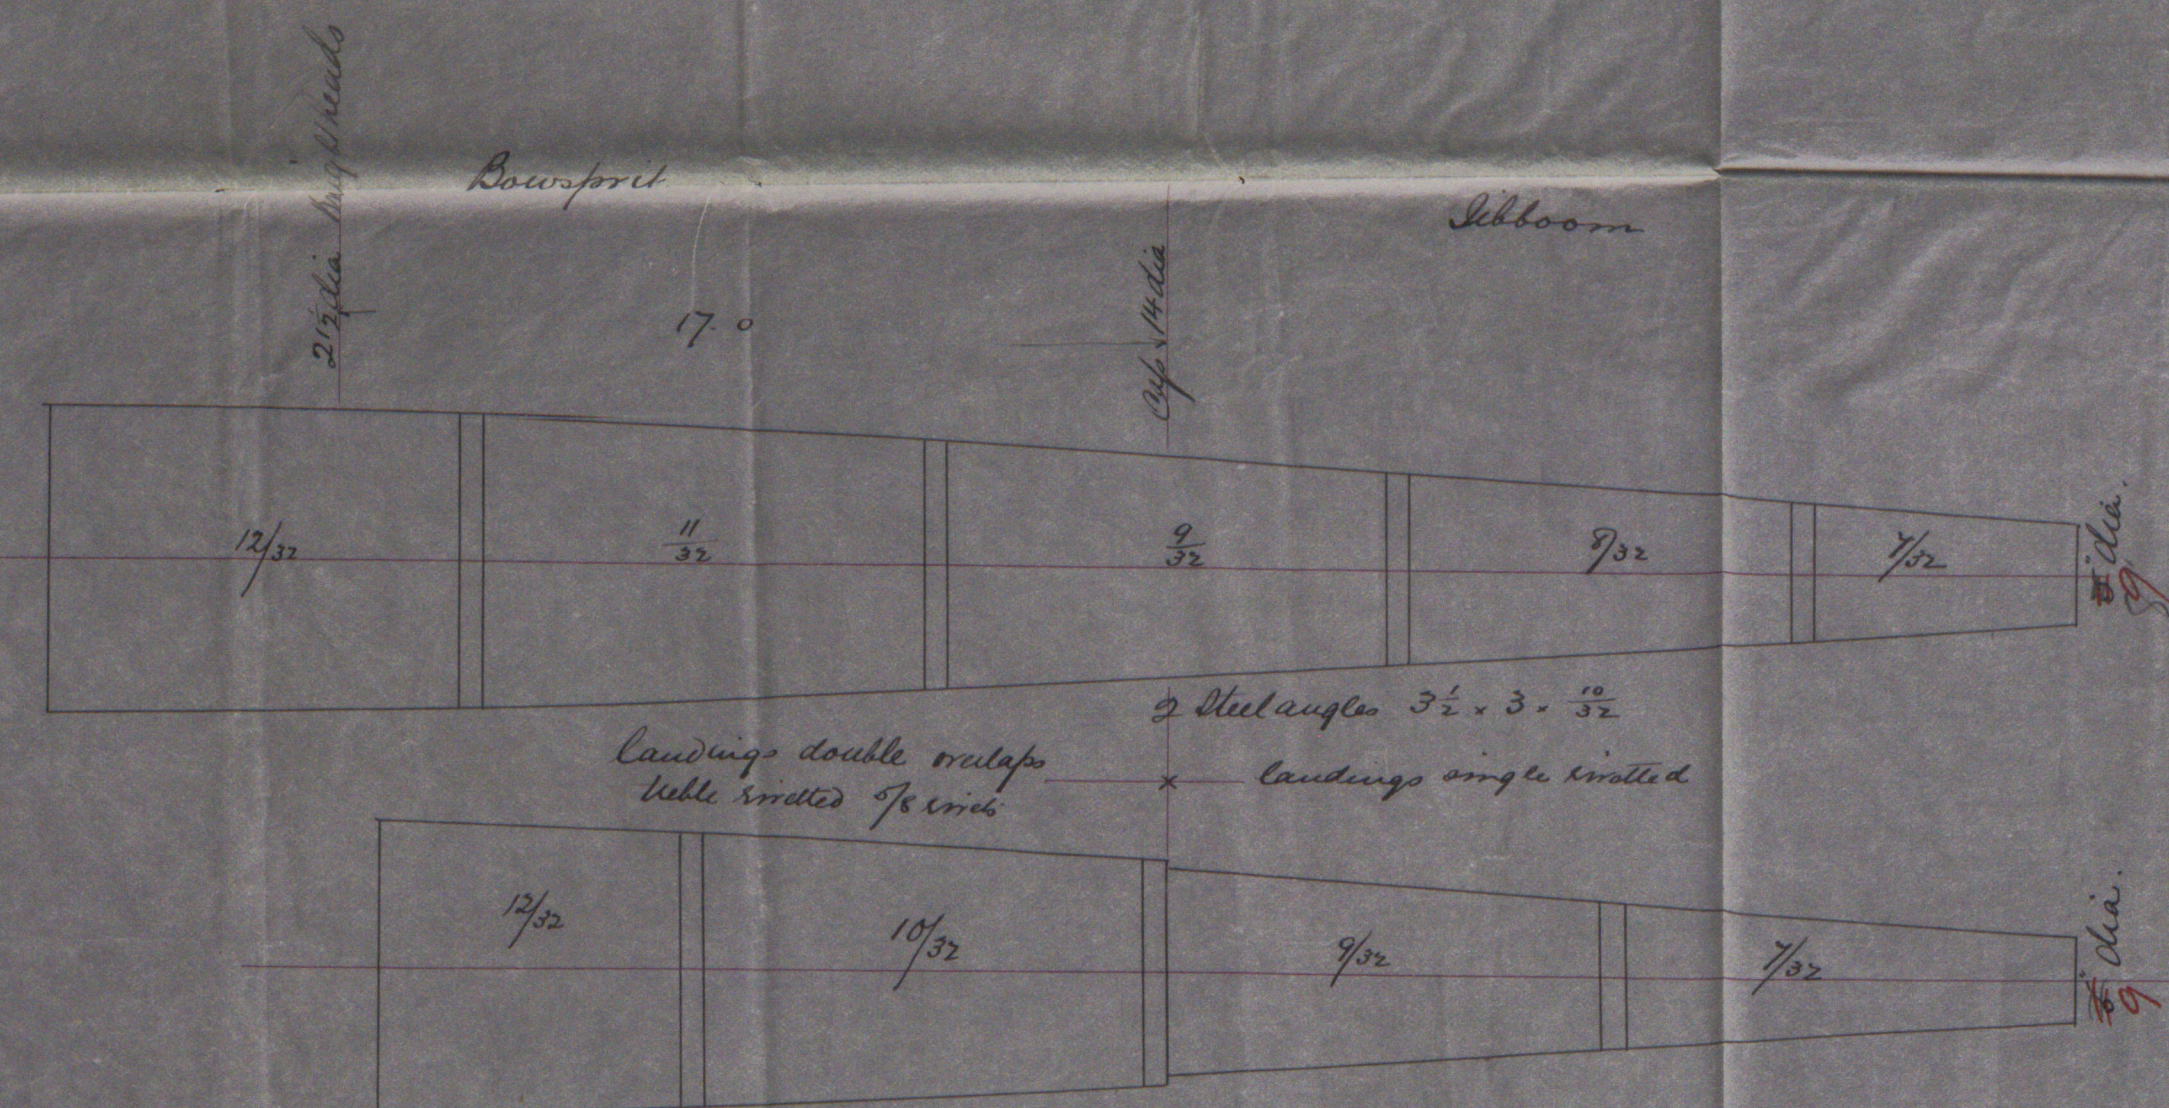


Fore Mast
 under deck 20' 2"
 deck to hounds 39' 0"
 59' 2"
 Topmast 38' 0"

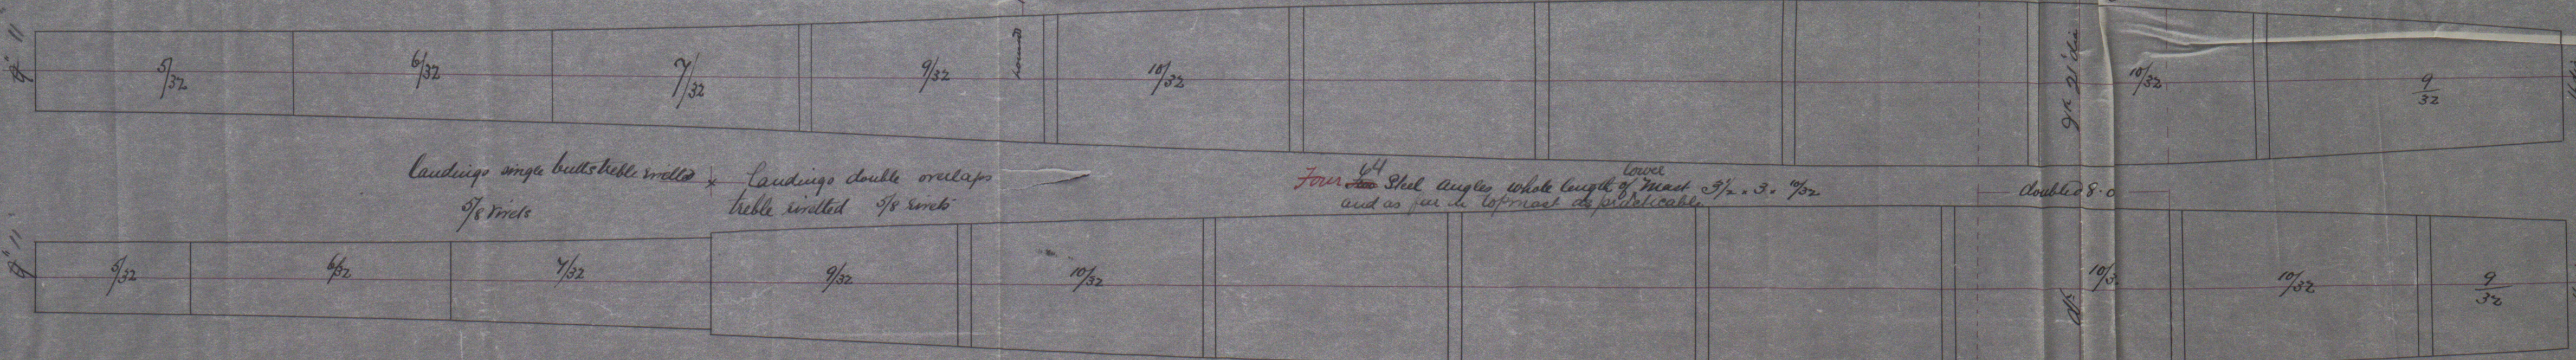

Main Mast
 under deck 4' 2"
 deck to hounds 41' 0"
 45' 2"
 Topmast 38' 0"

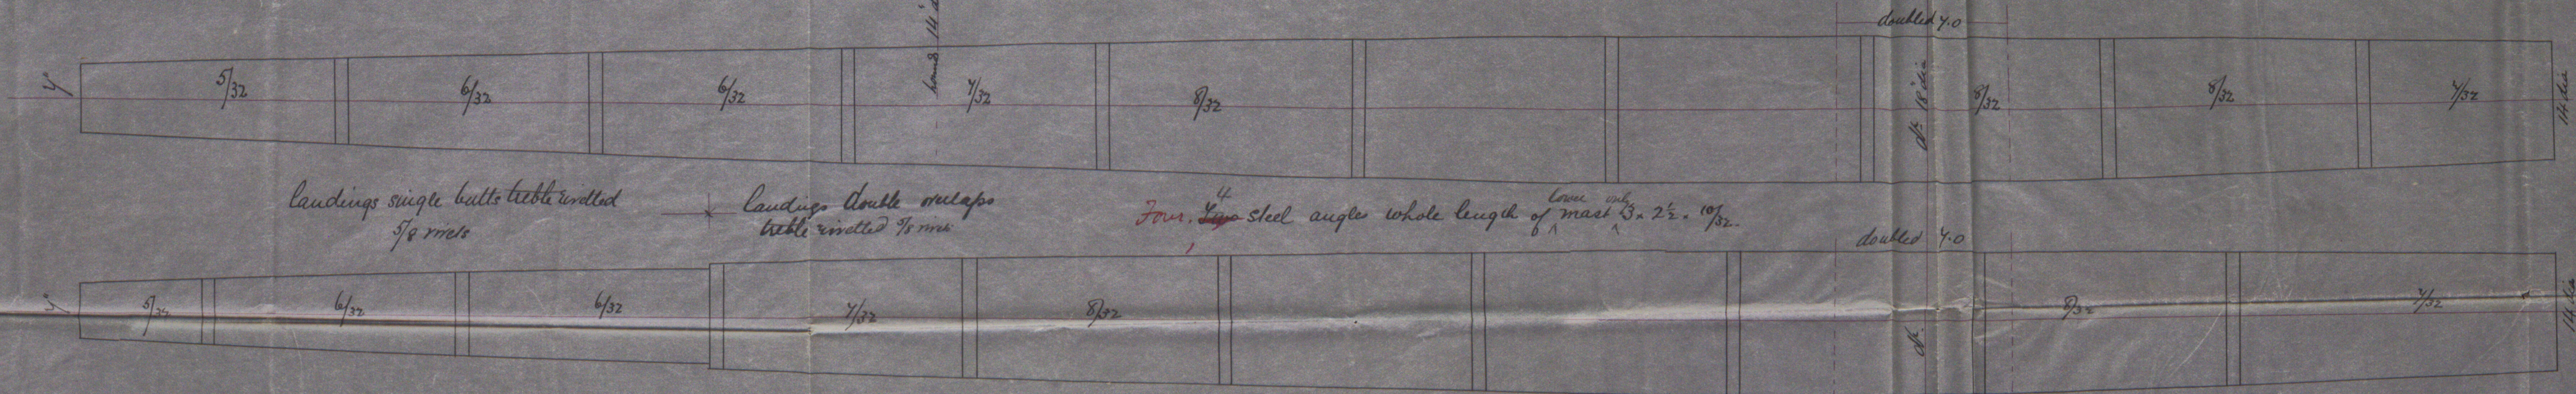

Mizzen Mast
 under deck 23' 8"
 deck to hounds 34' 0"
 57' 8"
 Topmast 32' 0"

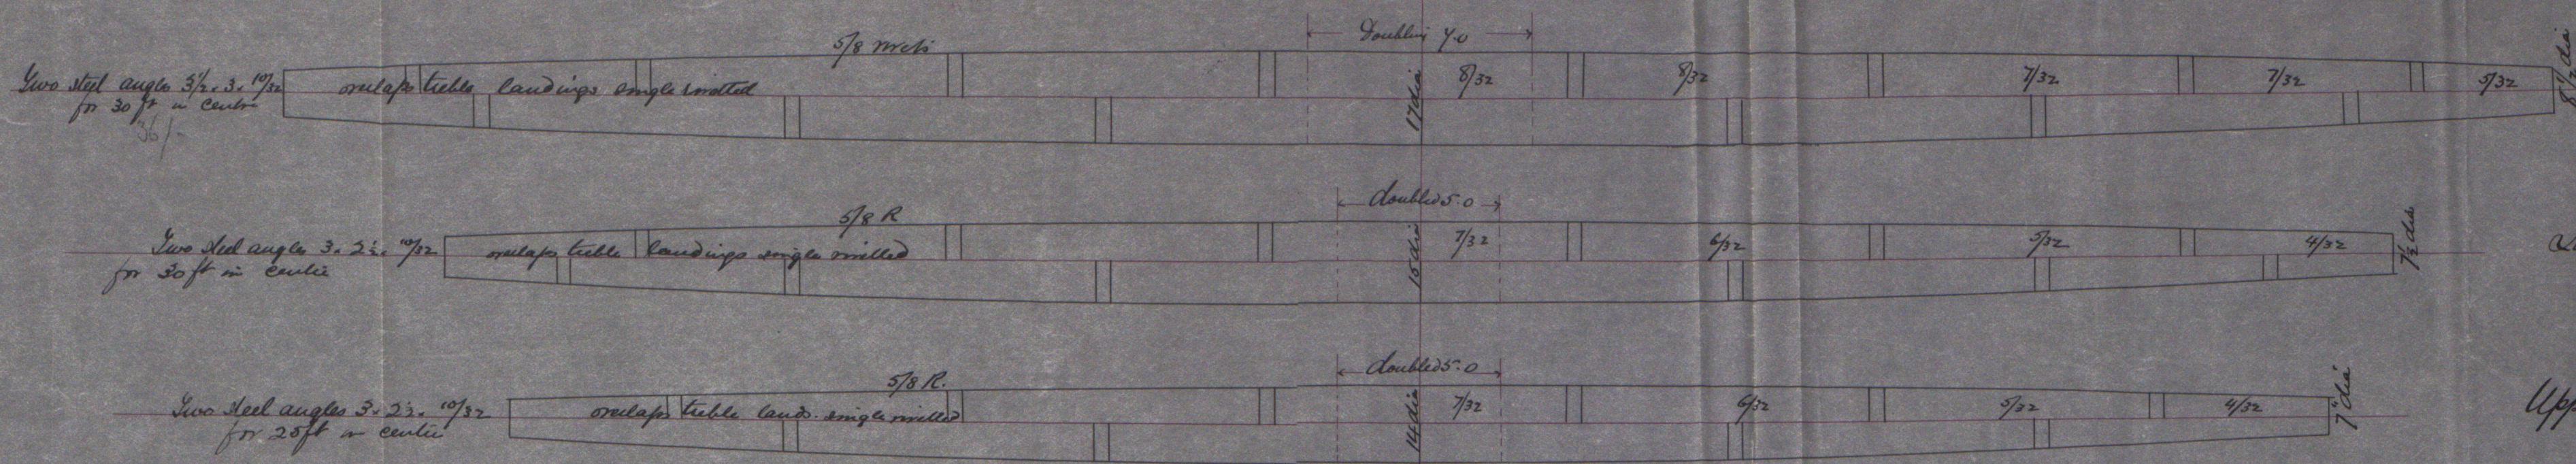

Lower 40' 0"
 Lower topmast 40' 60' 0"
 Upper topmast 4' 56' 0"












JOHN REID

Ship Builder

PORT GLASGOW

11th March 81








up heads

Boards



© 2019

Lloyd's Register
Foundation