

4-1-87

Midship Section.

S S No 15

Scale 1/2 - 1 foot.

Length 144 ft

Breadth 22 "

Depth hold 9' 6"

Class 100 A1

S. S. "John Burbery" of Cardiff
Report of Survey Greenock 8066.

1/2 Girth 19' 0"

1/2 Breadth 11' 0"

Depth 10' 5"

40' 5" Frame No

14' 4"

16' 2' 0"

16' 2' 0"

40' 5"

5' 8' 3' 2' 0"

5' 5' 3' 2'

6' 4' 1' 5' 2'


Plating No

Equipment

Proportions.

6.5 Breadth.

13.7 Depth.

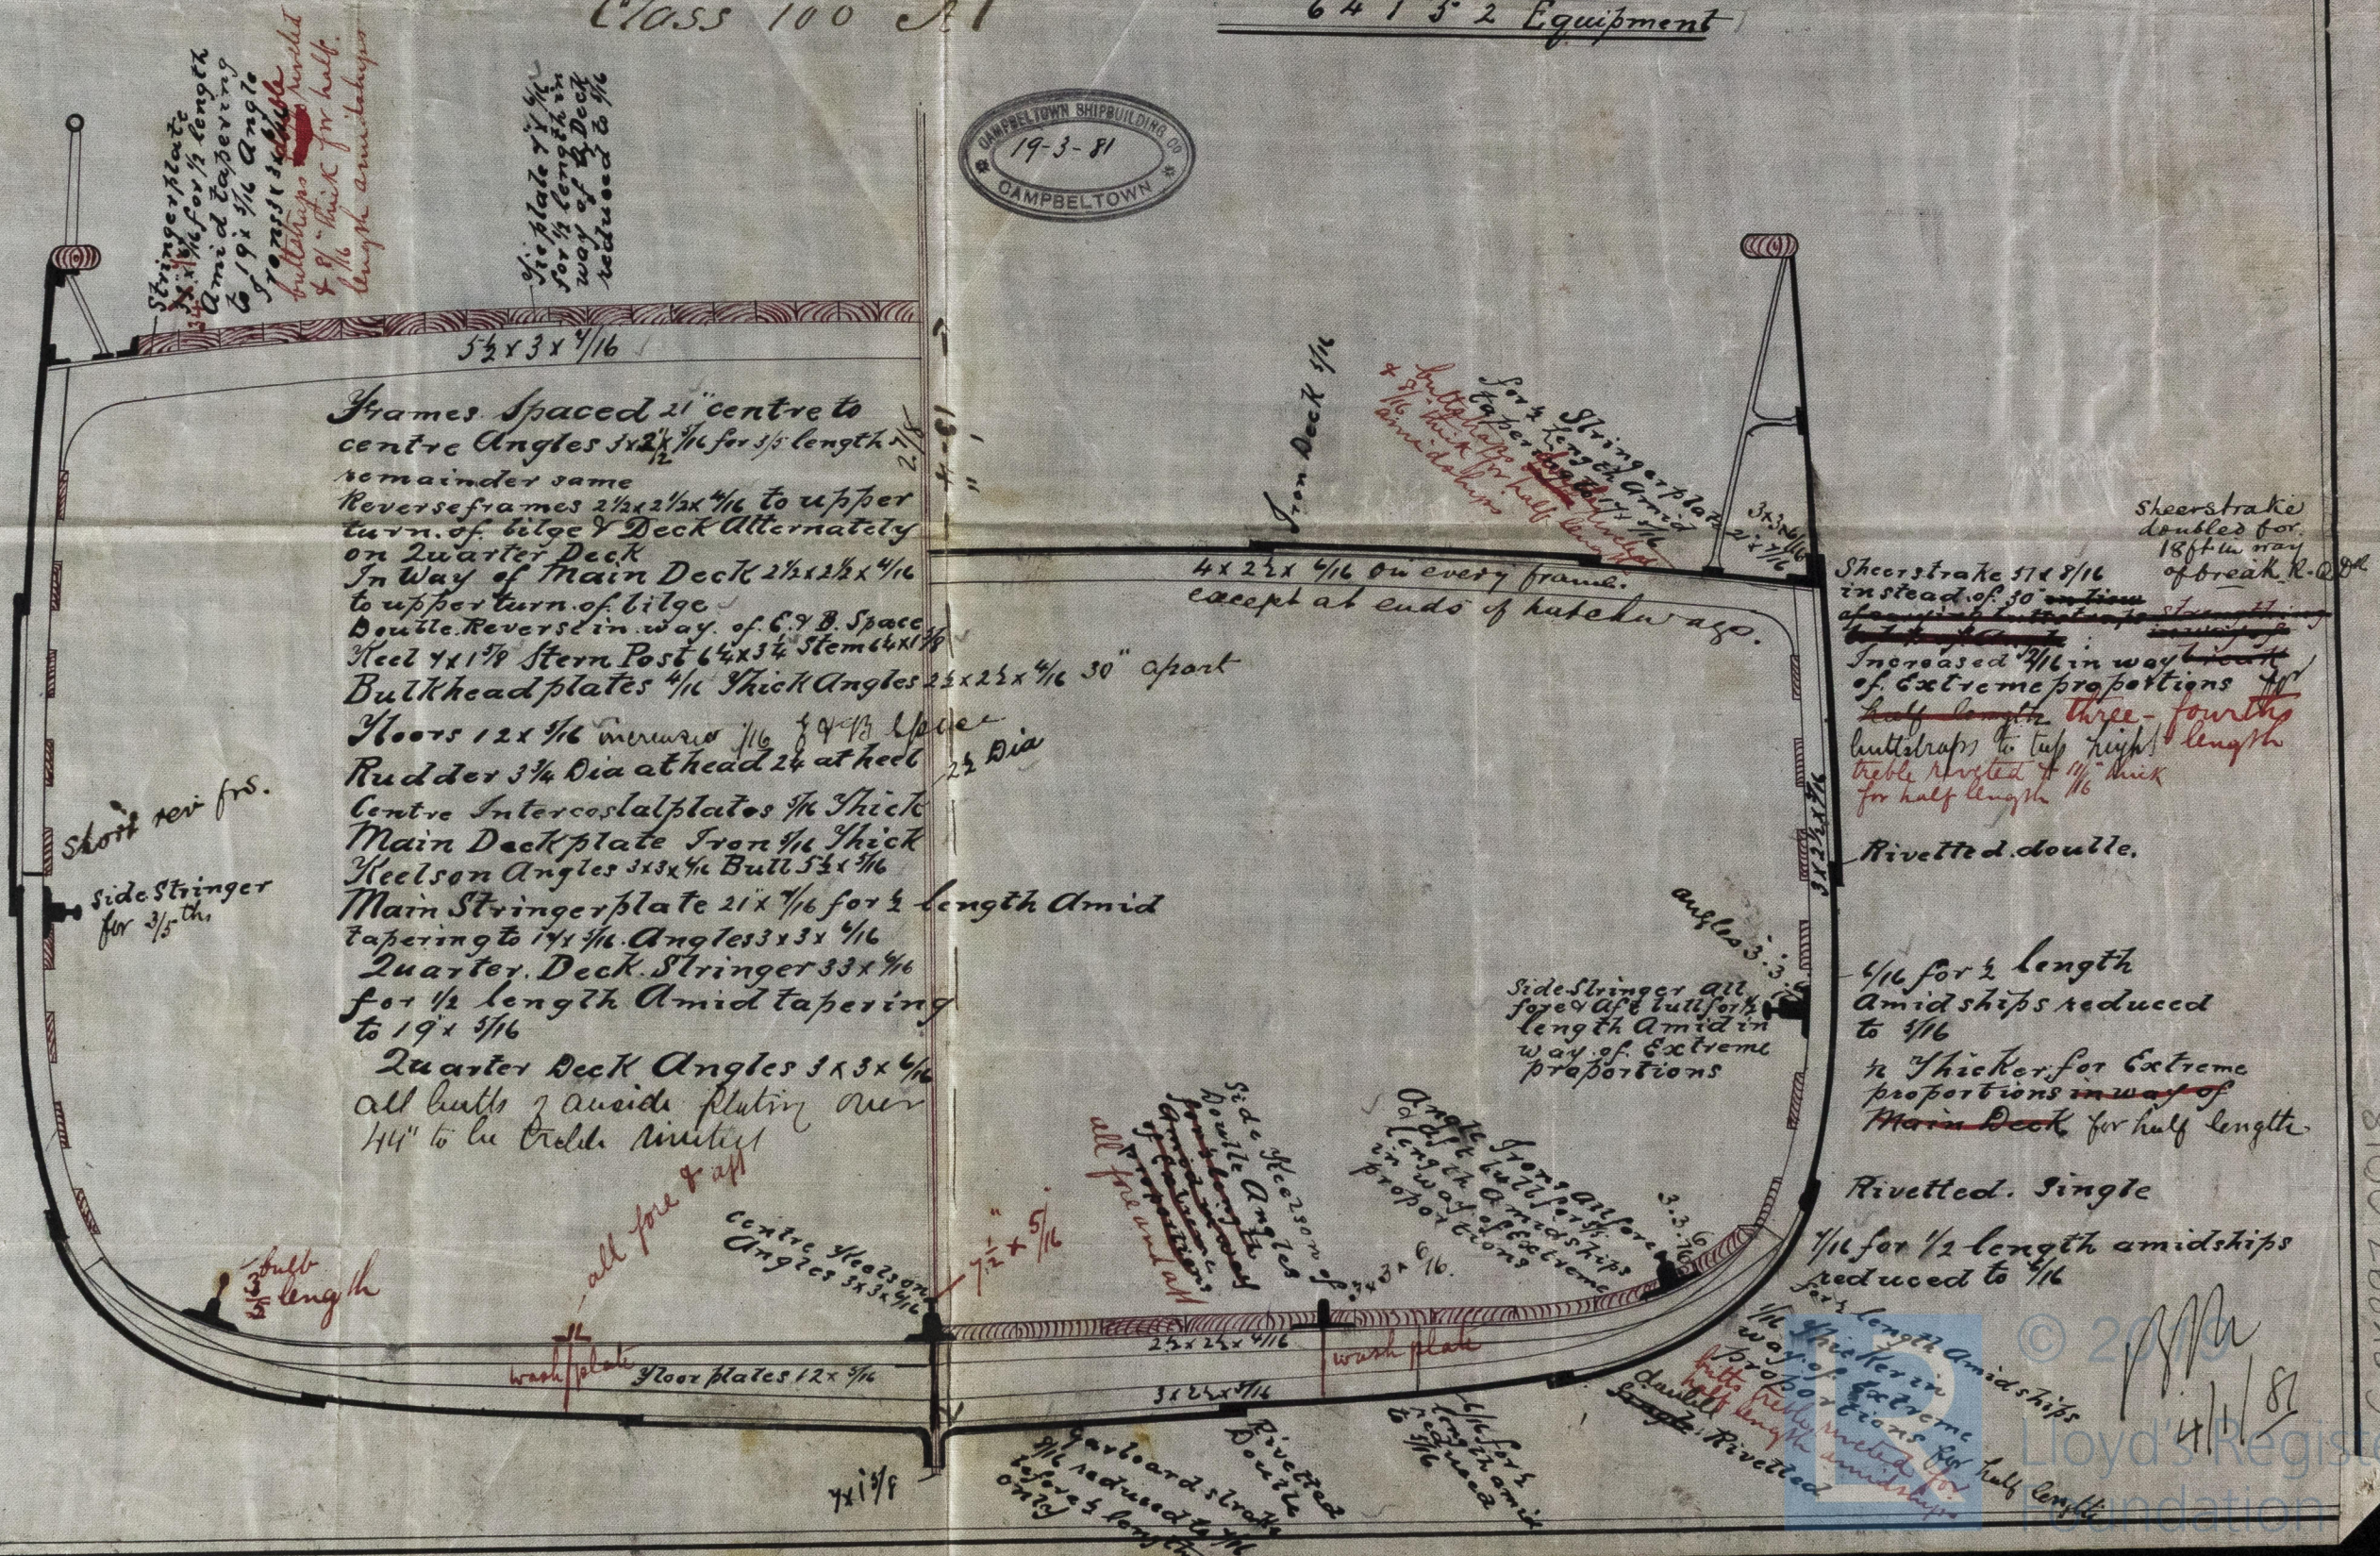

GRK297-0018