



4-1-81

Elevation Plan
S. S. No 15
Scale 1/4
Foot

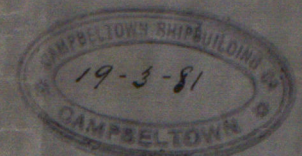

S. S. "John Burberry" of Cardiff
Report of Survey No. 8066.

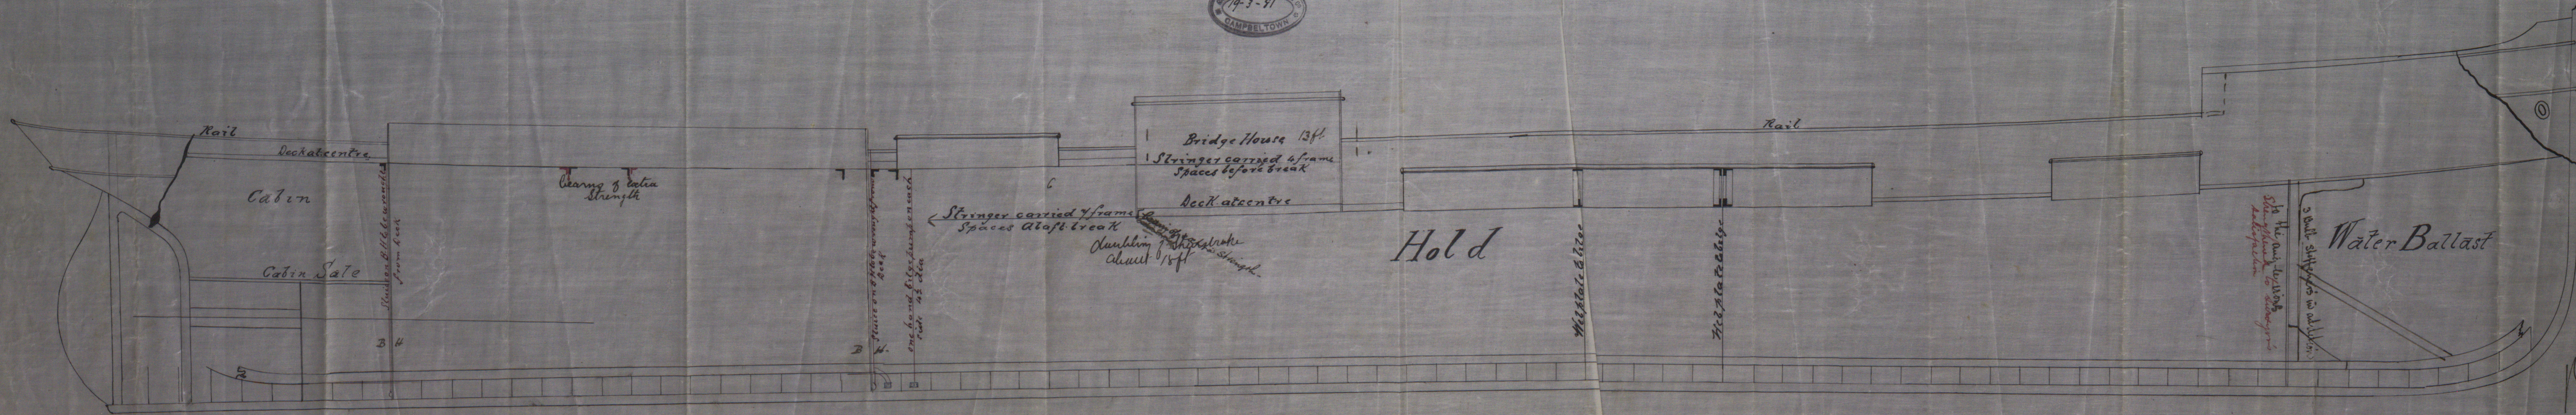

© 2019
Lloyd's Register
Foundation

GRK297-0020


