


hm
27/8/81

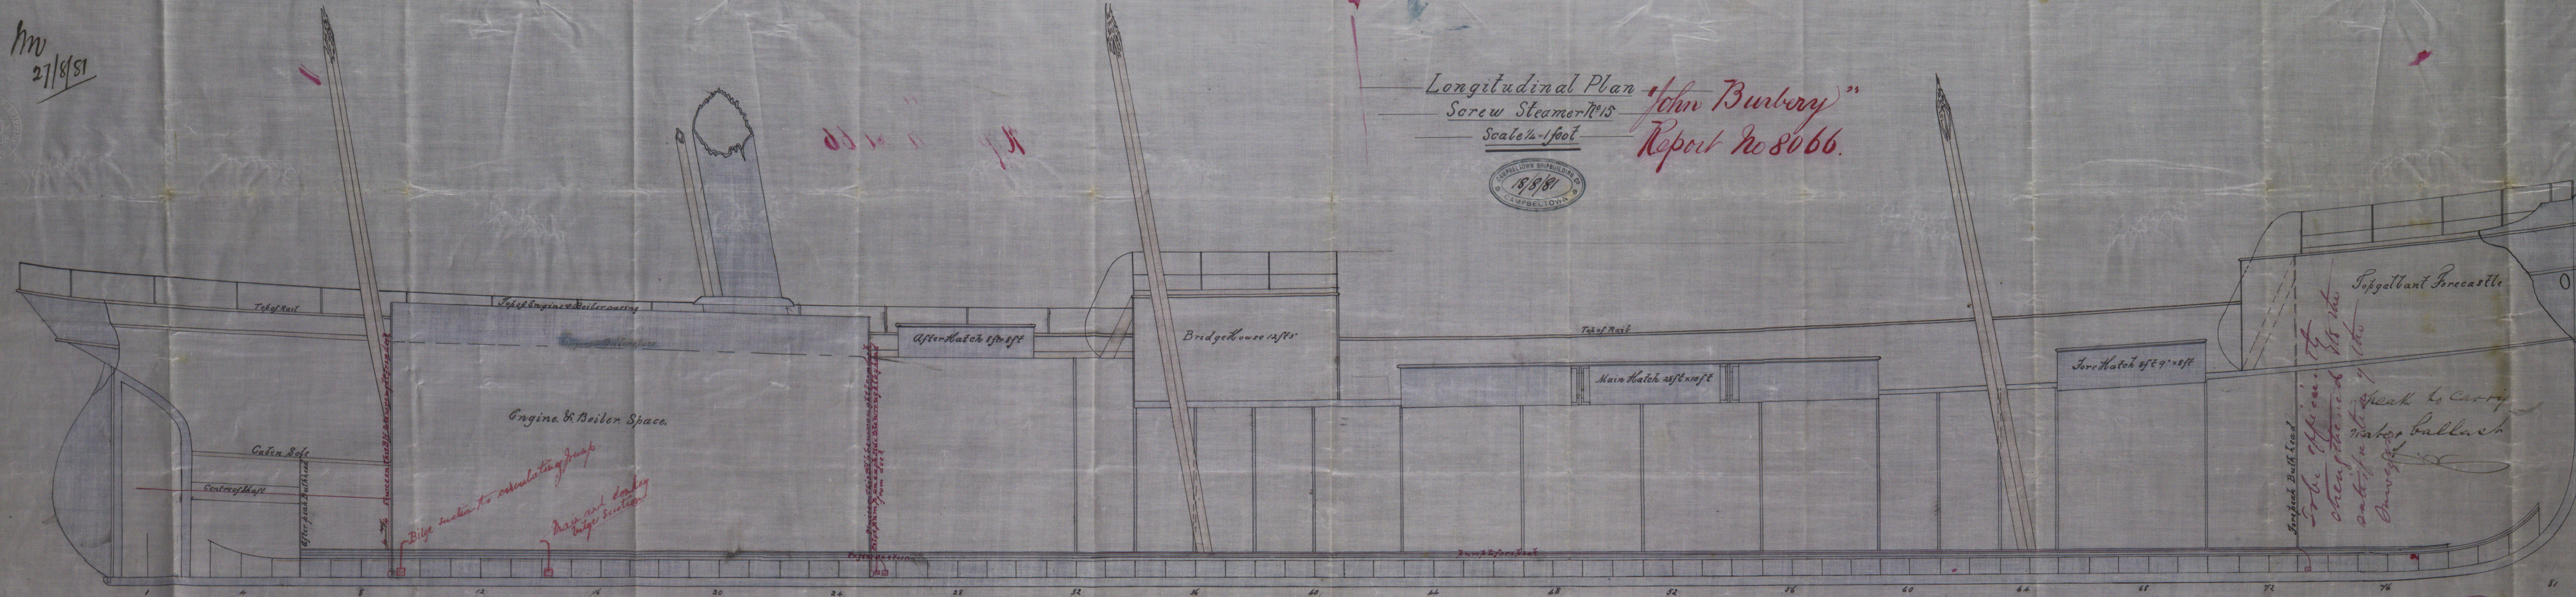






© 2019



Lloyd's Register
Foundation

GRK297-0021