

23.12.80


Iron Ship "Ben Luram" of Glasgow Quenock Report No. 8064

Half midship section Ship No. 105

To class "100 A. 1" S. 1880

Dimensions

Length, as per rule	268.0
Breadth, moulded	40.0
Depth amidships from top of keel	26.0
Half girth	40.1
Dist. num.	96.1
Second do.	230.4
Equip do.	246.13
Depth in length	10.3
Breadth	6.4

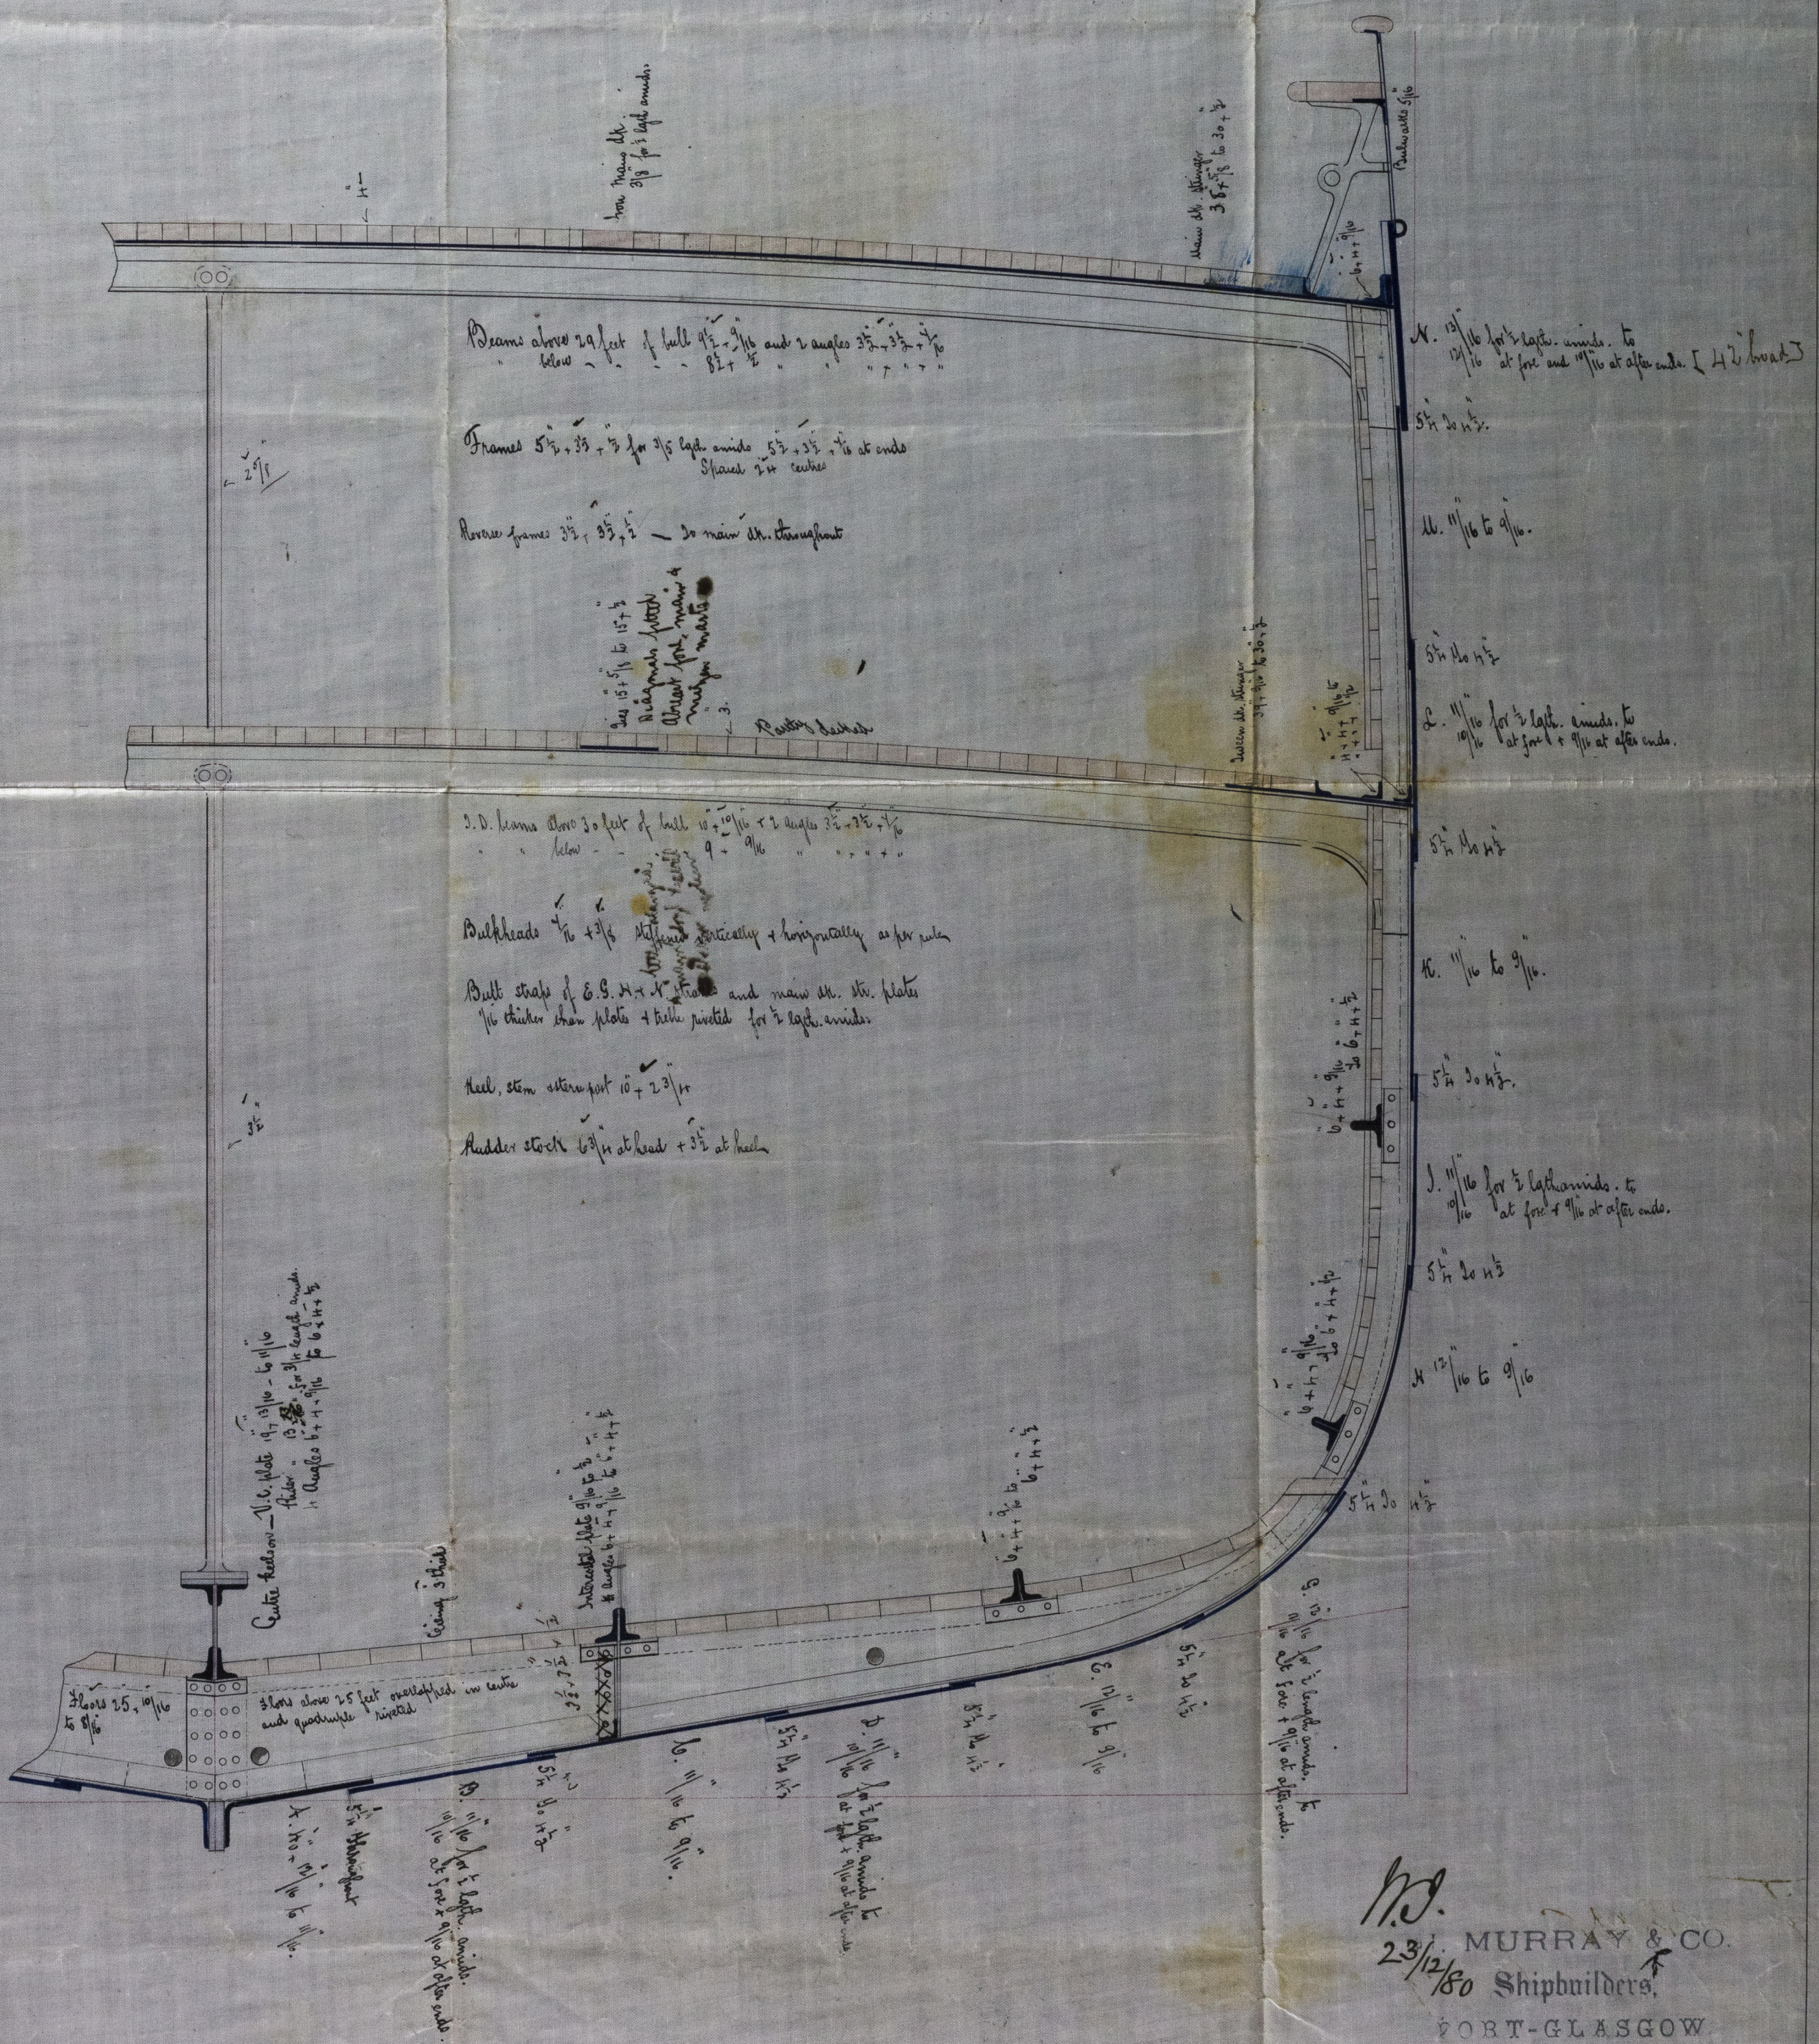

MURRAY & CO.
 23/12/80 Shipbuilders,
 FORT-GLASGOW
 DEC. 15th 1880.


1847
1848
25

GRK297-0028