



26.11.80

MIDSHIP SECTION OF S. S. N^o 164.

TO CLASS 100 A1 AT LLOYDS, 3 DECK RULE.



DIMENSIONS BY LLOYDS 273.5 x 57.0 x 26.0

SCALE 1/2 INCH = 1 FOOT.

18/11/80.

Bridge Deck 68 feet long

S. S. Lamington
Greenock Report
N^o 8040

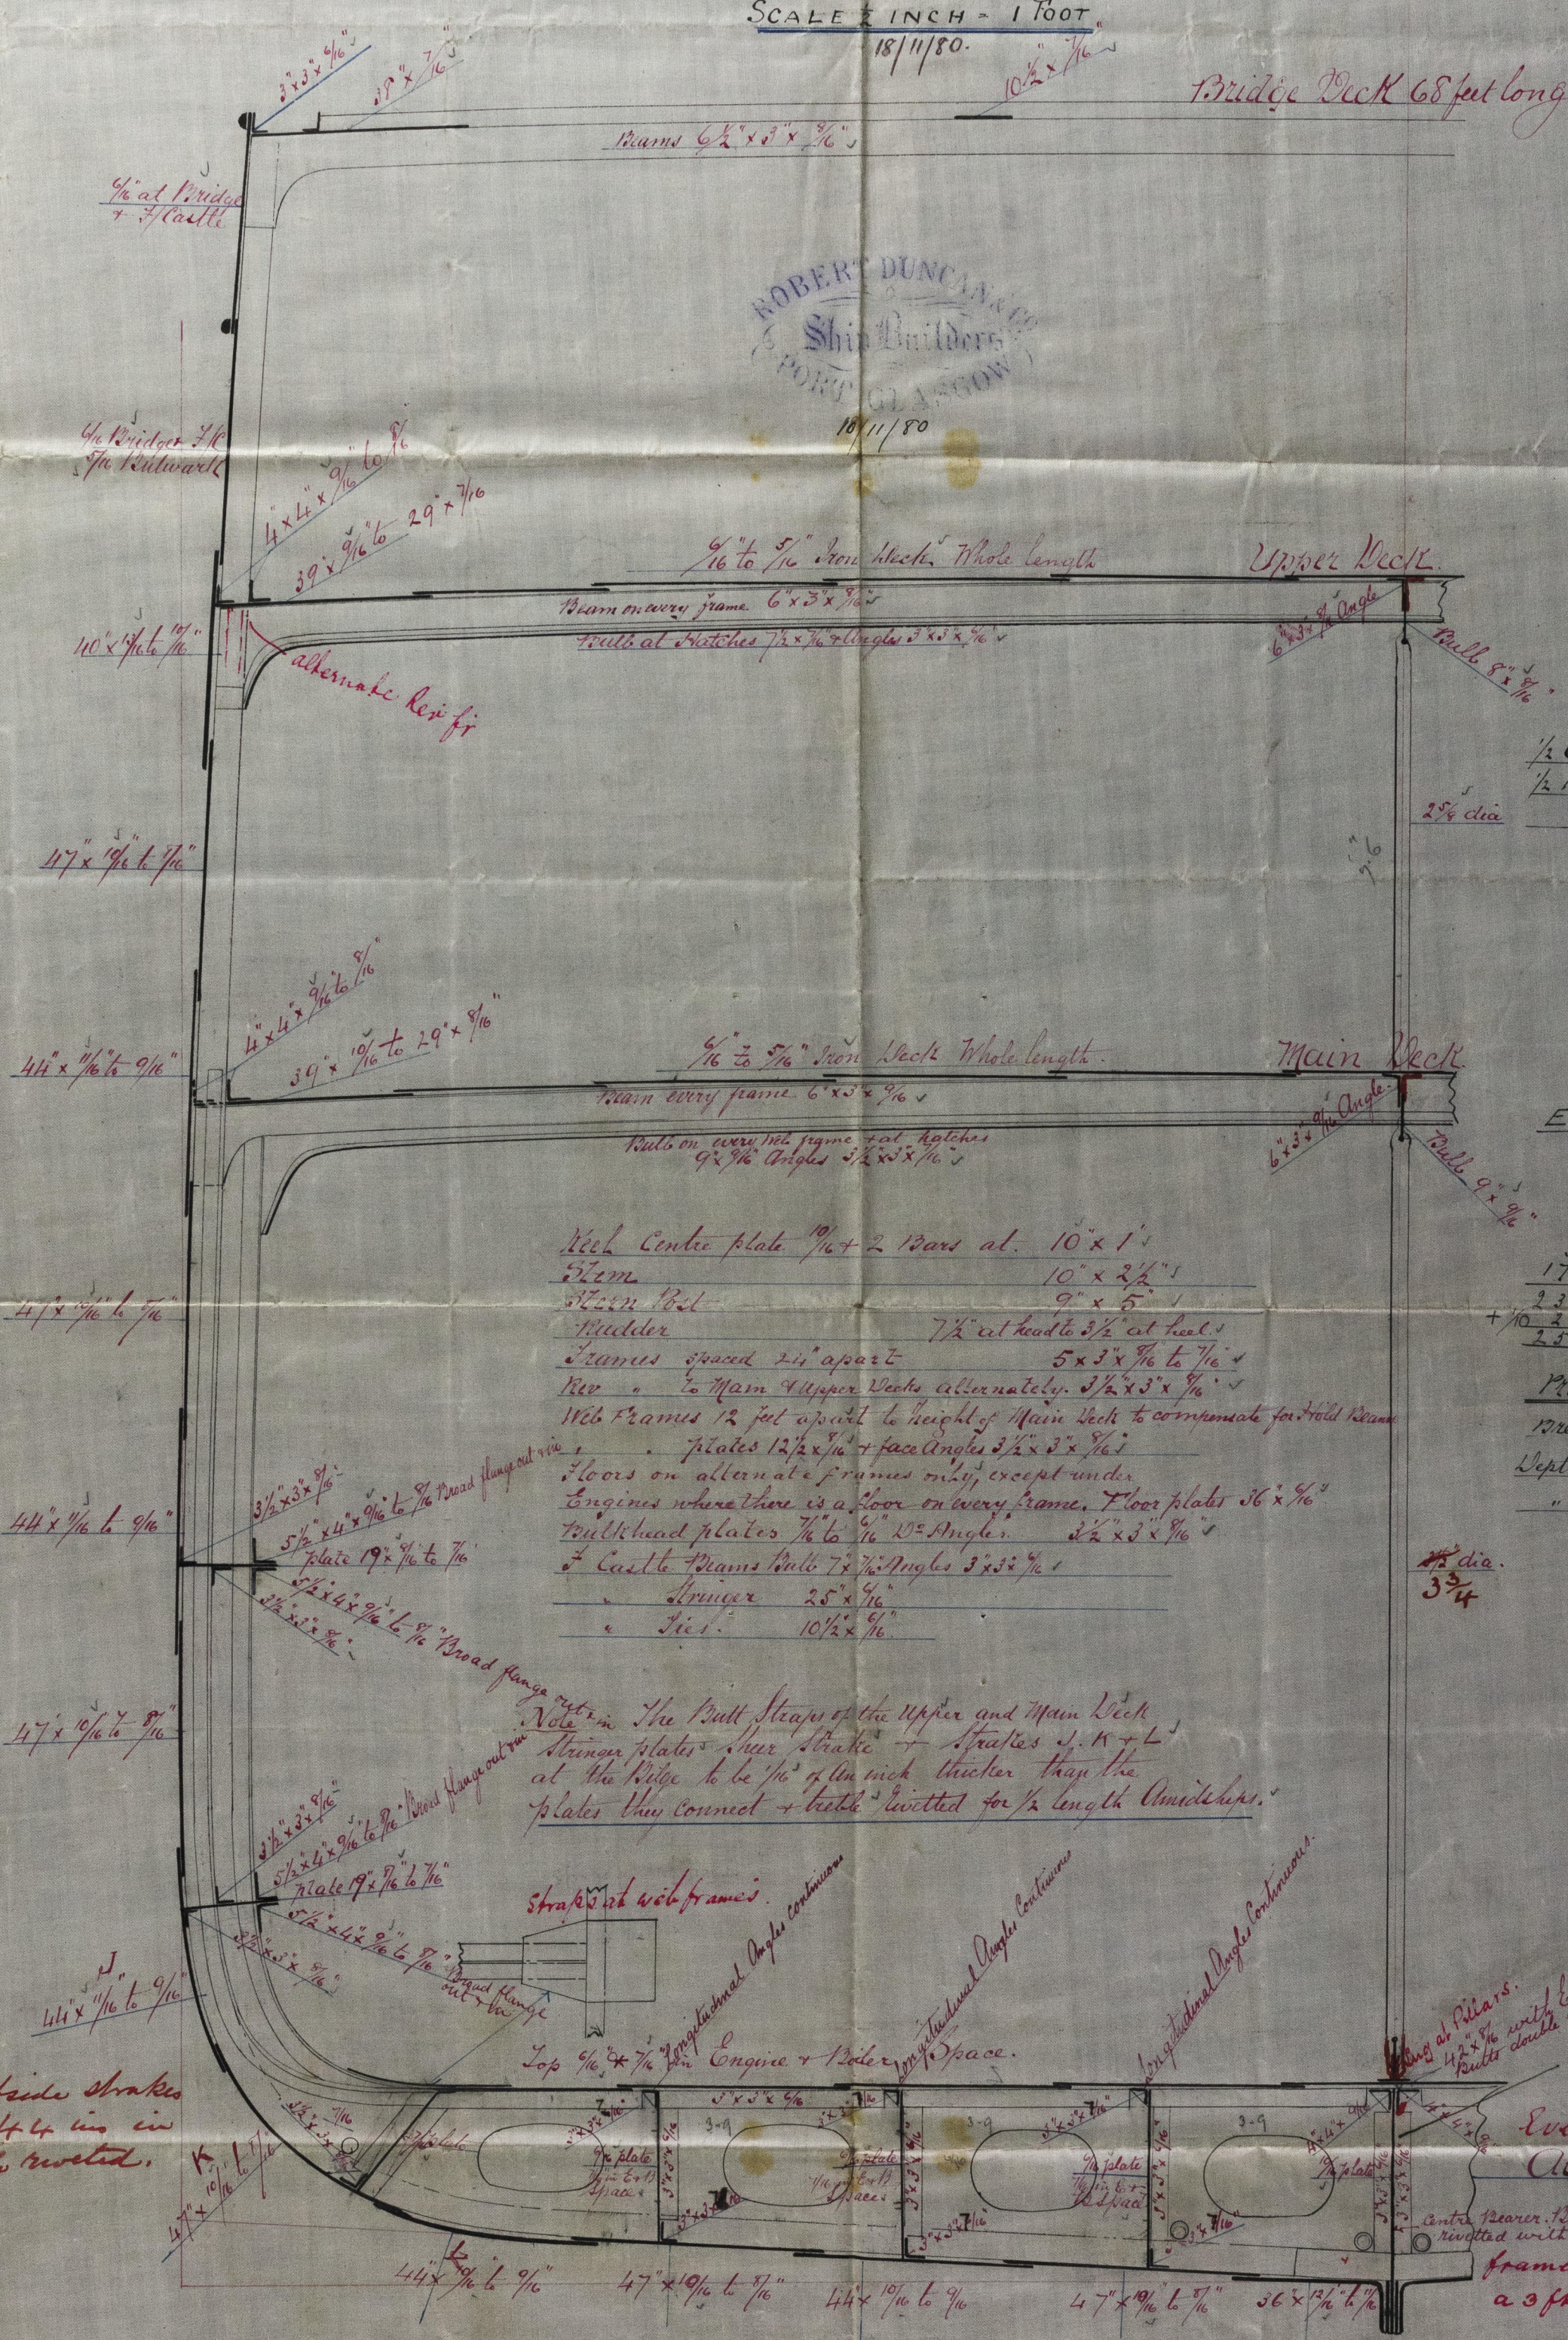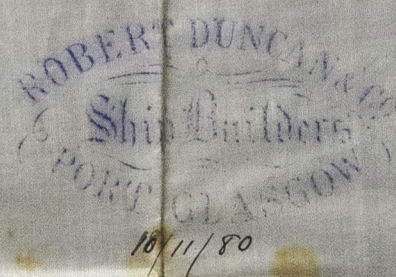

NUMERALS

1/2 Girth	41.00
1/2 Breadth	18.50
2 1/2 dia	26.00
Depth	85.50
	7.00
	78.50 = N
	273.5
	392.50
	235.50
	549.50
	157.50
	2146 87.50 = N

EQUIPMENT

15.50
x 273.5
4275.0
2565.0
5985.0
17100
23384.250
+ 10 23384.250
25722.67 = E. N

PROPORTIONS

Breadth	7.39
Depth to Upper Deck	10.59
" Main "	16.75

The butts of all outside strakes of plating exceeding 4 ft in breadth to be triple riveted.

Every frame under business and Ultimate Frames before & abaft.

frames carried thro center plate or a 3 ft keel piece to be fitted.



INTERMEDIATE FRAMES

bracket to be fitted if intermediate frames are not carried thro center plate

Side longitudinal Orders Intercostal plates, but top edge angle iron continuous.

