


26.11.80

ROBERT DUNCAN & CO
SHIP BUILDERS
PORT GLASGOW
— 11.80. —


№ 164

SCALE $\frac{1}{8}$ INCH TO A FOOT

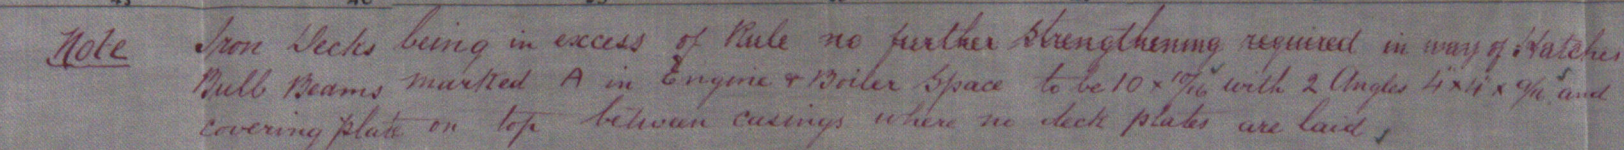

M.S.
25711/80


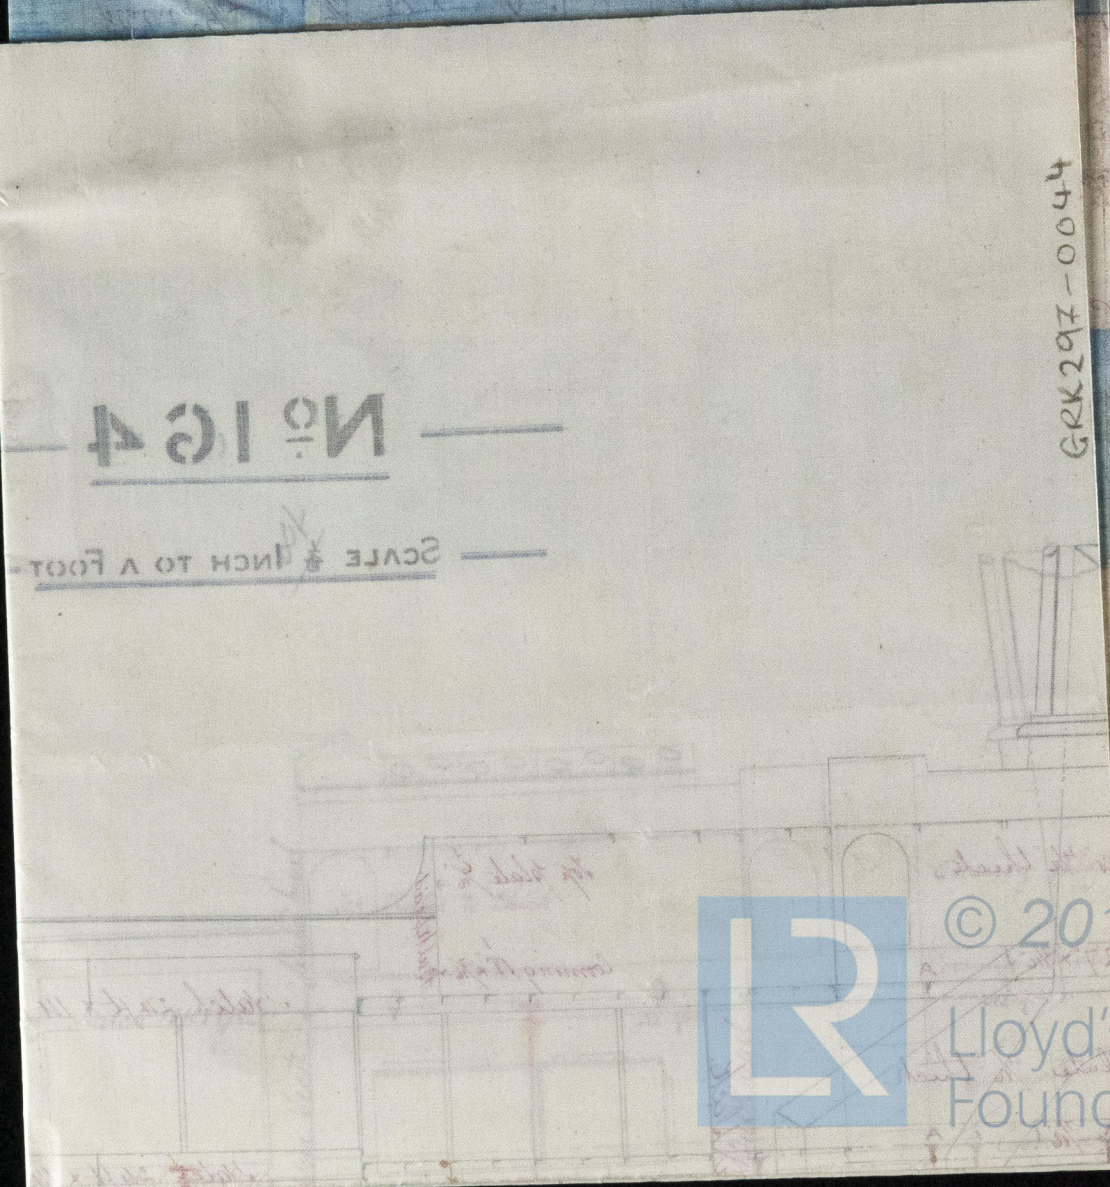

No 164

SCALE 1/4 INCH TO A FOOT

GRK297-0044

11. 80.



© 2019

Lloyd's Register
Foundation