

S. S. No 164.





Arrangement of C<sup>r</sup> Deck Girder &  
Hold Stanchions for Grain Boards

Scale 1 inch = One Foot.

S. S. "Lamington"  
of Glasgow  
Greenock Report  
No 8040

Fore and aft elevation.

Transverse elevation.

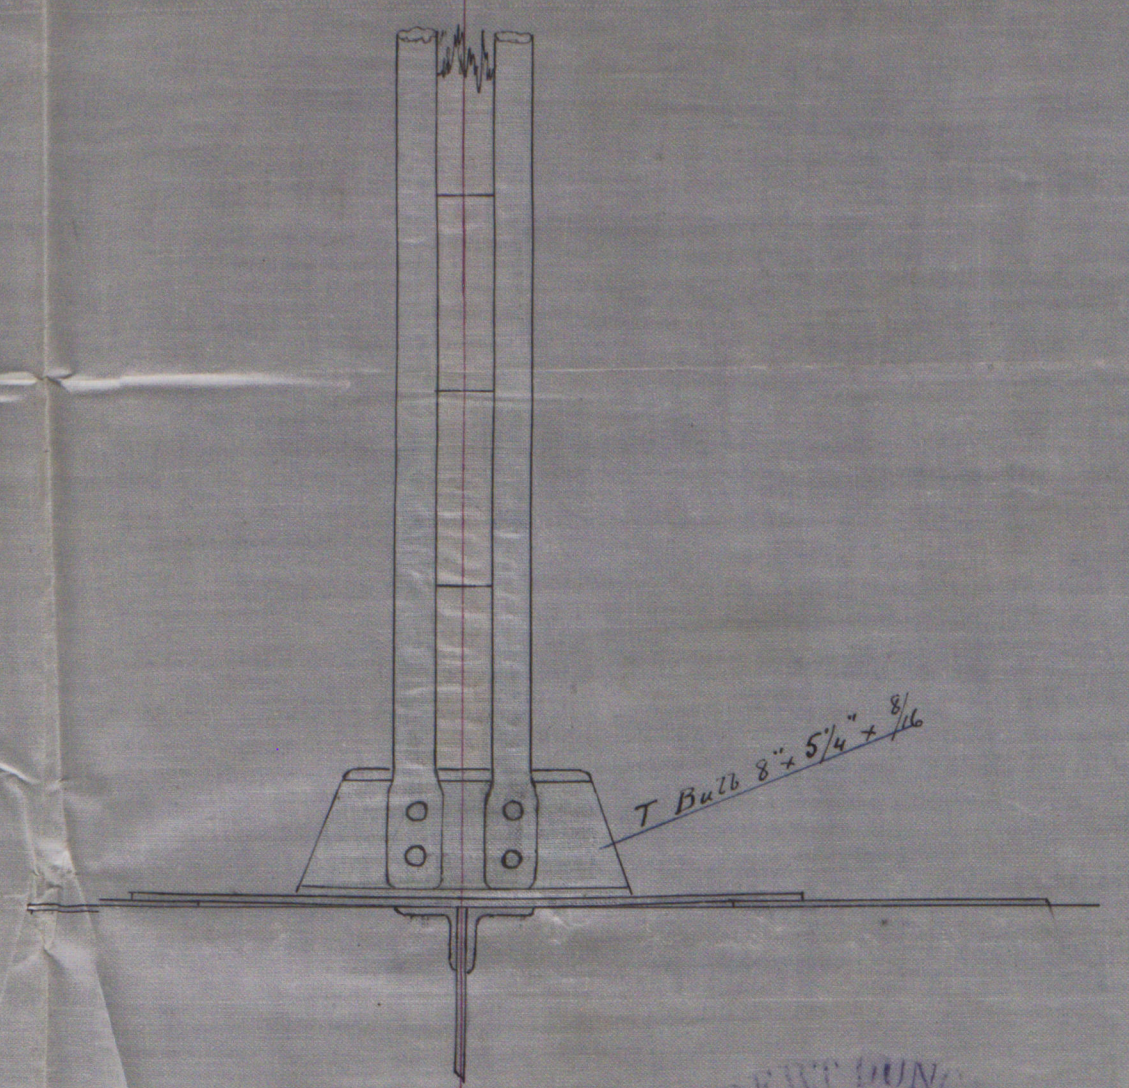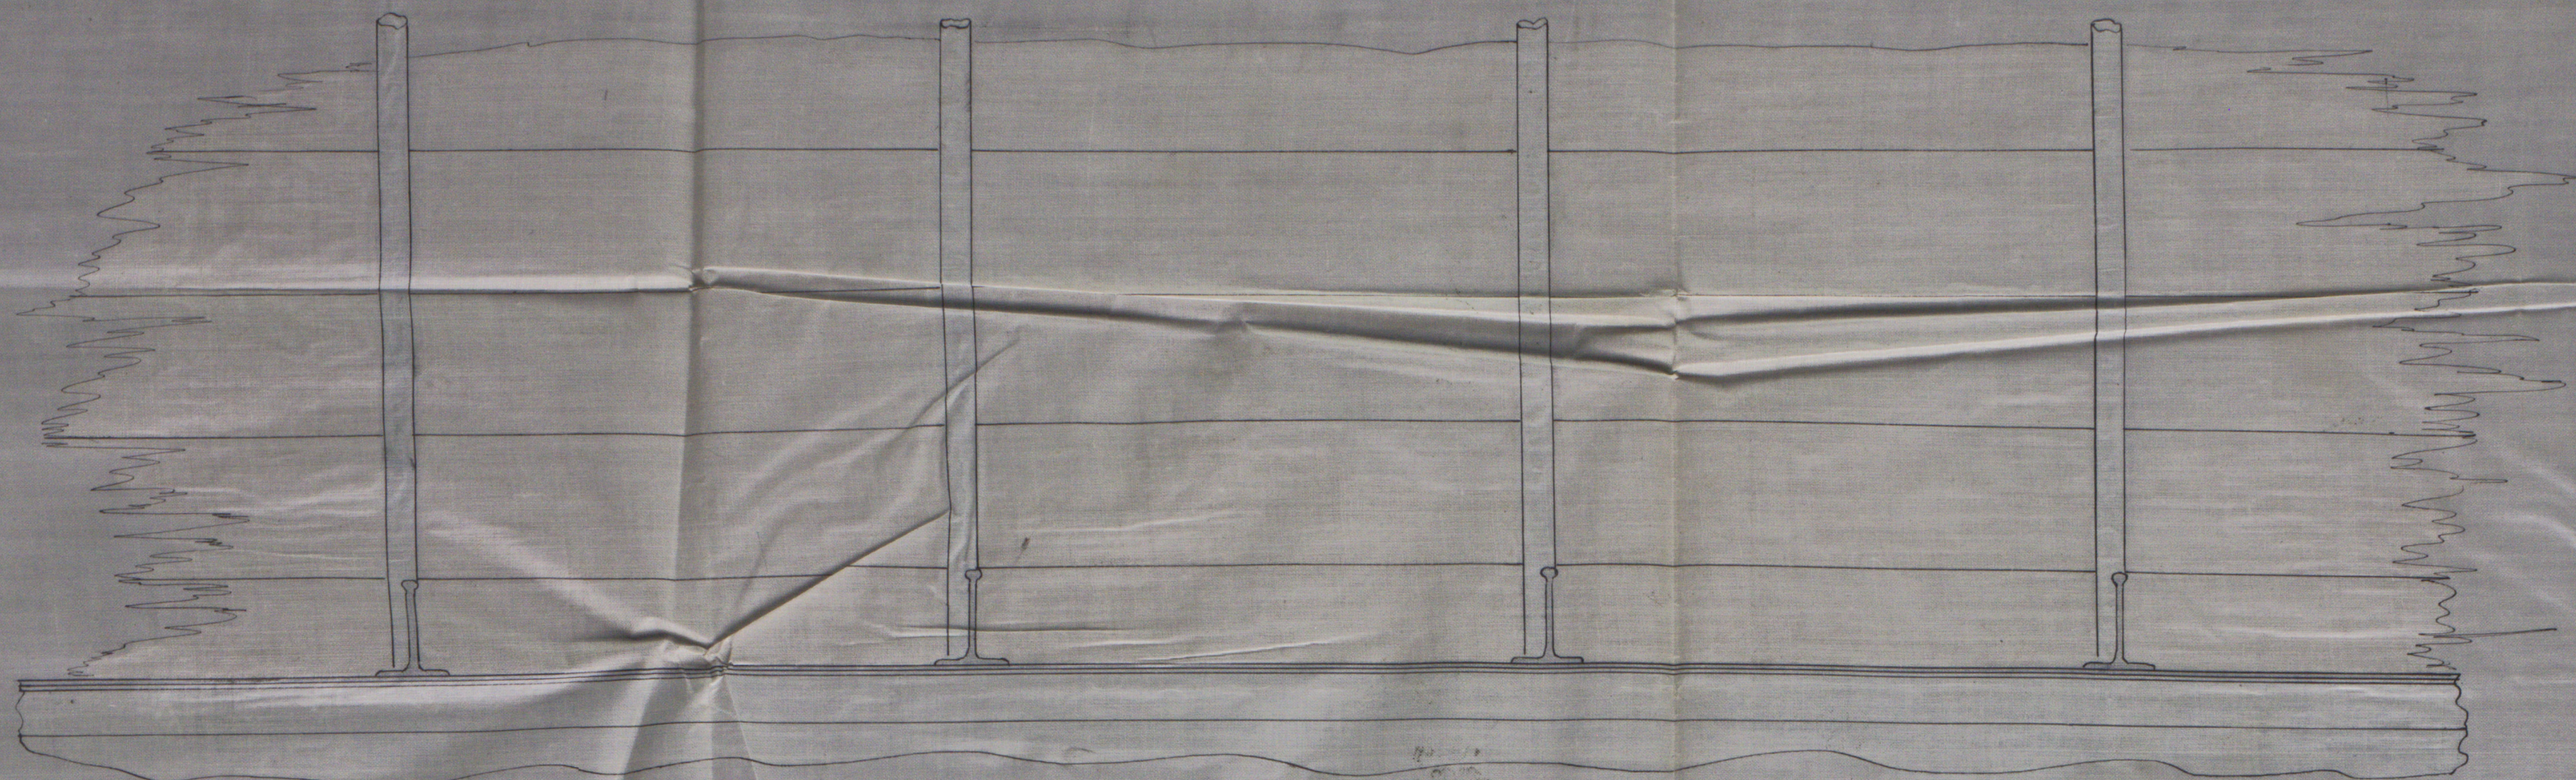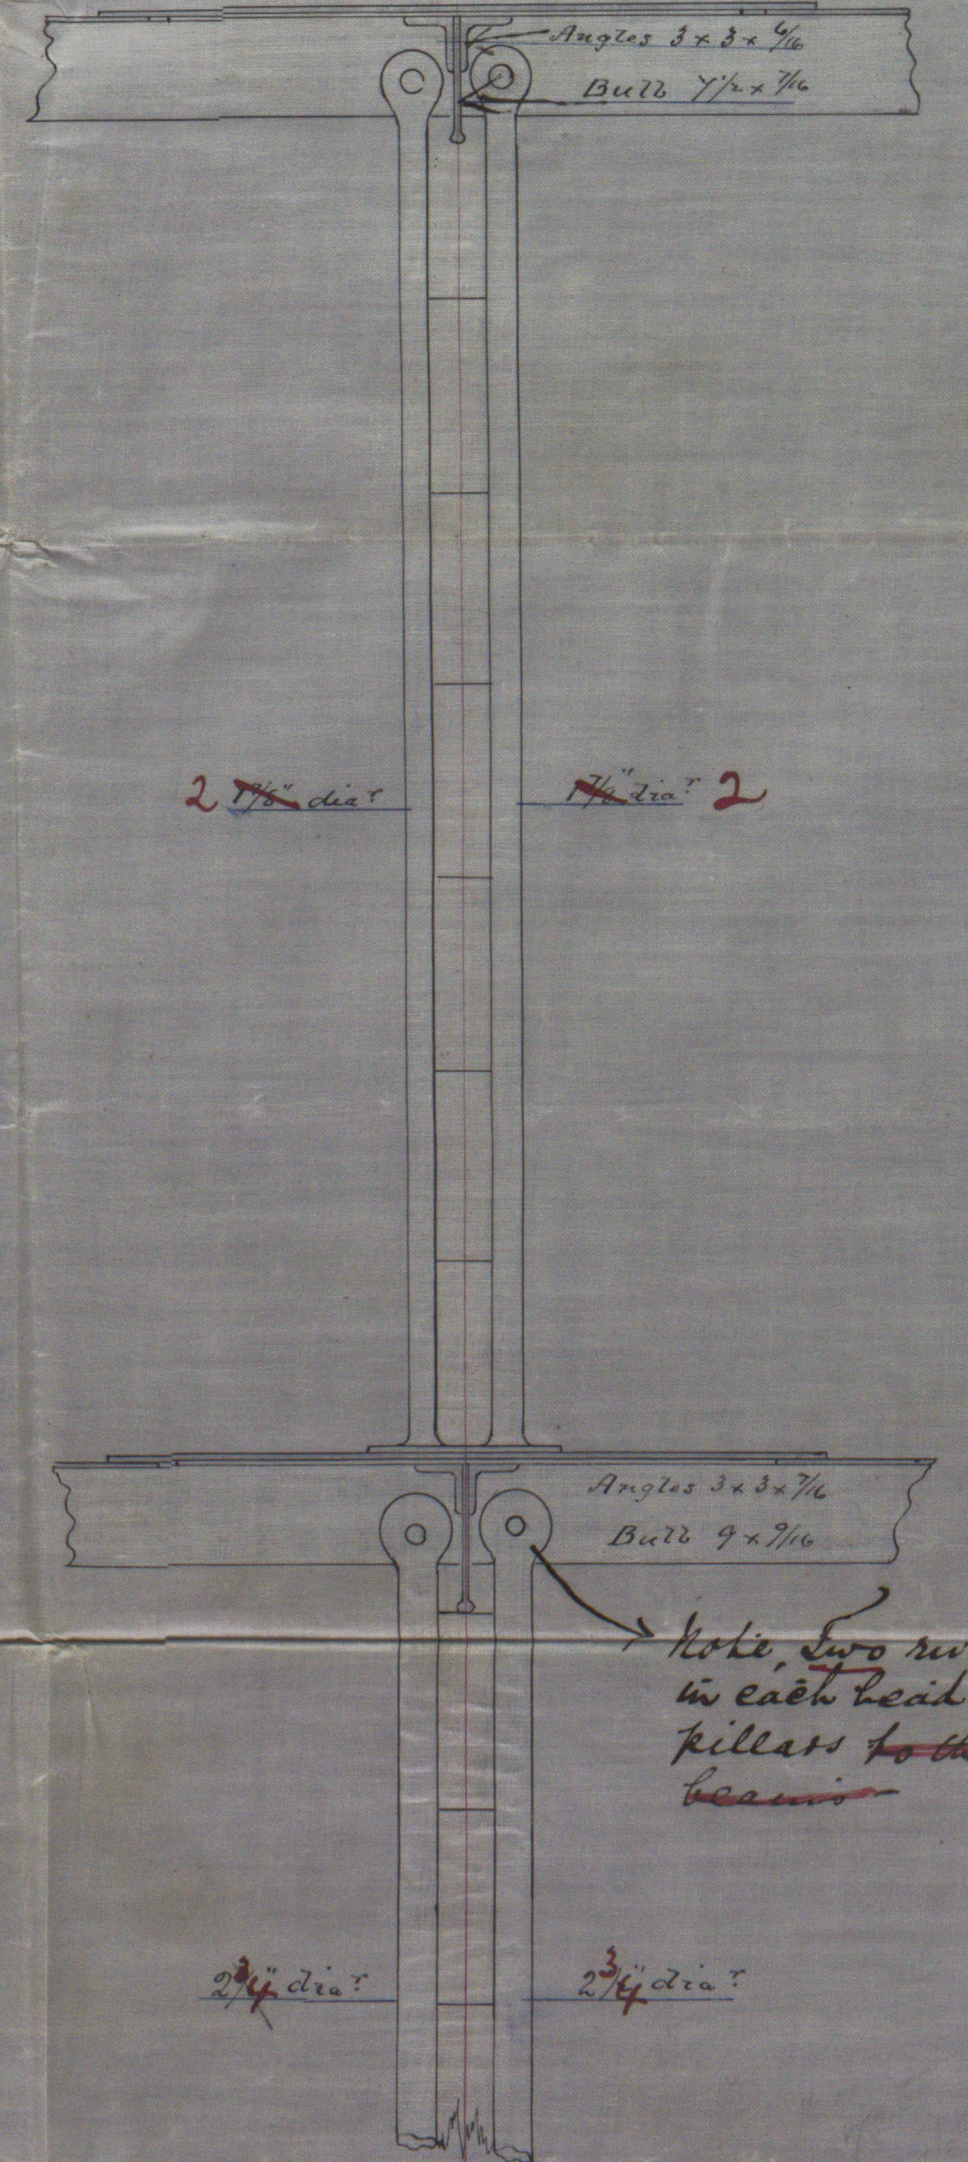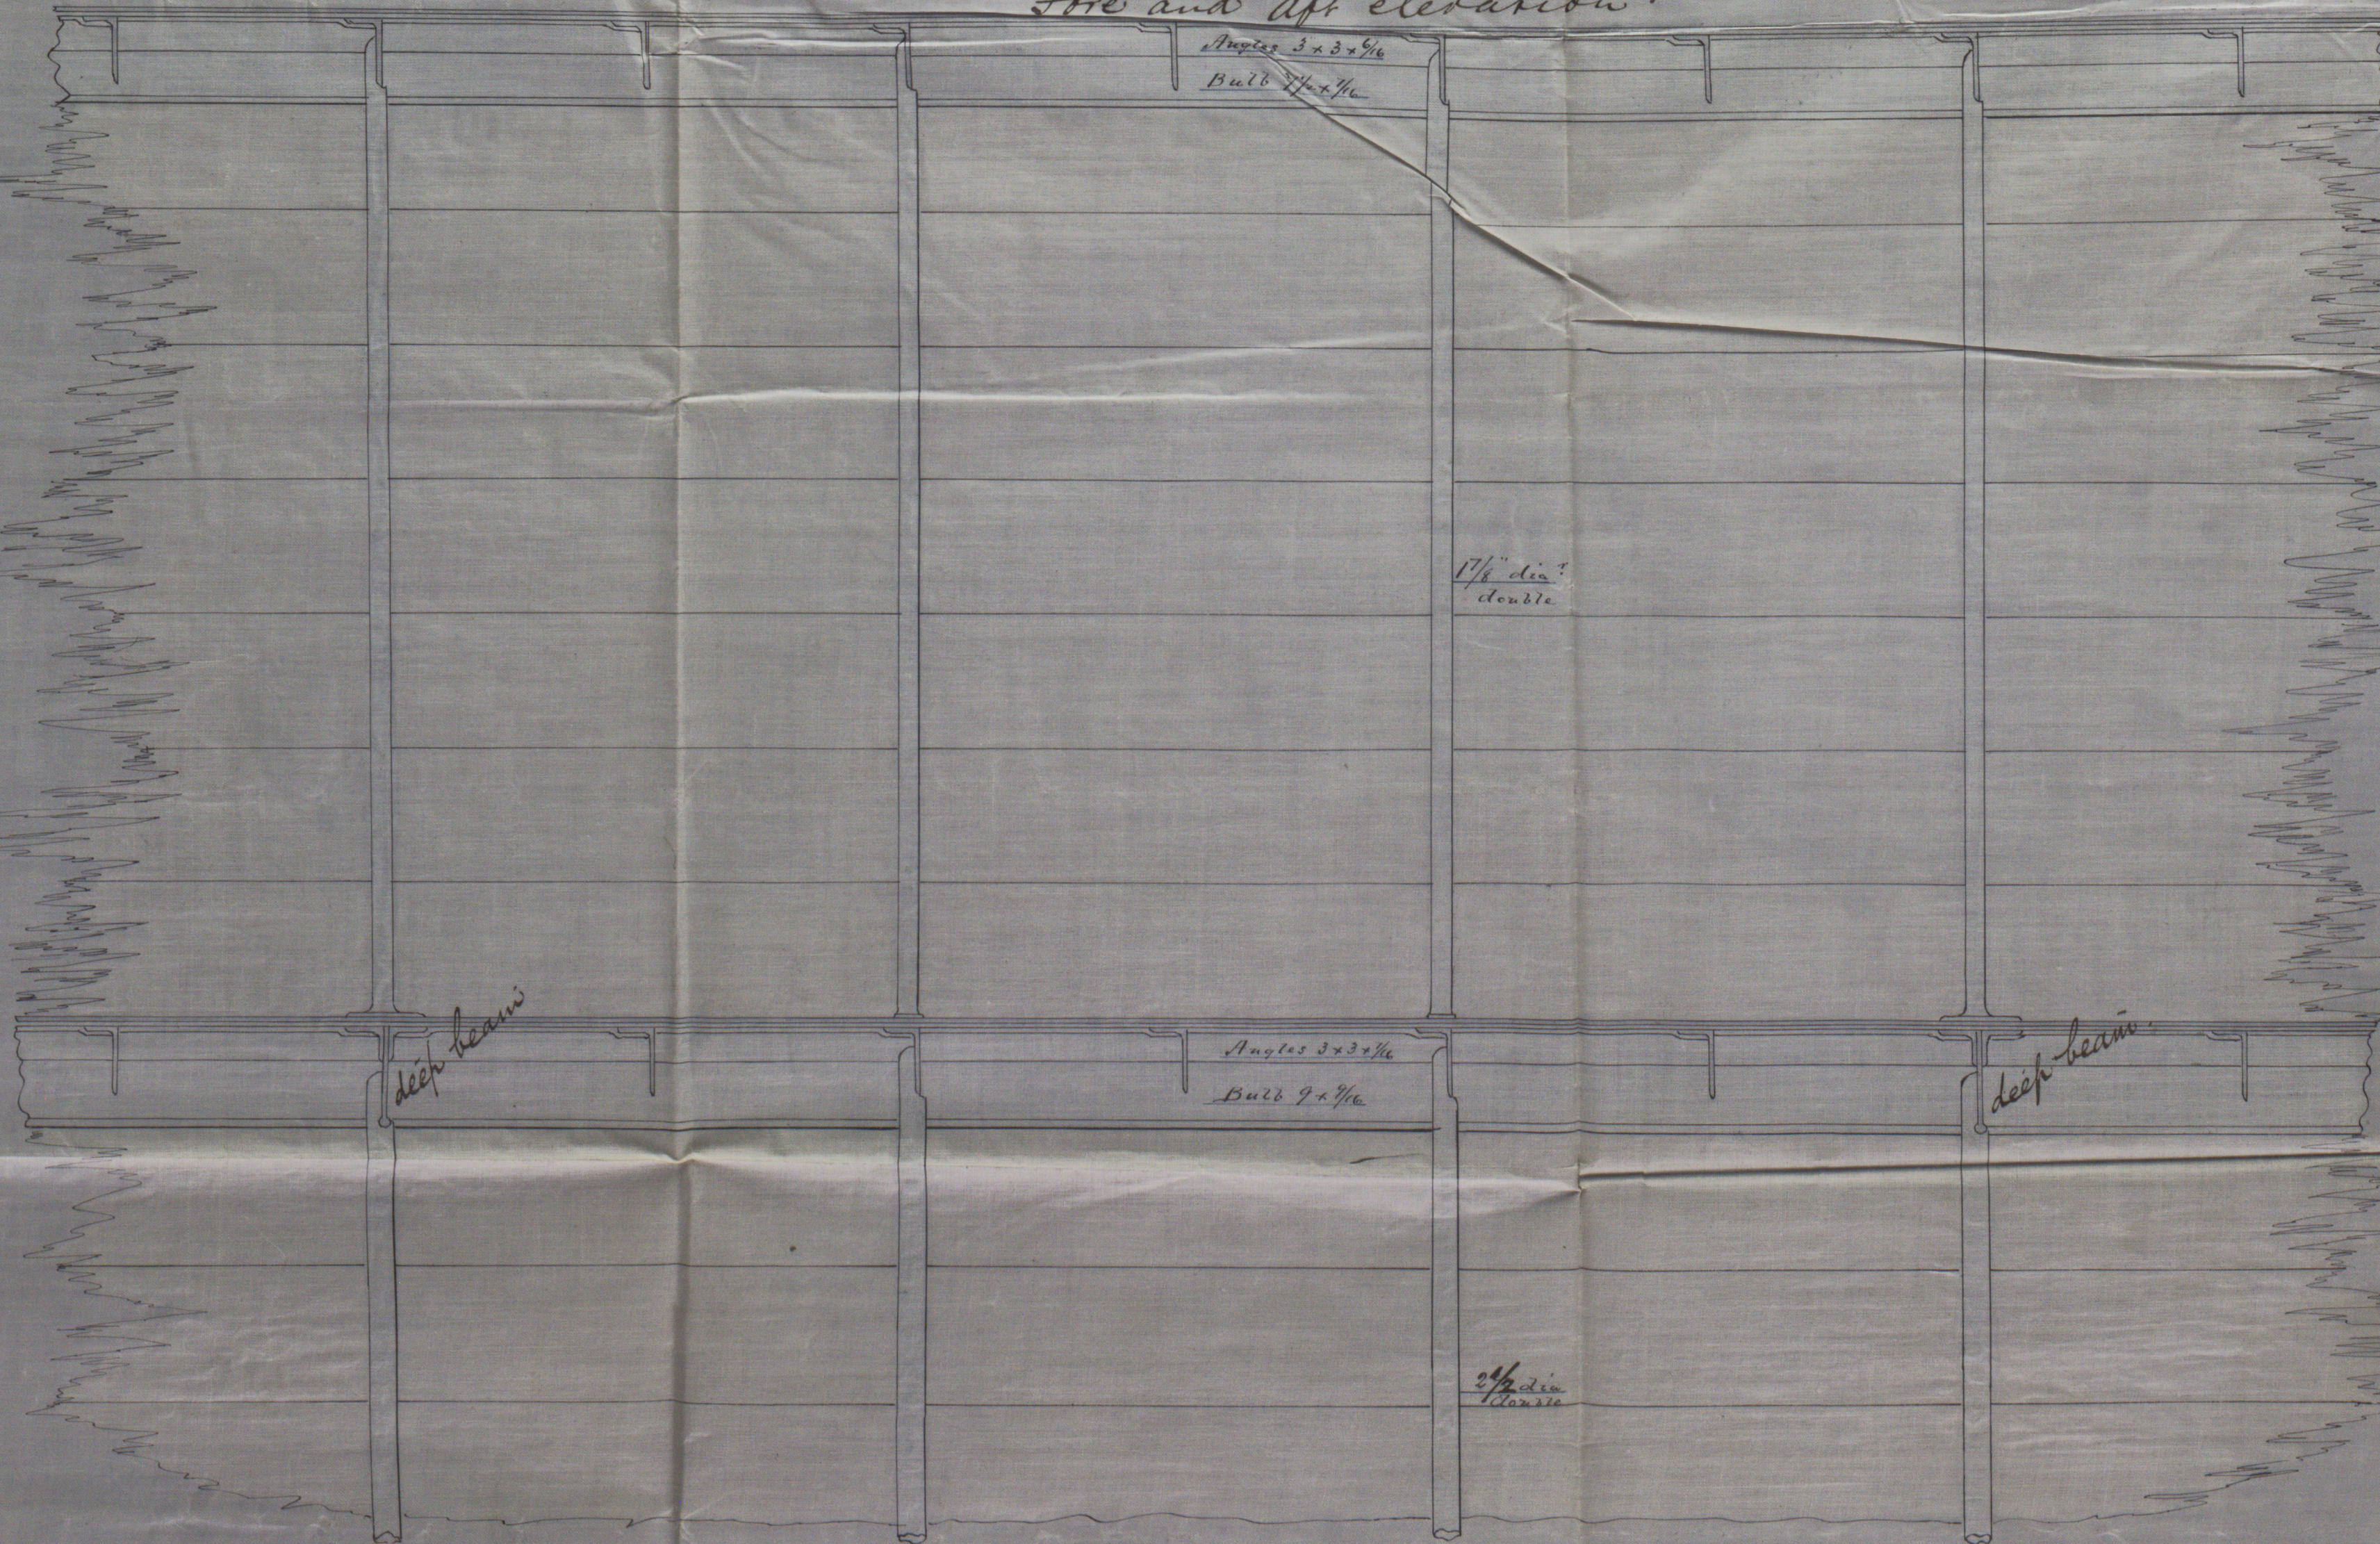

rm  
14/12/80

ROBERT DUNCANSON  
Ship Builders  
PORT GLASGOW  
6.12.80  
© 2019  
Foundation










GRK297-0045



© 2019

Lloyd's Register Foundation